

Page Project No. 320026.05 ADDENDUM 02 10 APRIL 2025



TTUHSC Preston Smith Library Renovation - Level 01 / 02

3601 4th Street, STOP 7781
Lubbock, TX 79430-7781

Page/


Page Southerland Page, Inc.
1800 Main Street Suite 123
Dallas, TX 75201
pagethink.com

TEL 214 522 3900
FAX 214 522 4380

ARCHITECTURE / ENGINEERING / INTERIORS / PLANNING / CONSULTING
Austin / Dallas / Denver / Dubai / Houston / Mexico City / Phoenix /
San Francisco / Washington DC / International Affiliate Offices


MECHANICAL ENGINEER
FANNING FANNING & ASSOCIATES INC.
2555 74th St.
Lubbock, TX 79423
806-745-2533



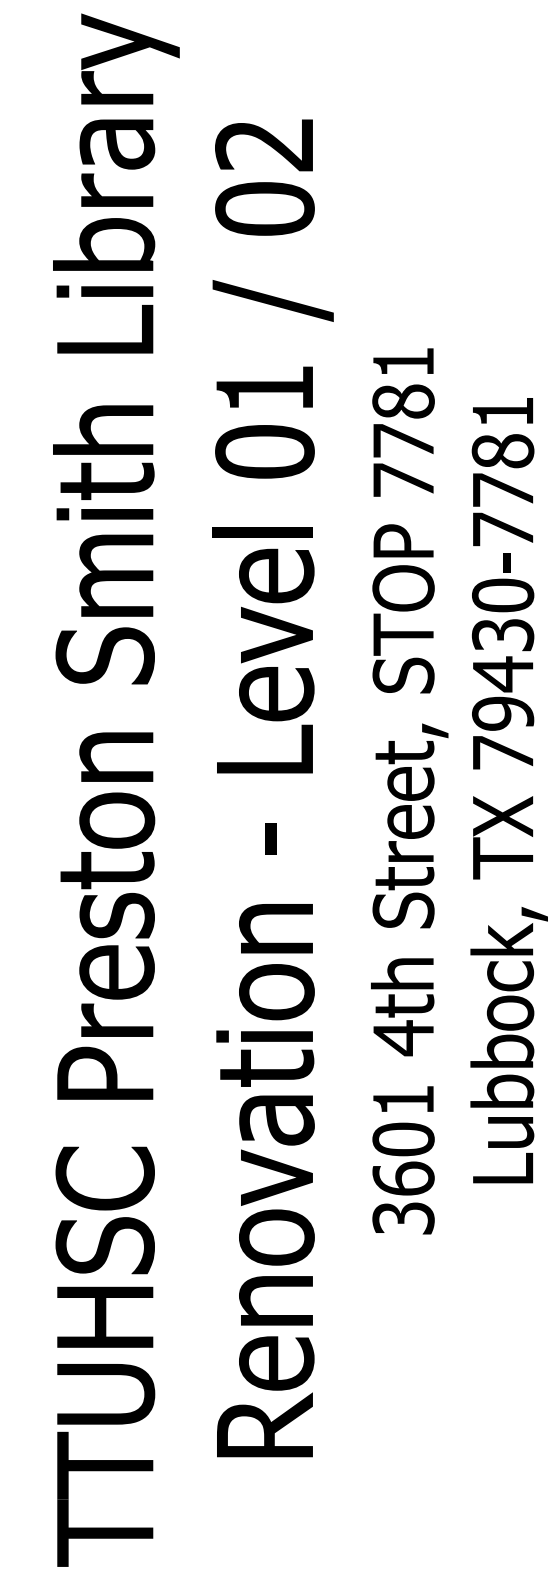

GL-101
SHEET NUMBER



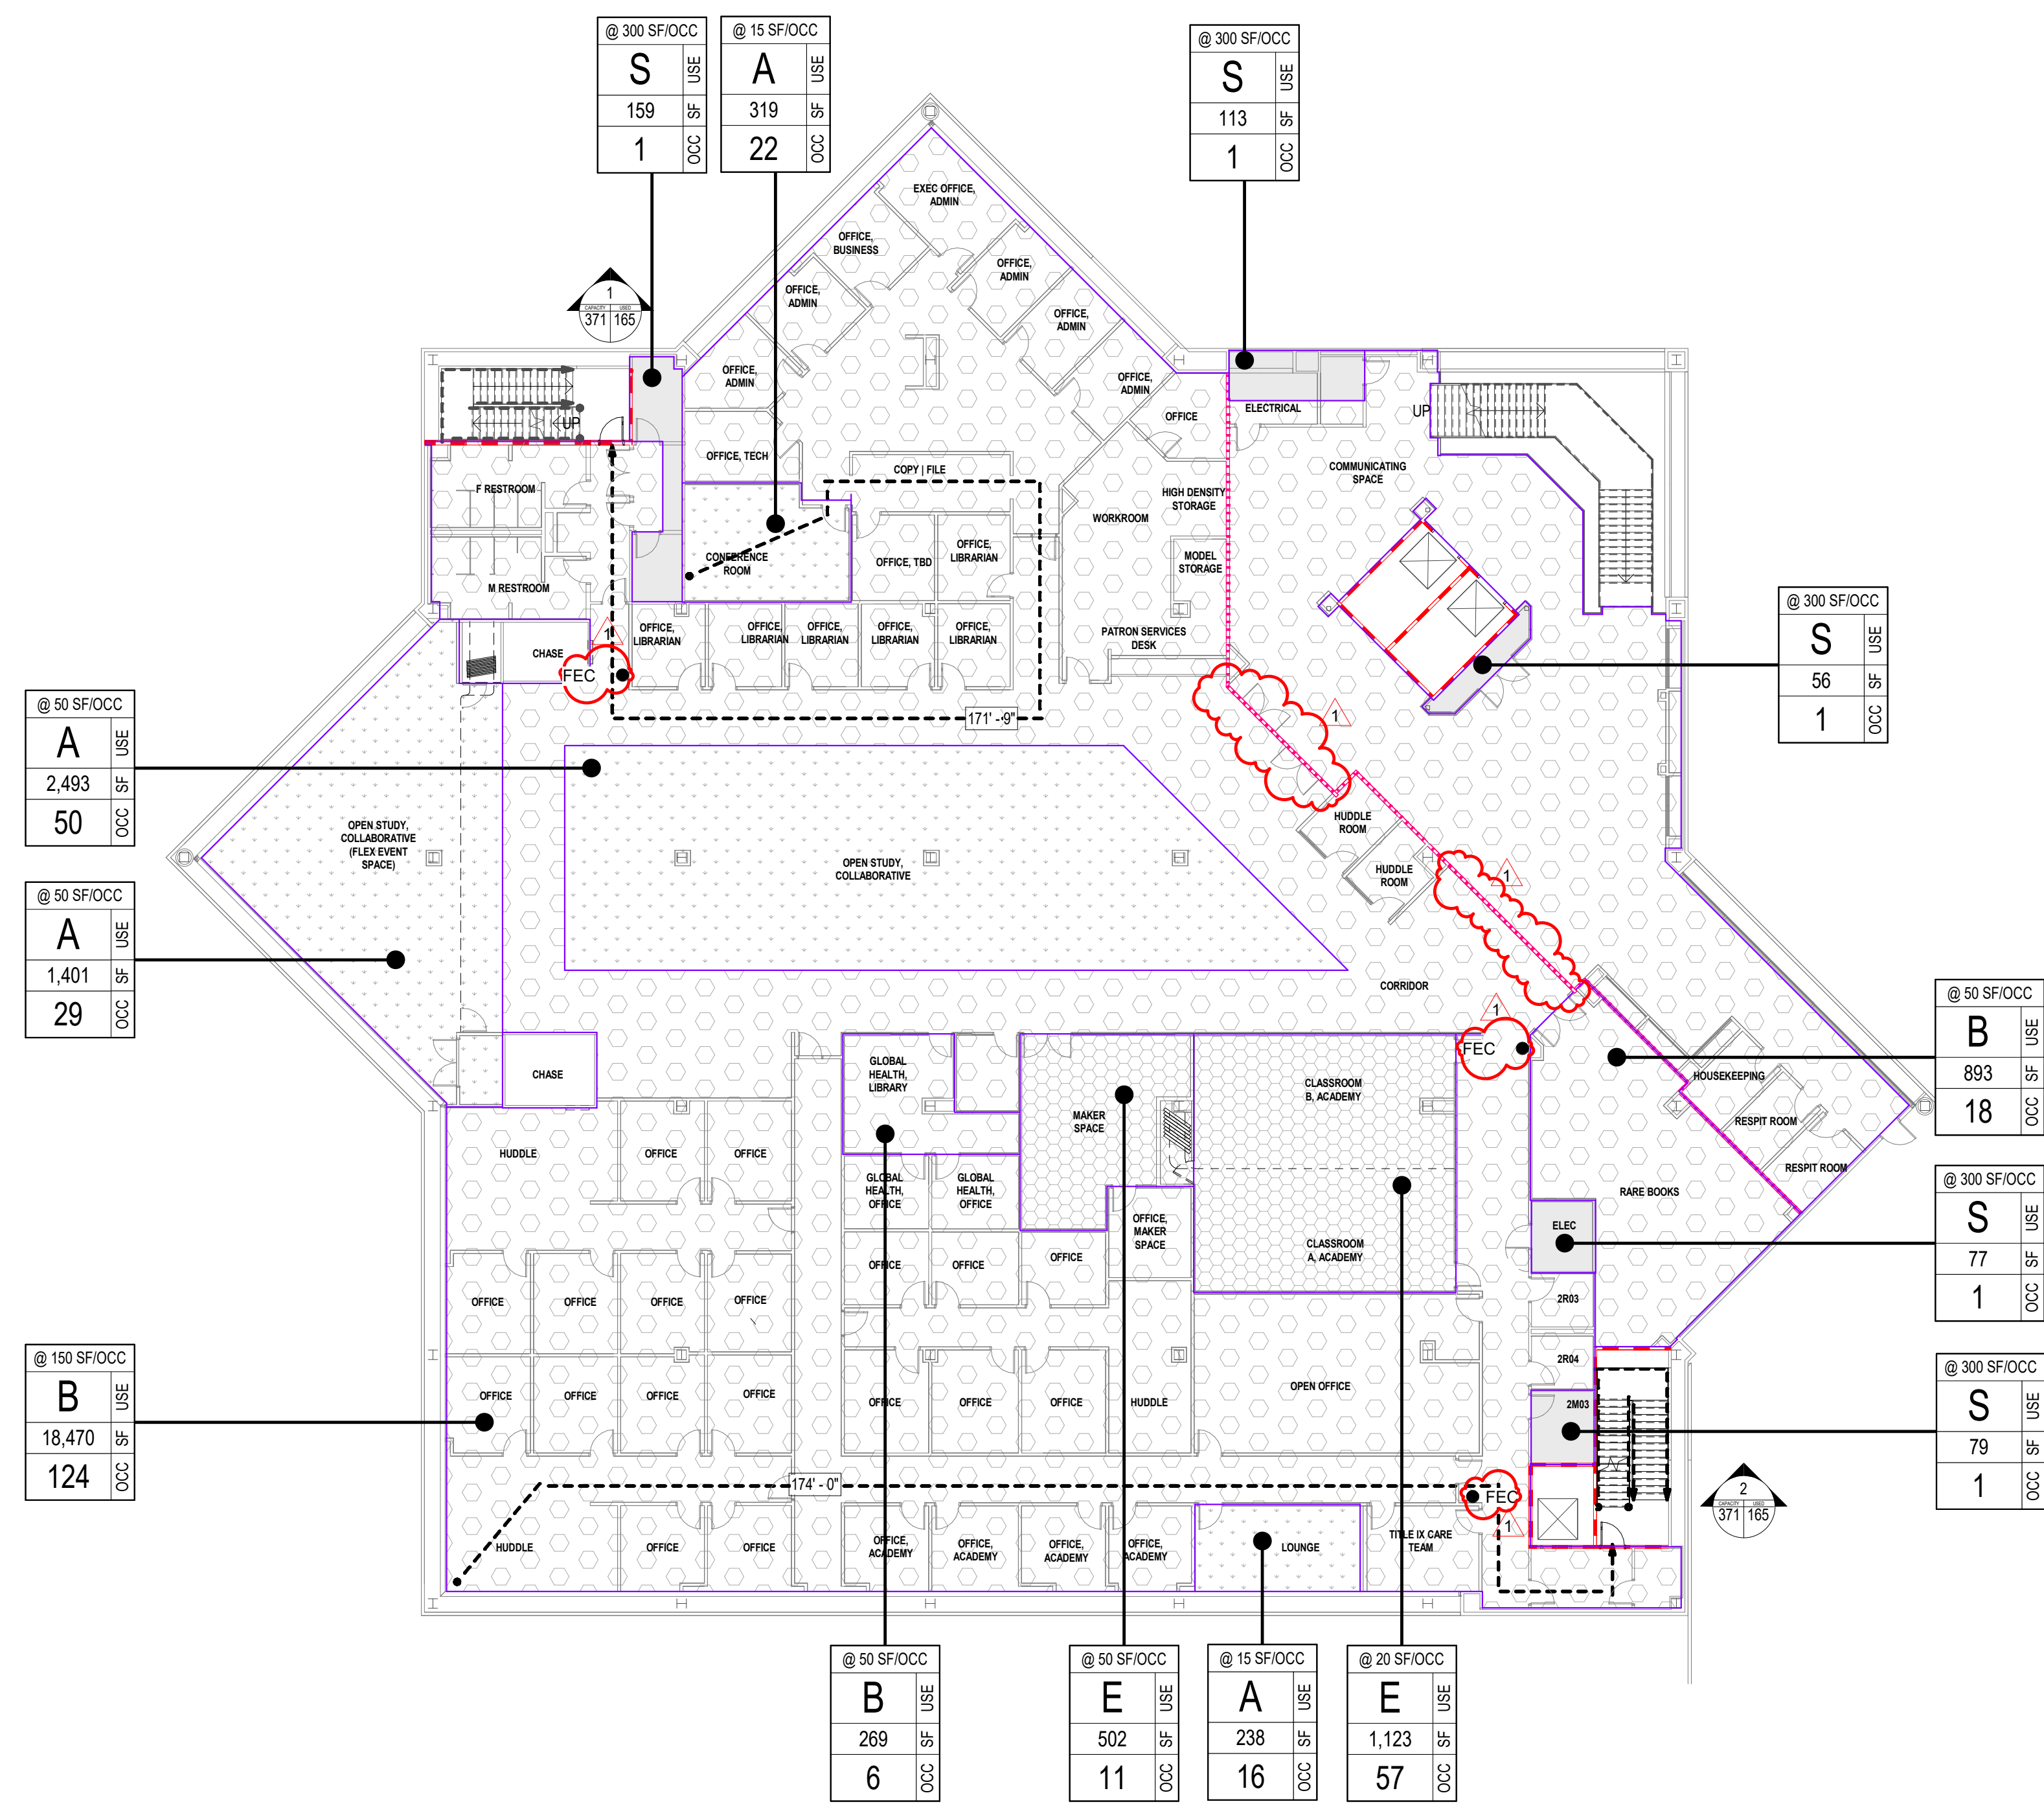

1 ARCHITECTURAL - LIFE SAFETY PLAN - LEVEL 02
SCALE: 1/16" = 1'-0"

LIFE SAFETY NOTES

GENERAL LIFE SAFETY CODE INFORMATION

QUICK RESPONSE FIRE SPRINKLERS	THROUGHOUT
MAXIMUM TRAVEL DISTANCE TO EXIT	300'
MAXIMUM DEAD END CORRIDOR	50'

LIFE SAFETY AREAS AND OCCUPANT LOADS

USE GROUP	OCCUPANCY	USE GROUP DESCRIPTION	AREA	SQFT PER OCCUPANT	OCCUPANT LOAD (TOTAL)
BASEMENT LEVEL:					
S		Accessory storage area, mechanical equipment room	Gross	15,360 SF	36
				15,360 SF	36
LEVEL 01:					
S		Accessory storage area, mechanical equipment room	Gross	436 SF	9
				1,442 SF	9
A		Assembly Uncontrolled (Public and other)	Net	213 SF	15
				24,449 SF	100
B		Business Areas	Gross	403 SF	21
				27,184 SF	302
LEVEL 02:					
S		Accessory storage area, mechanical equipment room	Gross	454 SF	5
				4,432 SF	15
A		Assembly Uncontrolled (Public and other)	Net	1,133 SF	87
				16,430 SF	100
B		Business Areas	Gross	1,133 SF	57
				1,133 SF	57
E		Educational Storage & Other (Academic)	Net	502 SF	11
				1,133 SF	57
S		Library - Reading Rooms	Net	26,162 SF	581
LEVEL 03:					
S		Accessory storage area, mechanical equipment room	Gross	470 SF	5
				6,434 SF	86
B		Business Areas	Gross	16,335 SF	100
				26,028 SF	302

LIFE SAFETY PLAN LEGEND

SYMBOL	DESCRIPTION
	1-HOUR SMOKE BARRIER
	1-HOUR FIRE PARTITION
	1-HOUR FIRE/SMOKE PARTITION
	2-HOUR FIRE PARTITION
	2-HOUR FIRE/SMOKE PARTITION

100/OCC	OCC PER GS/FNSF
B	USE GROUP
5,000	GS/FNSF
60	OCC LOAD

SC-L1A	SMOKE COMPARTMENT NAME
150 SF	SMOKE COMPARTMENT AREA

100'	PATH OF TRAVEL & DISTANCE
------	---------------------------

2	STAIR/EXIT DESIGNATION
150/150	ACTUAL USE
	STAIR/EXIT CAPACITY

	EXIT LIGHT
--	------------

	EXIT LIGHT WITH DIRECTIONAL ARROW
--	-----------------------------------

	FIRE ALARM PULL STATION
--	-------------------------

	FIRE ALARM ANNUNCIATOR
--	------------------------

	FIRE APPARATUS CABINET, FIRE HOSE AND EXTINGUISHER
--	--

	FIRE HOSE CABINET
--	-------------------

	FIRE EXTINGUISHER CABINET
--	---------------------------

	FIRE EXTINGUISHER
--	-------------------


	FIRE STANDPIPE
--	----------------

	SMOKE DETECTOR
--	----------------

USE GROUP LEGEND

	A
	B
	E
	S

KEY PLAN (NOT TO SCALE)

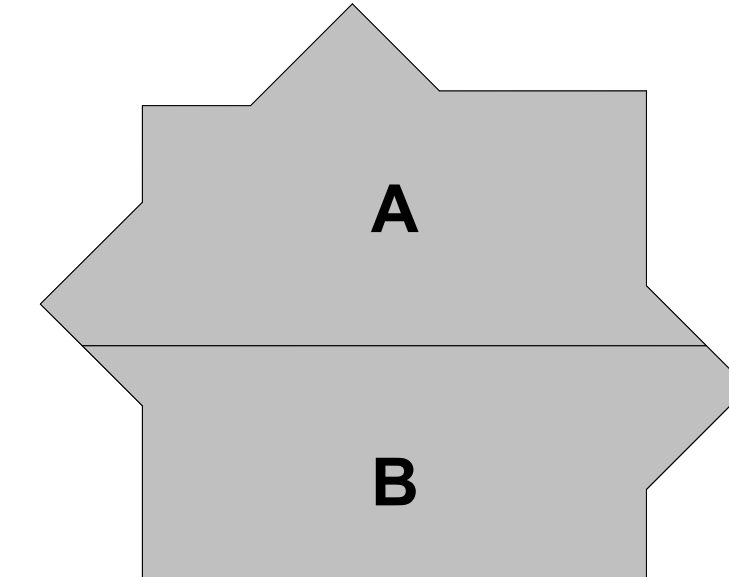

Page Southerland Page, Inc.
1800 Main Street Suite 123
Dallas, TX 75201
page@psl.com

TEL: 214 522 3800
FAX: 214 522 4380

ARCHITECTURE / ENGINEERING / INTERIORS / PLANNING / CONSULTING
Austin / Dallas / Denver / Dubai / Houston / Mexico City / Phoenix /
San Francisco / Washington DC / International Affiliate Offices

MEP ENGINEER
FANNING, FANNING & ASSOCIATES, INC.
2555 74th Street
Lubbock, Texas 79423
(806) 745-2533



TTUHSC Preston Smith Library

Renovation - Level 01 / 02

3601 4th Street, STOP 7781
Lubbock, TX 79430-7781

REVISION HISTORY

REVISION	DESCRIPTION	DATE
1	ADDENDUM 02	10 APR 2025

PROFESSIONAL SEALS



GENERAL - LIFE SAFETY PLAN - LEVEL 02


DRAWN BY	CHECKED BY	TEAM
PROJECT NUMBER	PROJECT ABBREVIATION	
320026.05	TTUHSC-PSL-02-01	
ORIGINAL ISSUE	DATE	21 MAR 2025
ISSUE FOR CONSTRUCTION		

GL-102

SHEET NUMBER

1. THIS PROJECT DESIGN MEETS THE REQUIREMENTS OF:
 - 2021 INTERNATIONAL BUILDING CODE
2. ALL DETAILS AND SECTIONS SHOWN ON THE DRAWINGS ARE INTENDED TO BE TYPICAL AND SHALL BE CONSTRUED TO APPLY TO ANY SIMILAR SITUATION ELSEWHERE ON THE PROJECT, EXCEPT WHERE A DIFFERENT DETAIL IS SHOWN.
3. THE GENERAL CONTRACTOR SHALL VERIFY ALL DIMENSIONS SHOWN ON THE STRUCTURAL DRAWINGS WITH THE ARCHITECTURAL DRAWINGS. THE CONTRACTOR SHALL VERIFY ALL DIMENSIONS, BEFORE CONSTRUCTION AND NOTIFY THE ARCHITECT OF ANY DISCREPANCIES BEFORE PROCEEDING WITH THE WORK.
4. REFER TO EXISTING DRAWINGS FOR THE BUILDING INFORMATION.
5. CONSTRUCTION LOADS SHALL NOT EXCEED THE DESIGN LIVE LOAD OF THE STRUCTURE. PROVIDE ADEQUATE SHORING AND/OR BRACING AS REQUIRED DURING CONSTRUCTION.
6. THE STRUCTURAL CONSTRUCTION DOCUMENTS, SPECIFICATIONS, AND GENERAL NOTES REPRESENT THE IN-PLACE FINISHED STRUCTURE. THEY DO NOT INDICATE THE MEANS OR METHODS OF CONSTRUCTION. THE CONTRACTOR SHALL PROVIDE ALL MEASURES NECESSARY TO PROTECT THE STRUCTURE AND LIFE SAFETY DURING CONSTRUCTION. SITE VISITS, SUBMITTAL REVIEWS, AND RESPONSES TO CONTRACTOR QUESTIONS BY THE ENGINEER OF RECORD DO NOT INCLUDE INSPECTION OR OBSERVATION OF THE ABOVE.

- POST-INSTALLED ANCHORS SHALL ONLY BE USED WHERE SPECIFIED ON THE CONSTRUCTION DOCUMENTS.
2. THE CONTRACTOR SHALL OBTAIN APPROVAL FROM THE ENGINEER-OF-RECORD PRIOR TO INSTALLING POST-INSTALLED ANCHORS IN PLACE OF MISSING OR MISPLACED CAST-IN-PLACE ANCHORS.
3. CARE SHALL BE TAKEN IN PLACING POST-INSTALLED ANCHORS AND SHALL BE LOCATED TO AVOID CONFLICTS WITH EXISTING REBAR.
4. HOLES SHALL BE DRILLED AND CLEANED IN ACCORDANCE WITH THE MANUFACTURER'S PRINTED INSTALLATION INSTRUCTIONS.
5. SUBSTITUTION REQUESTS FOR PRODUCTS OTHER THAN THOSE SPECIFIED SHALL BE SUBMITTED BY THE CONTRACTOR TO THE ENGINEER-OF-RECORD DEMONSTRATING THAT THE SUBSTITUTED PRODUCT IS CAPABLE OF ACHIEVING EQUIVALENT PERFORMANCE (MINIMUM) VALUES OF THE SPECIFIED PRODUCT USING THE APPROPRIATE STANDARD(S).
6. PROVIDE SPECIAL INSPECTIONS AS REQUIRED BY THE ANCHOR'S EVALUATION REPORT (ICC-ES ESR OR IAPMO-US ESR).
7. CONTACT MANUFACTURER'S REPRESENTATIVE FOR THE INITIAL TRAINING AND INSTALLATION OF ANCHORS AND FOR PRODUCT RELATED QUESTIONS AND AVAILABILITY.
8. FOR ANCHORING INTO CRACKED AND UNCRACKED CONCRETE
 - A. MECHANICAL ANCHORS SHALL HAVE BEEN TESTED IN ACCORDANCE WITH ACI 355.2 AND/OR ICC-ES AC109 FOR CRACKED AND UNCRACKED CONCRETE.
 - B. ADHESIVE ANCHORS SHALL HAVE BEEN TESTED IN ACCORDANCE WITH ACI 355.4 AND ICC-ES AC308 FOR CRACKED AND UNCRACKED CONCRETE. ADHESIVE ANCHORS SHALL BE INSTALLED IN CONCRETE HAVING A MINIMUM AGE OF 21 DAYS. HOLES SHALL BE DRY AT THE TIME OF INSTALLATION. ACI 355.4 TEMPERATURE CATEGORY 'B' ASSUMED IN DESIGN. PRIOR TO INSTALLATION OF ADHESIVE ANCHORS IN HORIZONTAL OR UPWARDLY INCLINED ORIENTATIONS RESISTING SUSTAINED TENSION LOADS, INSTALLERS ARE REQUIRED TO BE CERTIFIED IN ACCORDANCE WITH THE ACI/CRSI ADHESIVE ANCHOR INSTALLER CERTIFICATION PROGRAM AND MUST BE CONTINUOUSLY INSPECTED.
 - C. SPECIALIZED DUST EXTRACTION SYSTEMS ARE APPROVED FOR USE TO DRILL AND CLEAN HOLES.
9. FOR ANCHORING INTO GROUT-FILLED CONCRETE MASONRY UNITS
 - A. MECHANICAL ANCHORS SHALL HAVE BEEN TESTED IN ACCORDANCE WITH ICC-ES AC01 (EXPANSION ANCHORS) OR ICC-ES AC106 (SCREW ANCHORS).
 - B. ADHESIVE ANCHORS SHALL HAVE BEEN TESTED IN ACCORDANCE WITH ICC-ES AC68.
10. FOR ANCHORING INTO HOLLOW CONCRETE MASONRY UNITS
 - A. MECHANICAL ANCHORS SHALL HAVE BEEN TESTED IN ACCORDANCE WITH ICC-ES AC106 FOR PERFORMANCE IN HOLLOW CONCRETE MASONRY.
 - B. ADHESIVE ANCHORS SHALL HAVE BEEN TESTED IN ACCORDANCE WITH ICC-ES AC68 FOR PERFORMANCE IN HOLLOW CONCRETE MASONRY USING MANUFACTURER'S RECOMMENDED SCREEN TUBES.
11. FOR ANCHORING INTO UNREINFORCED MASONRY
 - A. ADHESIVE ANCHORS SHALL HAVE BEEN TESTED IN ACCORDANCE WITH ICC-ES AC60 FOR PERFORMANCE IN UNREINFORCED MASONRY CONFIGURATIONS A, B AND C.
12. FOR ANCHORING LOW VELOCITY FASTENERS AND THREADED STUDS INTO CONCRETE, MASONRY AND STEEL.
 - A. POWDER-ACTUATED FASTENERS SHALL HAVE BEEN TESTED IN ACCORDANCE WITH ICC-ES AC70.
 - B. GAS-ACTUATED FASTENERS SHALL HAVE BEEN TESTED IN ACCORDANCE WITH ICC-ES AC70.

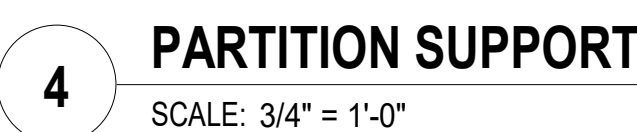

3. STRUCTURAL STEEL FOR COLUMNS AND BEAMS SHALL BE NEW DOMESTIC STEEL CONFORMING TO ASTM A992 FOR WIDE FLANGE SHAPES, ASTM A500 GRADE B FOR SQUARE AND RECTANGULAR HSS MEMBERS, ASTM A500 GRADE B FOR ROUND HSS MEMBERS AND A36 FOR CHANNELS. ANGLES, PLATES, BARS AND ANY OTHER MISCELLANEOUS SPECIES, MEMBERS AND CONNECTIONS SHALL BE DESIGNED, FABRICATED, AND ERECTED IN ACCORDANCE WITH THE LATEST EDITION OF THE AISC SPECIFICATIONS.
2. UNLESS OTHERWISE NOTED, ALL BOLTS SHALL BE 3/4" DIAMETER A325-N BOLTS. ALL CONNECTIONS NOT DETAILED SHALL BE "FRAMED BEAM CONNECTIONS" USING 3/4" DIA A325-N BOLTS AS SHOWN IN THE AISC MANUAL, 13TH EDITION. BOLTS AT MOMENT CONNECTIONS SHALL BE 3/4" DIAMETER A325-SC. BOLTS SHALL BE PROOF LOADED IN ACCORDANCE WITH ONE OF THE APPROPRIATE METHODS APPROVED BY AISC. REFER TO THE SPECIFICATIONS.
3. ALL SHOP CONNECTIONS SHALL BE WELDED, UNLESS NOTED OTHERWISE.
4. ALL WELDING SHALL CONFORM TO THE REQUIREMENTS OF THE AMERICAN WELDING SOCIETY AND THE AMERICAN INSTITUTE OF STEEL CONSTRUCTION, AND SHALL BE DONE ONLY BY CERTIFIED WELDERS. WELDER CERTIFICATIONS SHALL BE AVAILABLE AT THE PROJECT SITE AT ALL TIMES DURING FIELD WELDING WORK.
5. ALL WELDS EXPOSED TO WEATHERING AFTER FINAL CONSTRUCTION SHALL BE GROUND SMOOTH AFTER WELDING. REFER TO ARCHITECTURAL DRAWINGS AND SPECIFICATIONS FOR PAINTING.
6. ANCHOR BOLTS SHALL BE SET WITH A TEMPLATE AND DOUBLE NUTS TO INSURE PROPER LOCATION AND ALIGNMENT. CONTRACTOR SHALL VERIFY ANCHOR BOLT PLACEMENT WITH FINAL ERECTION DRAWINGS PRIOR TO STEEL FABRICATION.
7. TOLERANCES: ANCHOR BOLTS SHALL BE SET WITHIN 1/8" OF THAT SHOWN ON THE DRAWINGS.
8. FIELD BEAM-TO-COLUMN CONNECTIONS SHALL BE WELDED AS DETAILED TO DEVELOP THE FULL MOMENT CAPACITY OF THE BEAM THROUGH THE COLUMN AT CONNECTIONS SO NOTED ON THE DRAWINGS.
9. UNLESS OTHERWISE SHOWN OR NOTED, NON-CONTINUOUS JOINTS SHALL BE DETAILED AS REQUIRED BY PART 4 OF THE AISC MANUAL - FRAMED BEAM CONNECTIONS, FOR 65% OF THE ALLOWABLE LOADS FOR BEAMS TABULATED IN PART 2 OF THE AISC MANUAL.
10. PROVIDE BOLTS AND PUNCH HOLES IN STRUCTURAL AND MISCELLANEOUS METAL FOR ATTACHMENTS/WOOD NAILERS AS REQUIRED ON THE ARCHITECTURAL, MECHANICAL OR STRUCTURAL DRAWINGS.
11. HOT DIP GALVANIZE ALL STRUCTURAL STEEL EXPOSED TO THE WEATHER.
12. ALL STEEL EXPOSED TO INTERIOR SPACE SHALL BE AESS.
13. ALL FULL PENETRATION WELDS SHALL BE TESTED.
14. HSA MUST BE SECURELY FASTENED TO BEAM FLANGE. IN CASE WHERE ONLY A SINGLE ROW OF STUDS ARE REQUIRED HSA MUST BE PLACED DIRECTLY OVER BEAM WEB.

1. FORMWORK AND THEIR SUBMITTALS SHALL COMPLY WITH ACI 347R - RECOMMENDED PRACTICE FOR CONCRETE FORMWORK.
2. ANCHOR BOLTS AND EMBEDDED PLATES SHALL BE SET WITH SECURELY FASTENED TEMPLATES.
3. PROVIDE CHAMFER STRIPS IN FORMS AT ALL CORNERS, EXPANSION JOINTS, AND END OF WALLS AND BEAMS. REFERENCE ARCHITECTURE.

1. ANY SHOP DRAWING NOT CHECKED AND INITIALED BY THE SUPPLIER/DETAILER PRIOR TO SUBMITTING FOR ARCHITECTURAL AND ENGINEERING REVIEW, WILL BE RETURNED WITHOUT REVIEW.
2. THE CONSTRUCTION DOCUMENTS MAY NOT BE REPRODUCED FOR USE AS SHOP DRAWINGS.
3. ELECTRONIC FILES OF CONSTRUCTION DOCUMENTS WILL NOT BE MADE AVAILABLE FOR USE AS SHOP DRAWINGS

1. THE OWNER SHALL ENGAGE A QUALIFIED TESTING LAB TO PROVIDE THE SPECIAL INSPECTIONS REQUIRED BY CODE
2. REFER TO IBC CHAPTER 17 FOR SPECIAL INSPECTIONS.




PLAN NOTES:

1. CONTRACTOR SHALL FIELD VERIFY EXISTING CONDITIONS IN THE FIELD & NOTIFY EOR IF CONDITIONS VARY.
2. DO NOT DAMAGE EXISTING STRUCTURAL FRAMING.
3. THE LOCATION OF ALL FLOOR PENETRATION, DRAIN SUMPS, ETC. SHALL BE VERIFIED AND COORDINATED WITH OTHER TRADES. NO OPENING SHALL INTERFERE WITH STRUCTURAL ELEMENTS UNLESS COORDINATED WITH STRUCTURAL ENGINEER IN WRITING.
4. EXISTING FRAMING ("EX") SHOWN AS HALFTONE TYPE.
5. LOCATE & AVOID EXISTING FRAMING/REINFORCING BY NON-DESTRUCTIVE BEAMS PRIOR TO ANCHOR INSTALLATION TYPE.



Autodesk Docs://320026-TexasTech-HSC-L-PS-Library/320026-A-TTUHSC-PSL-LVL-02-R24-CENTRAL.rvt
FILE PATH: 4/8/2025 5:20:27 PM
USER NAME: DATE/TIME: 4/8/2025 5:20:27 PM

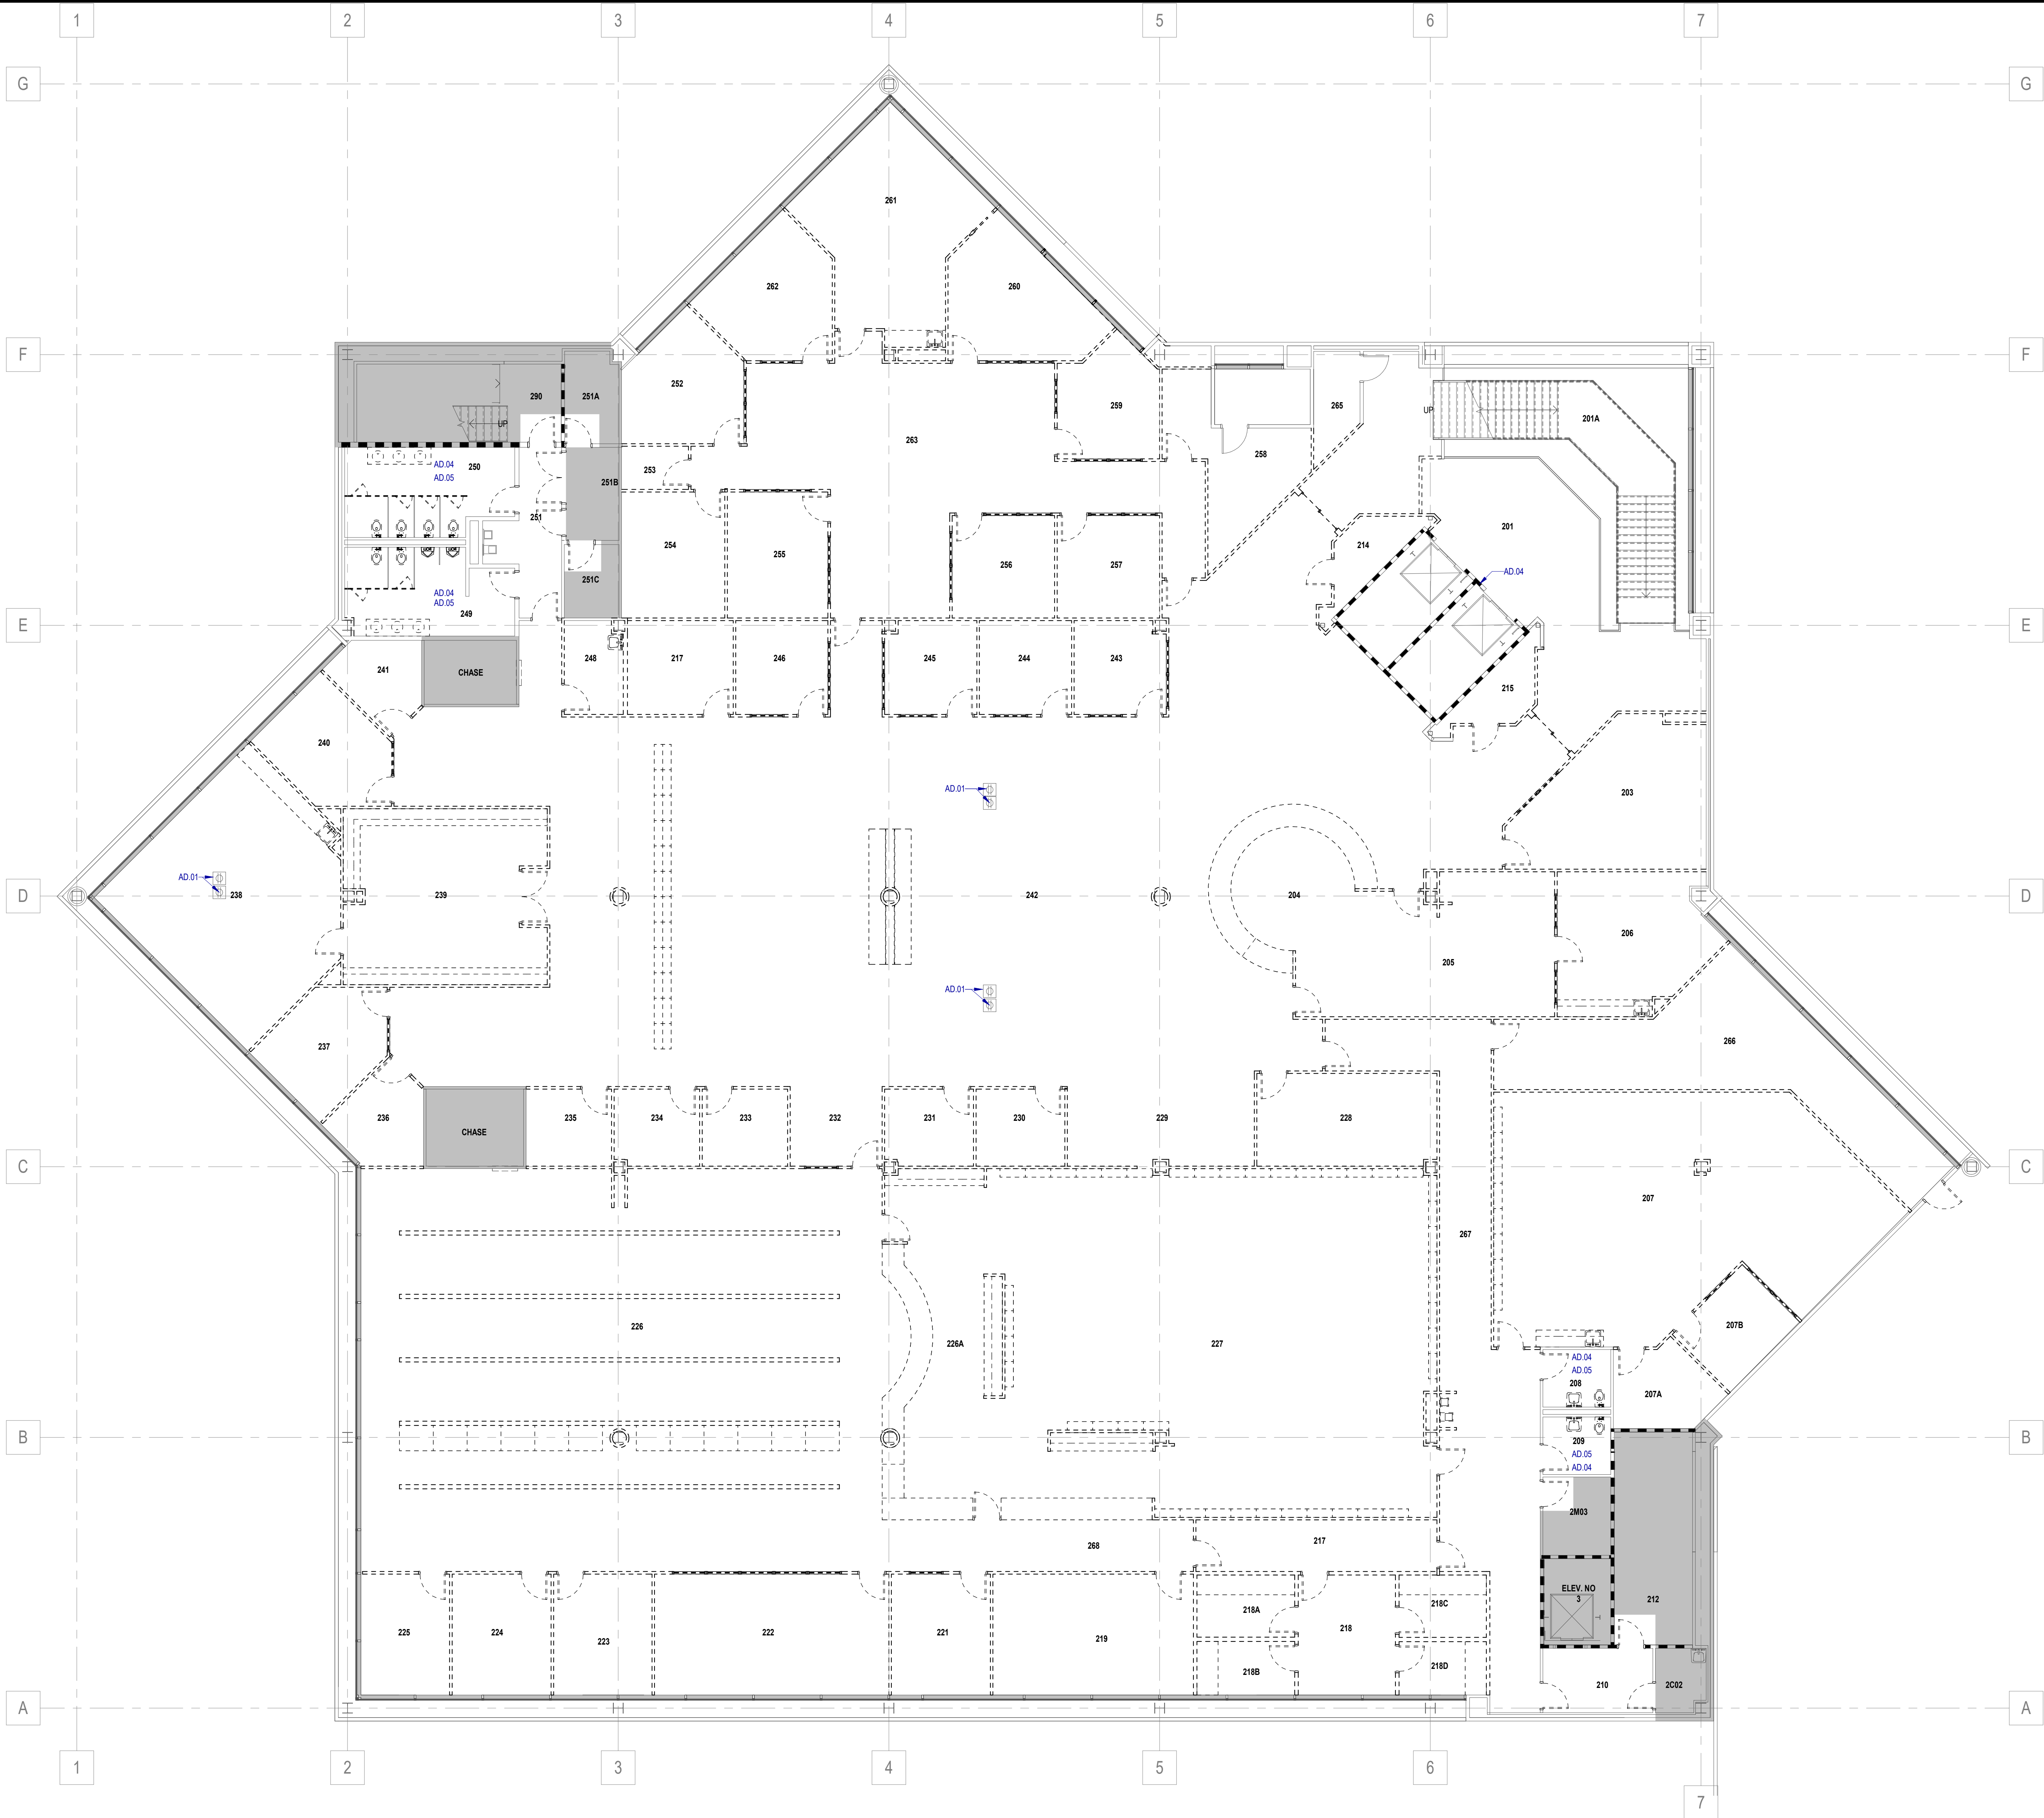

1 ARCHITECTURAL - DEMOLITION PLAN - LEVEL 02
SCALE: 1/8" = 1'-0"

DEMOLITION PLAN GENERAL NOTES

- COORDINATE ALL DEMOLITION WITH THE INFORMATION PROVIDED IN THIS SET OF CONTRACT DOCUMENTS.
- ALL MATERIAL TO BE DEMOLISHED AND REMOVED SHALL BE DISPOSED OF AS APPROVED BY LOCAL ORDINANCE AND CODES.
- THE EXISTING AREAS TO REMAIN SHALL BE PROTECTED. ALL DAMAGE RESULTING FROM WORK IN THIS CONTRACT SHALL BE RETURNED TO ITS ORIGINAL STATE. CAREFULLY DISMANTLE AND REMOVE MATERIALS SHOWN ON PLANS TO BE DEMOLISHED. NOTIFY ARCHITECT PRIOR TO CONSTRUCTION OF ANY DEMOLITION WORK THAT MAY DAMAGE THE INTEGRITY OF ANY MATERIALS WHICH ARE TO REMAIN AS EXISTING.
- PARTS OF THIS BUILDING WILL BE ACTIVE. THE CONTRACTOR SHALL COORDINATE ALL SYSTEM SHUT DOWNS WITH THE FACILITY MANAGER. THE CONTRACTOR SHALL INFORM THE FACILITY MANAGER OF SCHEDULE, DURATION AND AREAS AFFECTED AND SHALL RECEIVE OWNER APPROVAL PRIOR TO SHUT DOWN COMMENCEMENT.
- THE PREMISES IN WHICH WORK IS BEING PERFORMED SHALL BE KEPT CLEAN AT ALL TIMES.
- EXISTING CONCRETE SLABS INTENDED TO REMAIN SHALL BE REPAIRED AND FLOATED LEVEL W/ SURROUNDING SLABS AND PREPARED TO RECEIVE NEW FINISH.
- DOORS, FRAMES, HARDWARE, PLUMBING AND ELECTRICAL DEVICES AND FIXTURES, ETC. NOT REUSED SHALL BE DELIVERED TO OWNER, COORDINATE THIS WITH THE OWNER.
- REMOVE ALL CONDUCTORS, CONDUIT AND BOXES BACK TO PANEL IN RENOVATED AREA REMOVE ALL RELATED STRAPS AND HANGERS - RE: ELECTRICAL DRAWINGS FOR MORE INFORMATION.
- REMOVE ALL PLUMBING FROM RENOVATED AREA TO NEAREST JUNCTURE WHERE THE LINE IS STILL USED AND CAP. REMOVE RELATED UNUSED STRAPS AND HANGERS, RE: PLUMBING DRAWINGS FOR MORE INFORMATION. PLUMBING LINE SERVING OTHER AREAS SHALL BE KEPT. CONTRACTOR IS TO VERIFY PLUMBING LINES PRIOR TO DEMOLITION. RE: PLUMBING DRAWINGS FOR MORE INFORMATION.
- REMOVE ALL HVAC DUCTWORK IN RENOVATED AREA TO NEAREST JUNCTURE WHERE THE DUCT IS STILL IN USE AND CAP AS REQUIRED. REMOVE ALL RELATED STRAPS AND HANGERS. RE: MECHANICAL DRAWINGS FOR MORE INFORMATION.
- DURING CONSTRUCTION, MAINTAIN NEGATIVE AIR PRESSURE ON CONSTRUCTION ZONE WHILE MAINTAINING POSITIVE PRESSURE ON THE NON-CONSTRUCTION ZONE.
- MAINTAIN EXISTING UTILITIES TO REMAIN IN SERVICE. IDENTIFY AND PROTECT AGAINST DAMAGE DURING DEMOLITION. THE CONTRACTOR IS TO REFERENCE THE CIVIL DOCUMENTS AND TO NOTIFY THE OWNER, ARCHITECT, AND CIVIL ENGINEER IF ANY UTILITIES ARE UNCOVERED DURING THE DEMOLITION PHASE THAT ARE NOT IDENTIFIED IN THE DOCUMENTS PROVIDED.
- REMOVE EXISTING CEILINGS AND CEILING SUPPORT SYSTEM WHERE NEW CEILINGS ARE INDICATED, UNLESS NOTED OTHERWISE.
- REMOVE EXISTING FINISHES AS REQUIRED AS PER FINISH MANUFACTURE'S PRINTED INSTRUCTIONS. SEE FINISH SCHEDULE FOR NEW FINISHES.
- PROTECT EXISTING FIRE PROOFING OR FIRE ASSEMBLIES INDICATED TO REMAIN. DAMAGE DURING DEMOLITION SHALL BE REPAIRED TO CONFORM TO ORIGINAL FIRE PROTECTION REQUIREMENTS.
- AREA OR OBJECTS IDENTIFIED AS "EXISTING TO REMAIN" OR "NOT IN CONTRACT" - "N/C" SHALL BE PROTECTED. ALL DAMAGE TO THESE AREAS RESULTING FROM DEMOLITION WORK WITHIN THIS CONTRACT SHALL BE RETURNED TO ITS ORIGINAL STATE.
- ALL INFORMATION REGARDING EXISTING CONDITIONS IS BASED ON OWNER SUPPLIED DOCUMENTS AND MAY NOT REFLECT ACTUAL FIELD CONDITIONS. UPON DISCOVERY OF ANY DISCREPANCIES BETWEEN DRAWINGS DEPICTING EXISTING CONDITIONS OR UPON DISCOVERY OF UNKNOWN CONDITIONS DETRIMENTAL TO THE COMPLETION OF THE WORK AS INDICATED ON THE DRAWINGS, THE CONTRACTOR SHALL IMMEDIATELY NOTIFY THE ARCHITECT, IN WRITING, OF THE CONDITIONS IN QUESTION BEFORE PROCEEDING WITH THE WORK IN THAT AREA.
- COORDINATE ALL DEMOLITION FROM ALL DISCIPLINES WITH THE INFORMATION PROVIDED ON CONTRACT DOCUMENTS.
- COORDINATE OWNER WALK THROUGH TO IDENTIFY ALL ITEMS TO BE SALVAGED FOR THE OWNER'S RE-USE, INCLUDING BUT NOT LIMITED TO MEDICAL EQUIPMENT, FRAMED DOCUMENTS, SIGNS/GRAPHIC ART, HISTORICAL COLLECTIBLES, ETC. REMOVE ITEMS THUS IDENTIFIED AND GIVE TO THE OWNER, OR STORE FOR RE-USE AT PER OWNER'S DIRECTION.
- THIS PLAN IS BEING ISSUED FOR THE PURPOSE OF ASSISTING THE CONTRACTOR IN BETTER UNDERSTANDING THE PROJECT SCOPE. IT SHALL REMAIN THE CONTRACTOR'S RESPONSIBILITY TO VISIT THE JOB SITE AND FAMILIARIZE HIMSELF WITH THE EXISTING CONDITIONS.
- CONTRACTOR TO EVALUATE EXISTING FIREPROOFING AFTER DEMOLITION AND REPAIR AS NEEDED.
- ALL EXISTING CEILING WITHIN SCOPE OF WORK TO BE DEMOLISHED AND REPLACED PER AC-101 AND AC-102.
- ALL EXISTING FLOORING WITHIN SCOPE OF WORK TO BE DEMOLISHED AND REPLACED PER AI-101 AND AI-102.

KEYED NOTES

NUMBER	DESCRIPTION
AD.01	EXISTING FLOOR BOX AND COVER TO REMAIN; REF. ELEC.
AD.04	ALL EXISTING TILE WALL FINISHES TO BE DEMOLISHED
AD.05	GC TO REVIEW RESTROOM WALL, TOILET PARTITION LAYOUT, AND FIXTURE LAYOUT WITH ARCHITECT FOLLOWING DEMOLITION TO ENSURE DESIGN INTENT AND TAS CLEARANCE COMPLIANCE DURING BUILD BACK

DEMOLITION PLAN LEGEND

SYMBOL	DESCRIPTION
---	EXISTING CONSTRUCTION TO BE DEMOLISHED
---	EXISTING CONSTRUCTION TO REMAIN

Page Southerland Page, Inc.
1800 Main Street Suite 123
Dallas, TX 75201
page@pspi.com
TEL: 214.522.3800
FAX: 214.522.4380
ARCHITECTURE / ENGINEERING / INTERIORS / PLANNING / CONSULTING
Austin / Dallas / Denver / Dubai / Houston / Mexico City / Phoenix /
San Francisco / Washington DC / International Affiliate Offices


MEP ENGINEER
FANNING, FANNING & ASSOCIATES, INC.
2555 74th Street
Lubbock, Texas 79423
(806) 745-2533



TTUHSC Preston Smith Library
Renovation - Level 01 / 02
3601 4th Street, STOP 7781
Lubbock, TX 79430-7781

REVISION HISTORY

REVISION	DESCRIPTION	DATE
1	ADDENDUM 02	10 APR 2025

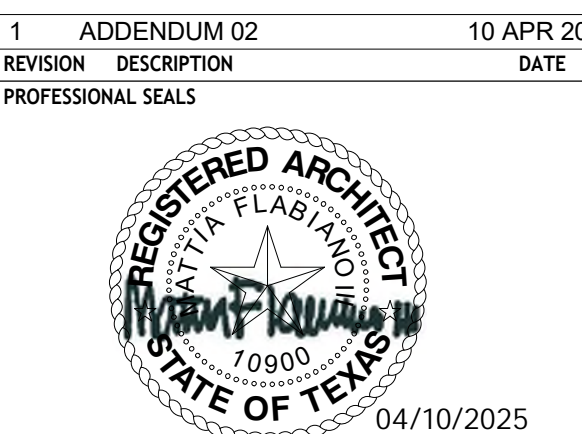


ARCHITECTURAL - DEMOLITION PLAN
- LEVEL 02

DRAWN BY	CHECKED BY
TEAM	TEAM
PROJECT NUMBER 320026.05	PROJECT ABBREVIATION TTUHSC-PSL-02-01
ORIGINAL ISSUE DATE	DATE 21 MAR 2025
ISSUE FOR CONSTRUCTION	

AD-102
SHEET NUMBER

Autodesk Docs://320026-TexasTech-HSC-L-PS-Library/320026-A-TTUHSC-PSL-LVL 02-R24-CENTRAL.rvt
FILE PATH: 320026-TexasTech-HSC-L-PS-Library/320026-A-TTUHSC-PSL-LVL 02-R24-CENTRAL.rvt
USER NAME: T. J. B. / T. J. B.
DATE/TIME: 4/8/2025 3:19:49 PM

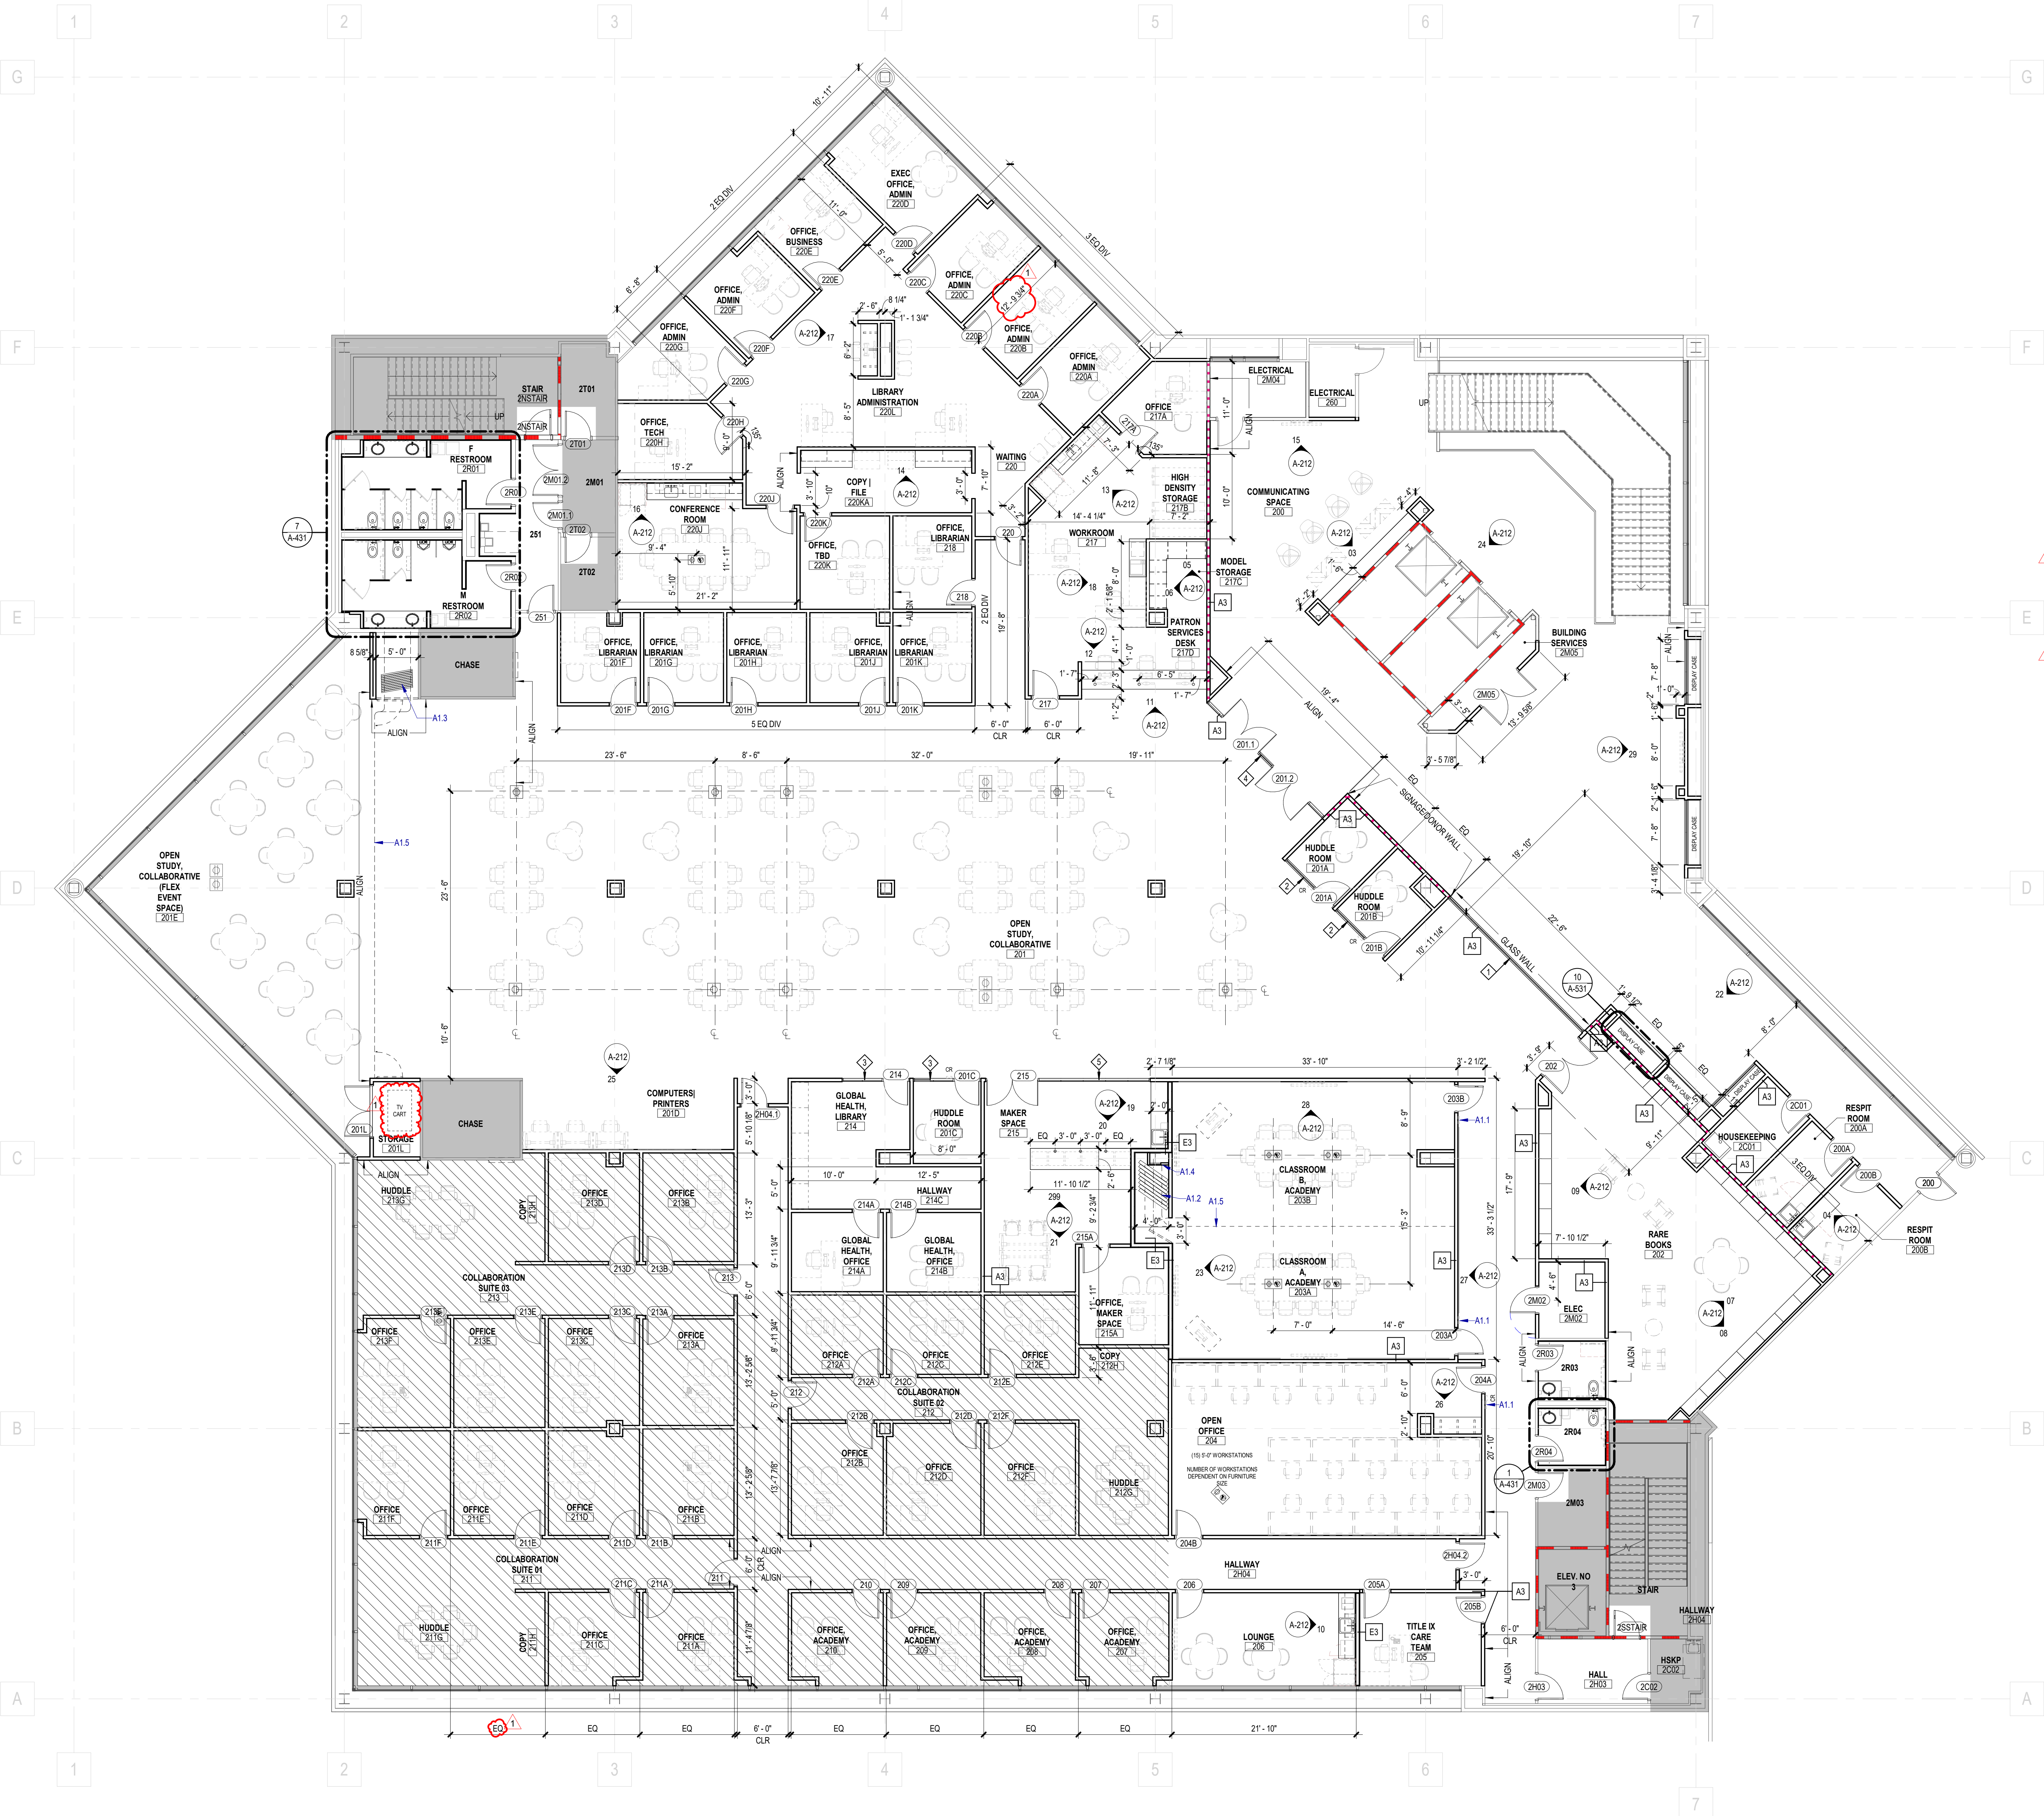

1 ARCHITECTURAL - OVERALL FLOOR PLAN - LEVEL 02
SCALE: 1/8" = 1'-0"


FLOOR PLAN GENERAL NOTES

1. ALL UNMARKED PARTITIONS ARE TYPE C3. ALL COLUMN AND CHASE FURRING TO BE PARTITION TYPE F3.
2. ALL WINDOW & DOOR PLAN OPENINGS ARE DIMENSIONED ON AREA PLANS.
3. FOR FIRE AND LIFE SAFETY PLANS, REFER TO G1 DRAWINGS.
4. REFER TO A2 SERIES DRAWINGS, EXTERIOR ELEVATIONS, A3 BUILDING AND WALL SECTIONS.
5. REFER TO A6 SERIES FOR ALL PARTITIONS, DOORS, WINDOWS, AND ACCESSORIES.
6. INSTALL APPROPRIATE MANUFACTURED EXPANSION JOINT COVERS AT ALL VISIBLE BUILDING EXPANSION JOINTS. TOP OF COVER OF FLOOR EXPANSION JOINT COVERS TO BE FLUSH WITH TOP OF FINISHED FLOOR.
7. ALL PLAN DIMENSIONS ARE TAKEN TO THE CENTERLINE OF COLUMNS AND TO THE OUTERMOST SURFACE OF THE WALL (INCLUDING TILE, STONE, PLASTER, ETC. EXCLUDING TRIM) UNLESS NOTED OTHERWISE.
8. PARTITIONS AT PERIMETER WALL ARE TO BE CENTERED ON MULLION OR COLUMN, UNLESS NOTED OTHERWISE.
9. INSTALL BLOCKING AS REQUIRED TO SUPPORT WALL MOUNTED DEVICES.
10. AT ALL SPANDREL GLASS LOCATIONS, FACE OF INTERIOR WALL TO BE CONTINUOUS WITH ADJACENT WALL.
11. EQUIPMENT AND APPLIANCES SHOWN FOR REFERENCE ONLY. OWNER TO PURCHASE PRODUCTS. GC TO COORD WITH OWNER FOR FINAL PRODUCT LOCATIONS AND SUPPLY NEEDS PRIOR TO COMPLETION OF WALL ROUGH-IN.
12. FURNITURE LAYOUT SHOWN FOR REFERENCE ONLY. GC TO COORD WITH OWNER'S FURNITURE VENDOR FOR FINAL LAYOUT.
13. FLOOR AND FURNITURE FEED LOCATIONS SHOWN FOR REFERENCE ONLY. GC TO COORD WITH OWNER'S FURNITURE VENDOR FOR FINAL REQUIREMENTS AND LOCATIONS. FURNITURE VENDOR TO VERIFY LOCATIONS IN THE FIELD PRIOR TO INSTALL.














KEYED NOTES

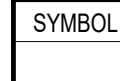NUMBER	DESCRIPTION
A-1.1	BOOKING SYSTEMS GREEN REF. SPEEDS.
A-1.2	MANUAL MOVABLE WALL, MODERNFOLD ACOUSTI-SEAL ENCORE 66 STC, 9'-10" HEIGHT, STORAGE POCKET DOOR PROVIDED BY MFR.
A-1.3	MANUAL MOVABLE GLASS PANEL WALL, MODERNFOLD PUREVIEW FSW-C 15 STC, 9'-10" MAX HEIGHT, STORAGE POCKET DOOR PROVIDED BY MFR.
A-1.4	FURR OUT COLUMN TO PROTECT FIRE PROOFING WITH MINIMAL FOOTPRINT. GC TO COORD FURR OUT WITH CLEARANCE REQUIREMENTS OF MOVABLE PARTITION STACK.
A-1.5	OVERHEAD TRACK OF SPECIFIED OPERABLE PARTITION TO HAVE ABOVE CEILING STRUCTURE PROVIDED BY GC. PROVIDE TUBE STEEL FRAMING AT 4'-0" O.C. SUPPORTED FROM THE EXISTING LEVEL 03 WIDE FLANGE FRAMING. ANGLES WILL RUN CONTINUOUSLY ON EACH SIDE OF THE BOTTOM OF THE TUBES TO ACCOMMODATE HANGING RODS FROM THE PARTITION ASSEMBLY. DIAGONAL KICKERS


ADD ALTERNATE SCOPE

-  ADD ALTERNATE 02
GC TO PRICE WALL AND DOOR SCOPE FOR HATCHED AREA SEPARATELY FOR OWNER REVIEW AND APPROVAL AGAINST COST OF DEMOUNTABLE WALLS. FLOORING, CEILING, LIGHTING SCOPE TO REMAIN THE SAME. ELECTRICAL SCOPE WOULD REVISE FROM IN-WALL POWER TO POWERING DEMOUNTABLE WALL SOLUTION.

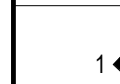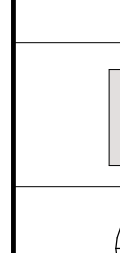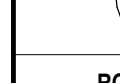FLOOR PLAN LEGEND

SYMBOL	DESCRIPTION
	KEYED NOTE KEYED NOTES ONLY APPLY TO THIS SHEET
	PARTITION TAG REFER TO PARTITION SCHEDULE
	BUILDING SECTION TAG WALL SECTION TAG
	EXTERIOR ELEVATION TAG
	INTERIOR ELEVATION TAG
	NOT IN SCOPE
	PLAN REFERENCE TAG
	ROOM NAME ROOM NUMBER
	0-HOUR SMOKE BARRIER 1-HOUR FIRE PARTITION 1-HOUR FIRE/SMOKE PARTITION 2-HOUR FIRE PARTITION 2-HOUR FIRE/SMOKE PARTITION
	NEW DOOR WITH DOOR TAG REF DOOR SCHED
	NEW WINDOW WITH WINDOW MARK REF GLAZING ELEVATIONS
	EXISTING COLUMN GRID DESIGNATIONS
	NEW COLUMN GRID DESIGNATIONS

KEY PLAN (NOT TO SCALE)

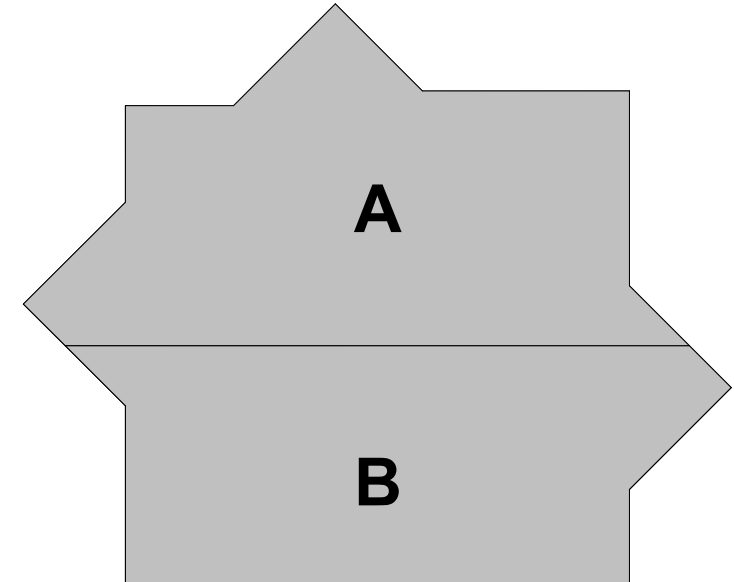

Page Southerland Page, Inc.
1800 Main Street Suite 123
Dallas, TX 75201
page@psl.com

ARCHITECTURE / ENGINEERING / INTERIORS / PLANNING / CONSULTING
Austin / Dallas / Denver / Dubai / Houston / Mexico City / Phoenix /
San Francisco / Washington DC / International Affiliate Offices

MEP ENGINEER
FANNING, FANNING & ASSOCIATES, INC.
2555 74th Street
Lubbock, Texas 79423
(806) 745-2533




TTUHSC Preston Smith Library Renovation - Level 01 / 02

3601 4th Street, STOP 7781
Lubbock, TX 79430-7781

REVISION HISTORY


REVISION	DESCRIPTION	DATE
1	ADDENDUM 02	10 APR 2025

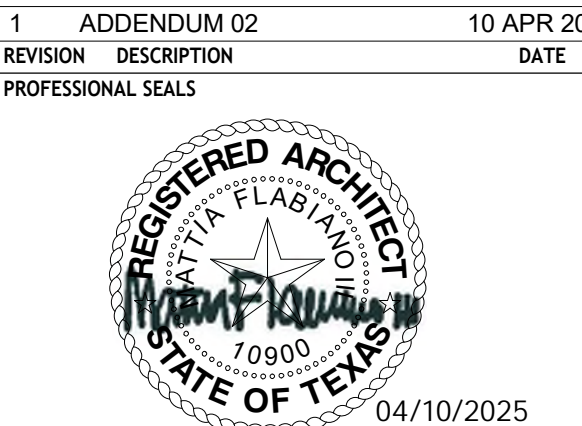

ARCHITECTURAL - FLOOR PLAN -
LEVEL 02

DRAWN BY: TEAM
PROJECT NUMBER: 320026.05
ORIGINAL ISSUE: 21 MAR 2025
CHECKED BY: TEAM
PROJECT ABBREVIATION: TTUHSC-PSL-02-01
DATE: 21 MAR 2025
ISSUE FOR CONSTRUCTION

Autodesk Docs://320026-TexasTech-HSC-L-PS-Library/320026-A-TTUHSC-PSL-LVL-02-R24-CENTRAL.rvt
FILE PATH: 4/9/2025 6:30:44 PM
USER NAME: DATE/TIME: 4/9/2025 6:30:44 PM

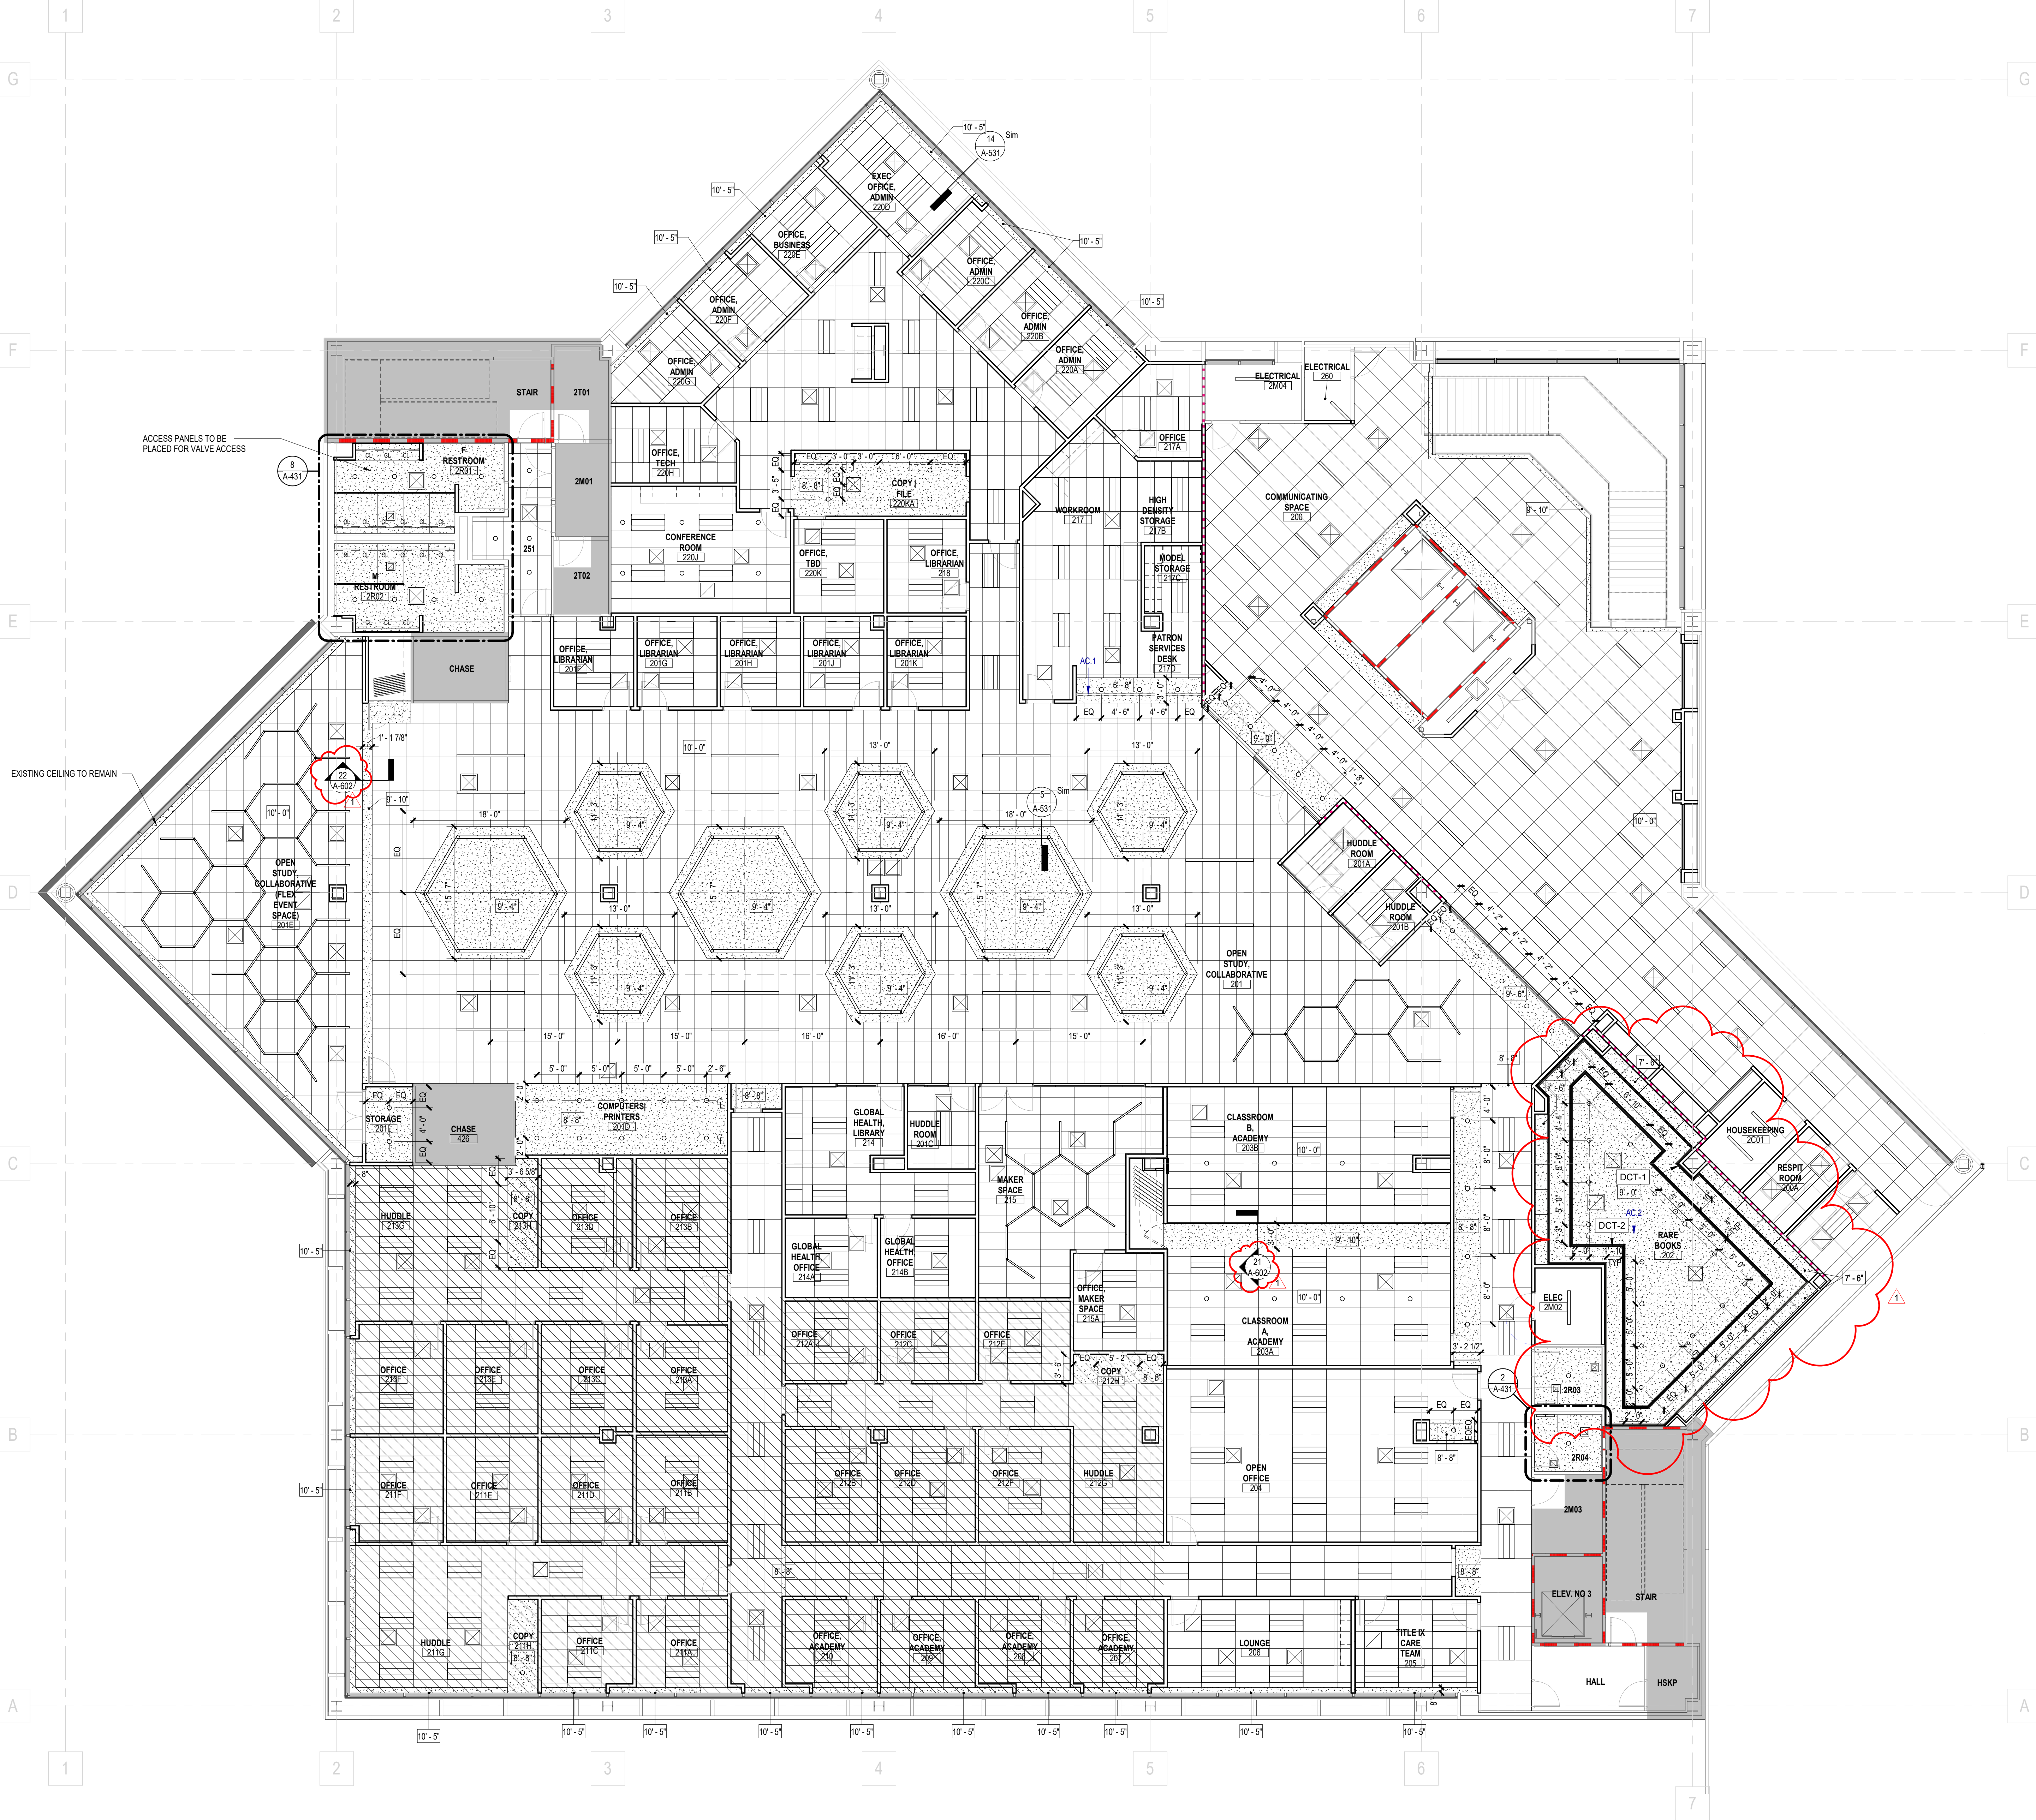

1 ARCHITECTURAL - OVERALL REFLECTED CEILING PLAN - LEVEL 02
SCALE: 1/8" = 1'-0"

CEILING PLAN GENERAL NOTES

1. ALL CEILING HEIGHTS IN "CORRIDORS/HALLS" SHALL BE 9'-0" AFF UNLESS NOTED OTHERWISE.
2. ALL ACOUSTICAL CEILING GRIDS TO BE CENTERED WITHIN ROOM UNLESS NOTED OTHERWISE.
3. ALL CORRIDOR ACOUSTICAL CEILING GRIDS TO BE CENTERED WITHIN THE CORRIDOR, UNLESS NOTED OTHERWISE.
4. ALL 'CAN' LIGHT FIXTURES TO BE CENTERED WITHIN ACOUSTICAL CEILING TILES.
5. ALL 'CAN' LIGHT FIXTURES IN TOILET ROOMS TO BE CENTERED.
6. ALL GYP. BOARD FURRED DOWN TO BE 7'-2" AFF; REFER TO A-2 SERIES FOR INTERIOR ELEVATIONS UNLESS NOTED OTHERWISE.
7. ALL CEILING HEIGHTS IN "TOILET ROOMS" SHALL BE 9'-0" AFF UNLESS NOTED OTHERWISE.
8. ALL CEILING HEIGHTS NOT MARKED SHALL BE 9'-0" AFF.
9. ALL DIFFUSERS AND AIR GRILLES SHALL BE PAINTED TO MATCH THE WALL OR CEILING THEY ARE INSTALLED IN U.N.O.


KEYED NOTES

NUMBER	DESCRIPTION
AC-1	MANUAL ROLL UP SECURITY GRILL, AS SPECIFIED.
AC-2	A NEW RTU TO SUPPORT THE RARE BOOKS ROOM IS PLANNED AT THE EXISTING ROOM. REF. MECHANICAL DRAWINGS. STRUCTURAL STEEL FRAMING IS ANTICIPATED TO ACCOMMODATE REQUIRED ROOF PENETRATIONS AND THE RTU MECHANICAL CURB (BY MFR, REF MECH).

CEILING PLAN LEGEND

SYMBOL	DESCRIPTION
	24"x24" LIGHT FIXTURE
	48"x24" LIGHT FIXTURE
	48"x12" LIGHT FIXTURE
	ACCESS PANEL
	SUPPLY
	RETURN
	EXHAUST
	SLOT DIFFUSER
	PENDANT DOWNLIGHT (CORRIDORS & RECEPTION DESKS)
	DOWNLIGHT
	STRIP LIGHT
	WALL MOUNTED FIXTURE
	COVE LIGHT
	UNDERCABINET LIGHT
	2"x2" ACOUSTIC CEILING TILE
	GYPSUM CEILING
	WOOD LAMINATE CEILING
	WOOD SLAT CEILING
	RECLAIMED WOOD CEILING
	EXPOSED TO DECK
	NOT IN CONTRACT (NIC)
	NURSE CALL LIGHT
	24"x48" 3in1 FLUORESCENT LIGHT FIXTURE

KEY PLAN (NOT TO SCALE)

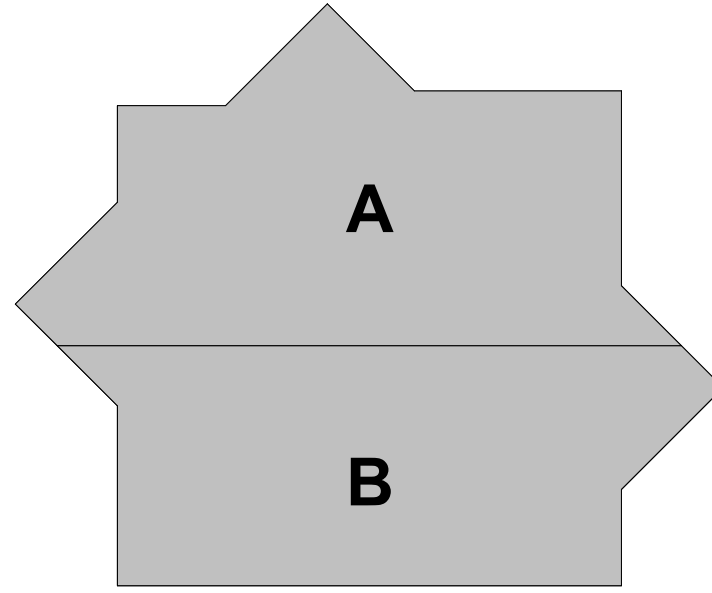

TTUHSC Preston Smith Library Renovation - Level 01 / 02 3601 4th Street, STOP 7781 Lubbock, TX 79430-7781

REVISION HISTORY

REVISION	DESCRIPTION	DATE
1	ADDENDUM 02	10 APR 2025

PROFESSIONAL SEALS



ARCHITECTURAL - REFLECTED CEILING PLAN - LEVEL 02

DRAWN BY	CHECKED BY
TEAM	TEAM
PROJECT NUMBER 320026.05	PROJECT ABBREVIATION TTUHSC-PSL-02-01
ORIGINAL ISSUE DATE	DATE
ISSUE FOR CONSTRUCTION	21 MAR 2025



TTUHSC Preston Smith Library
Renovation - Level 01 / 02
3601 4th Street, STOP 7781
Lubbock, TX 79430-7781


REVISION HISTORY

1	ADDENDUM 02	10 APR 2025
REVISION	DESCRIPTION	DATE




ARCHITECTURAL - INTERIOR
ELEVATIONS


DRAWN BY	CHECKED BY	TEAM
PROJECT NUMBER	PROJECT ABBREVIATION	
320026.05	TTUHSC-PSL-02-01	
ORIGINAL ISSUE	DATE	
ISSUE FOR CONSTRUCTION	21 MAR 2025	

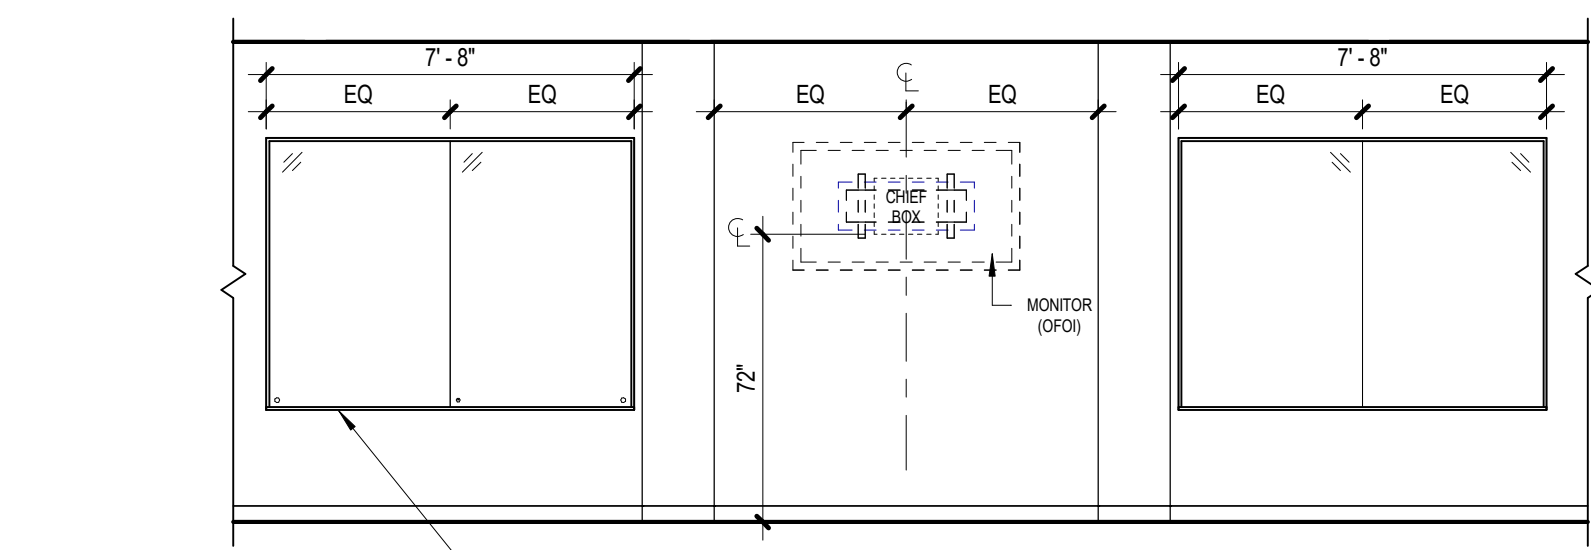


29 LEVEL 2 COMMUNICATING SPACE - DISPLAY CASE
SCALE: 1/4" = 1'-0"

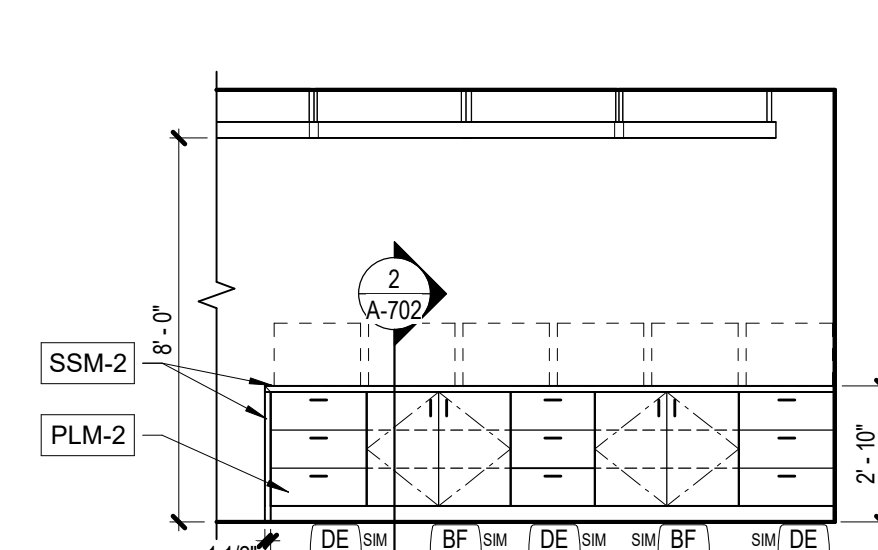


299 MAKER SPACE - NORTH
SCALE: 1/4" = 1'-0"

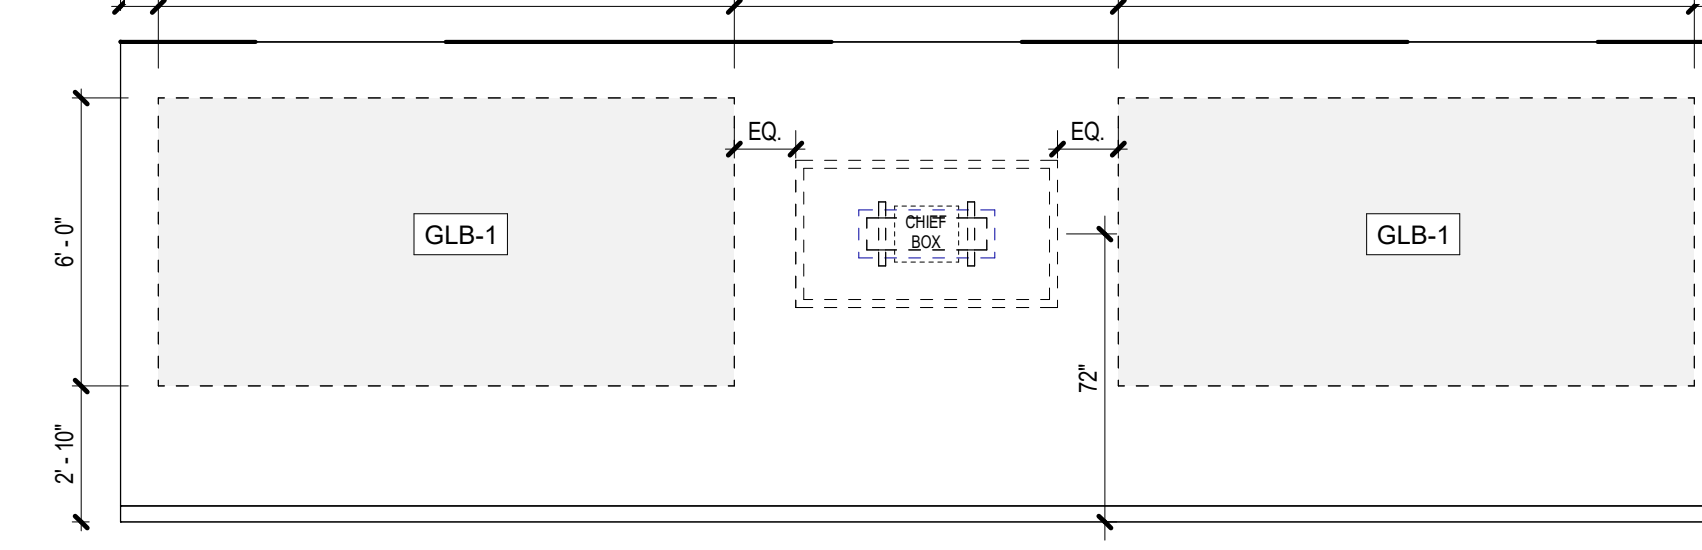


28 CLASSROOM B - NORTH
SCALE: 1/4" = 1'-0"

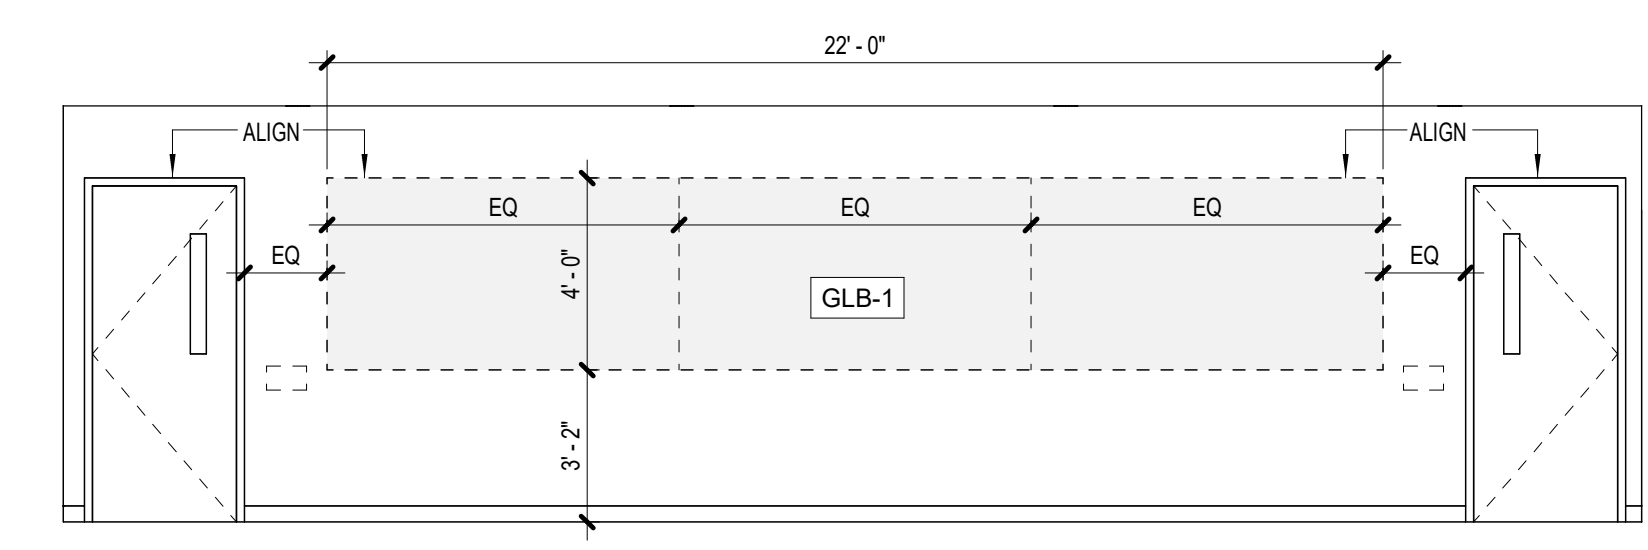


27 CLASSROOM WAITING, GLASS BOARD
SCALE: 1/4" = 1'-0"

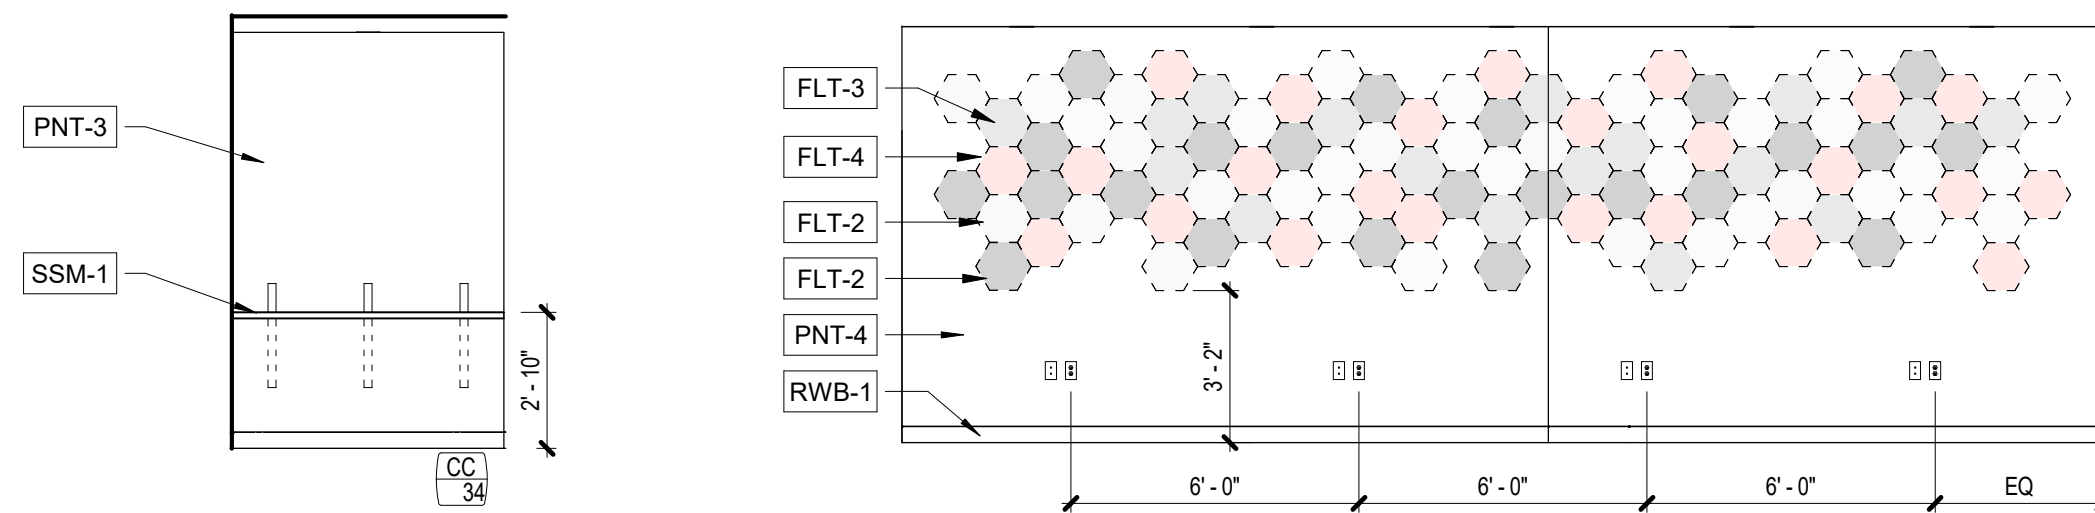


26 OPEN OFFICE - COUNTER
SCALE: 1/4" = 1'-0"

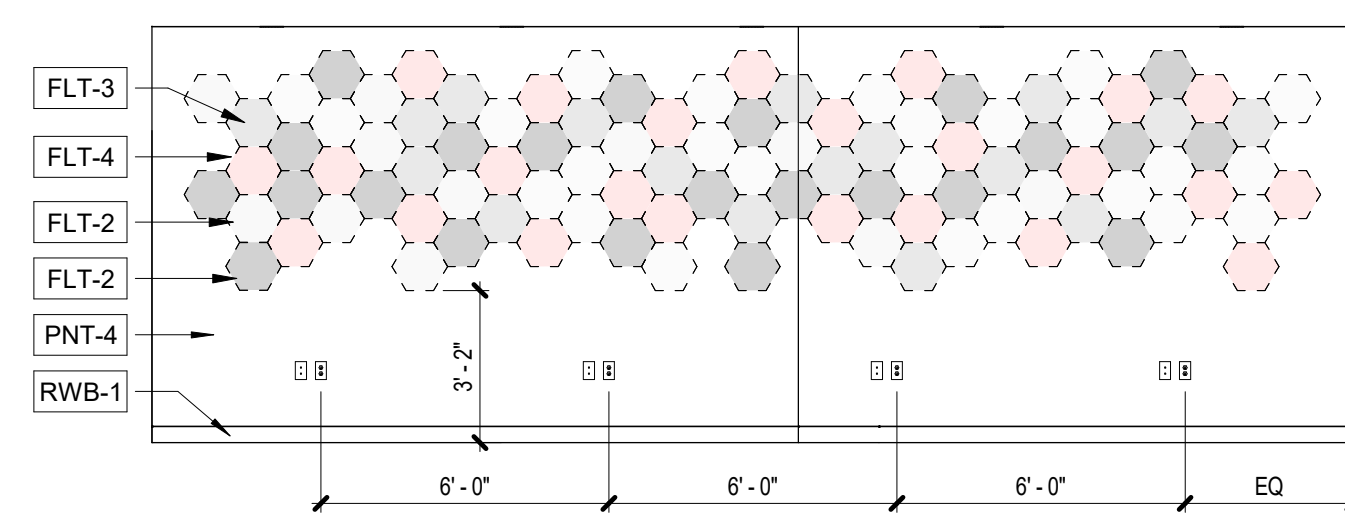


25 COMPUTER/PRINTER NICHE - FELT WALL
SCALE: 1/4" = 1'-0"

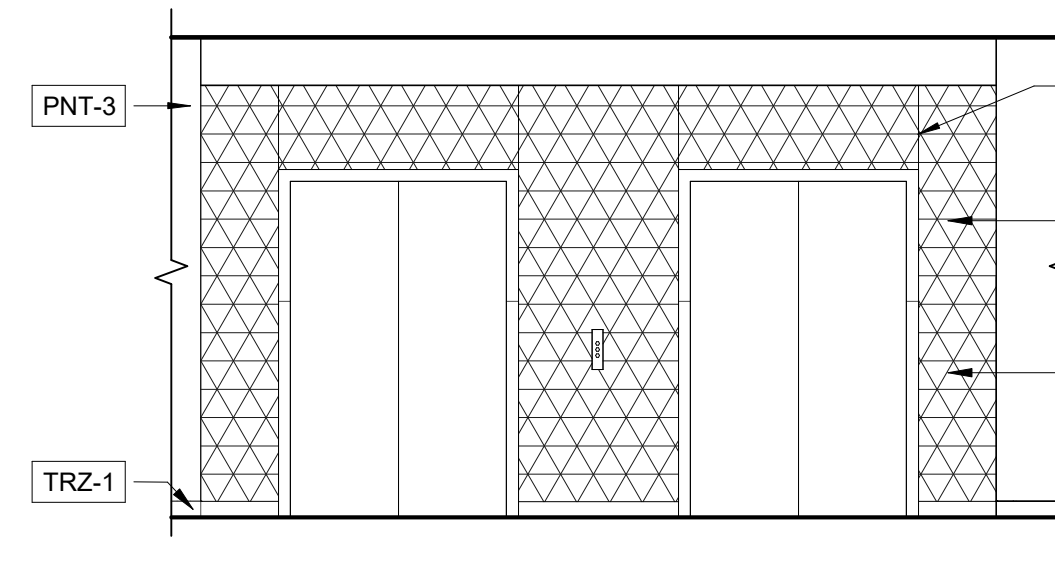


24 ELEVATOR DOORS
SCALE: 1/4" = 1'-0"

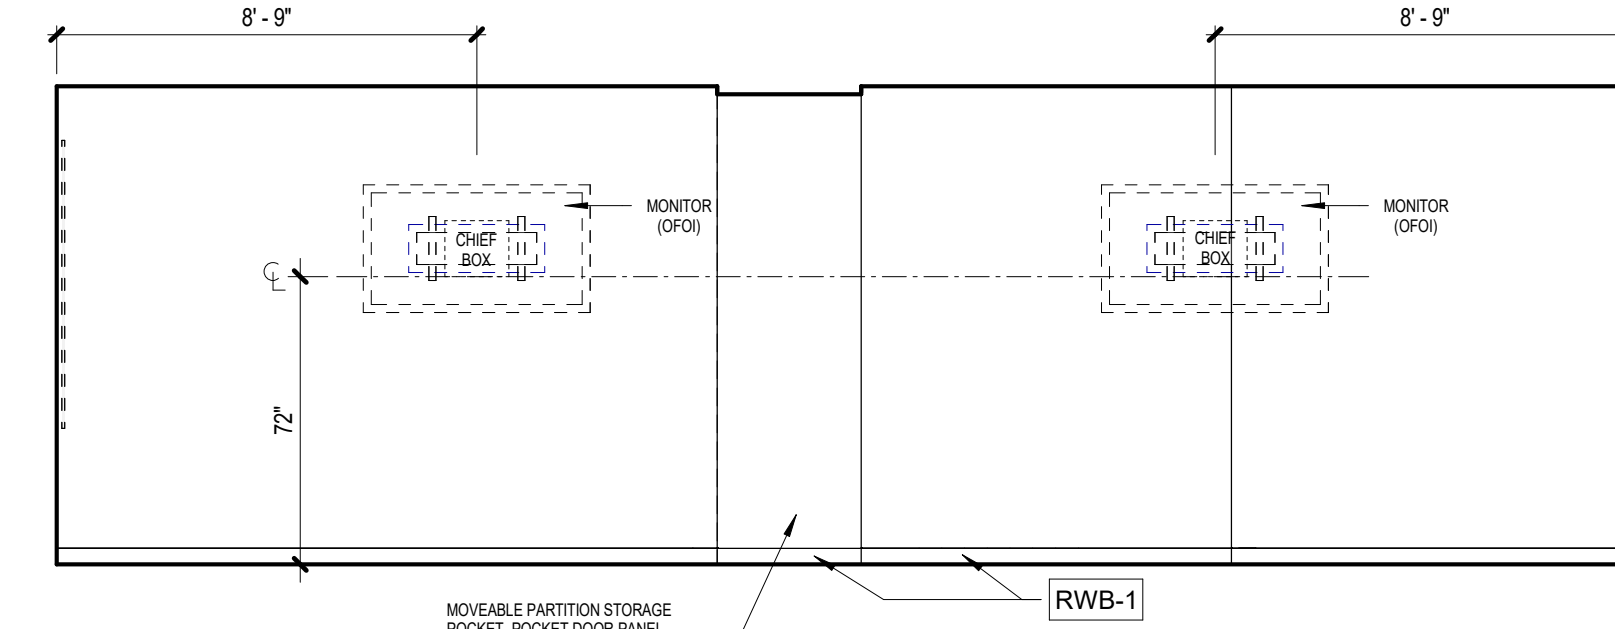


23 CLASSROOMS A & B - WEST
SCALE: 1/4" = 1'-0"

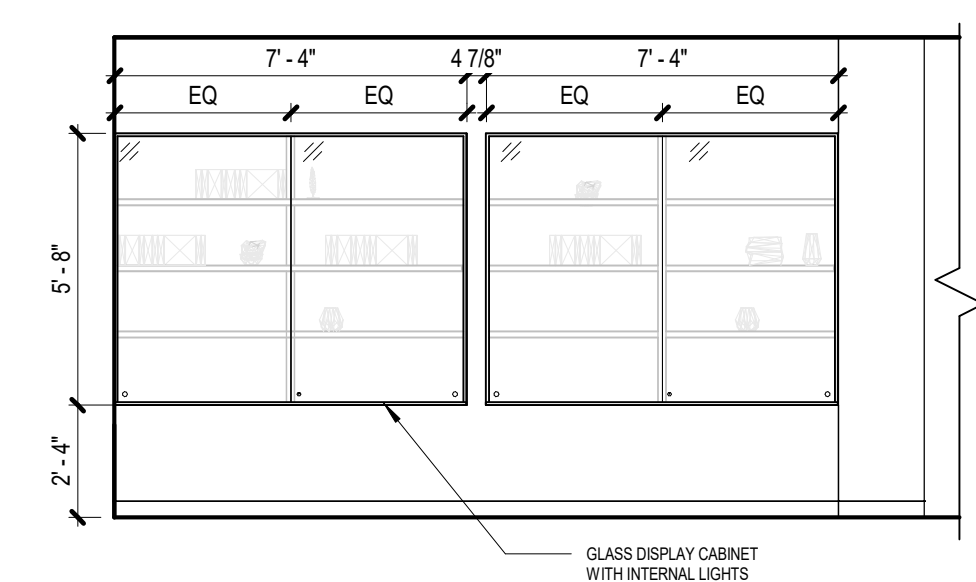


22 LEVEL 2 COMMUNICATING SPACE - DISPLAY CASE
SCALE: 1/4" = 1'-0"

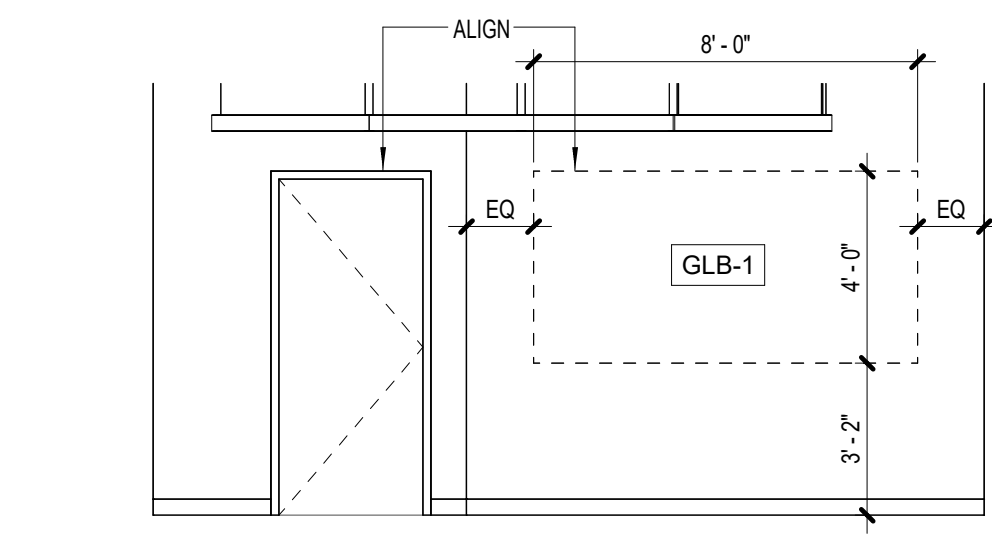


21 MAKER SPACE - SOUTH WALL
SCALE: 1/4" = 1'-0"

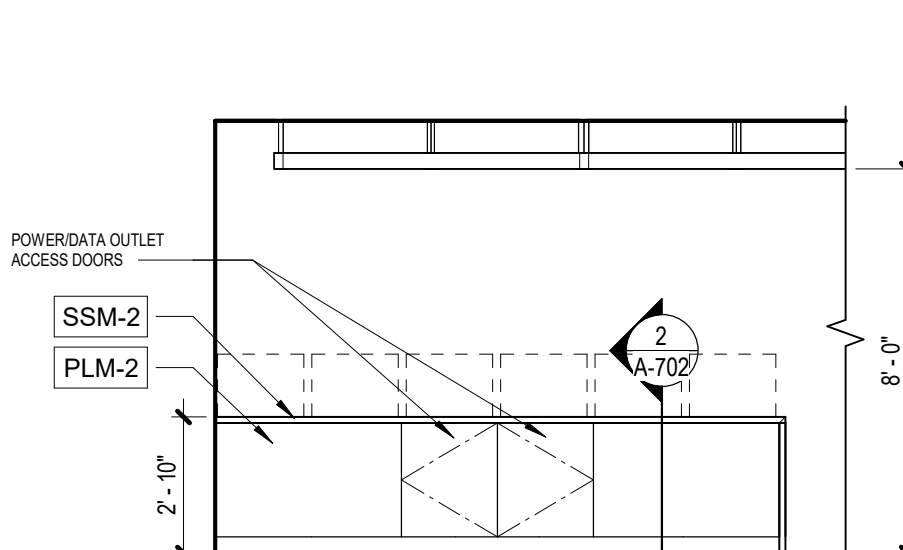


20 MAKER SPACE - SOUTH
SCALE: 1/4" = 1'-0"

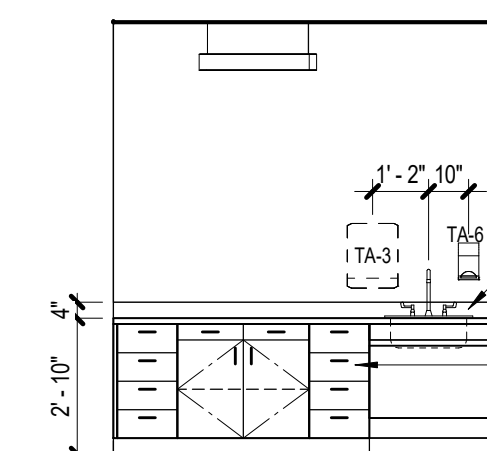


19 MAKER SPACE - EAST
SCALE: 1/4" = 1'-0"

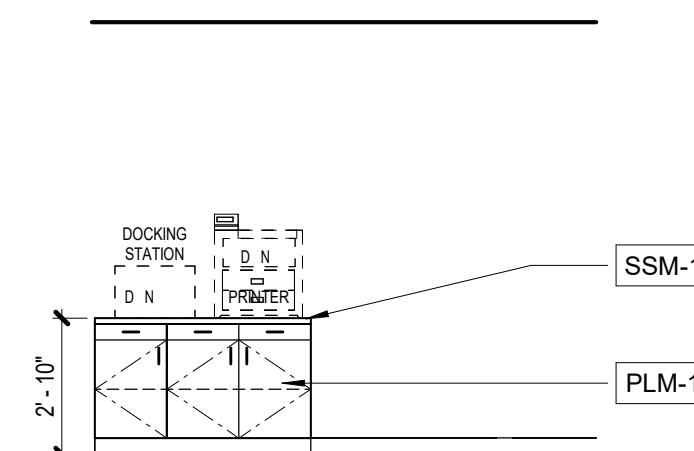


18 WORKROOM - EAST
SCALE: 1/4" = 1'-0"

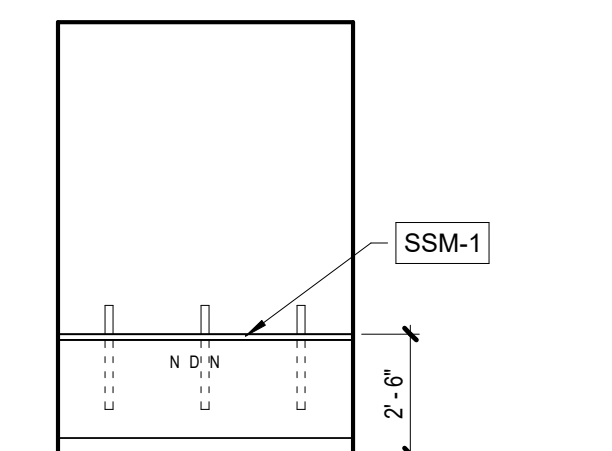


17 LIBRARY WORKSTATION
SCALE: 1/4" = 1'-0"

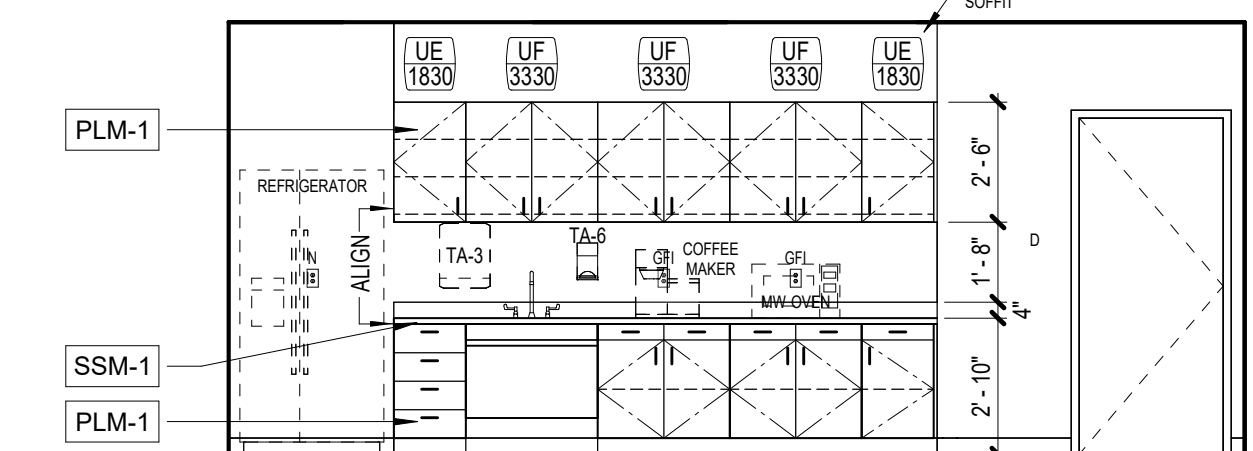


16 LIBRARY ADMIN CONFERENCE
SCALE: 1/4" = 1'-0"

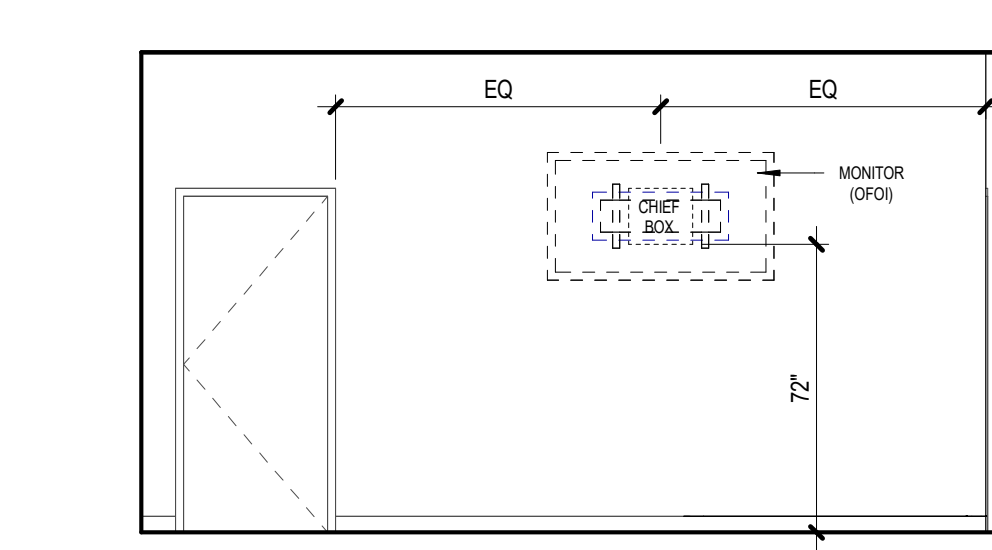


15 COMMUNICATION SPACE - NORTH
SCALE: 1/4" = 1'-0"

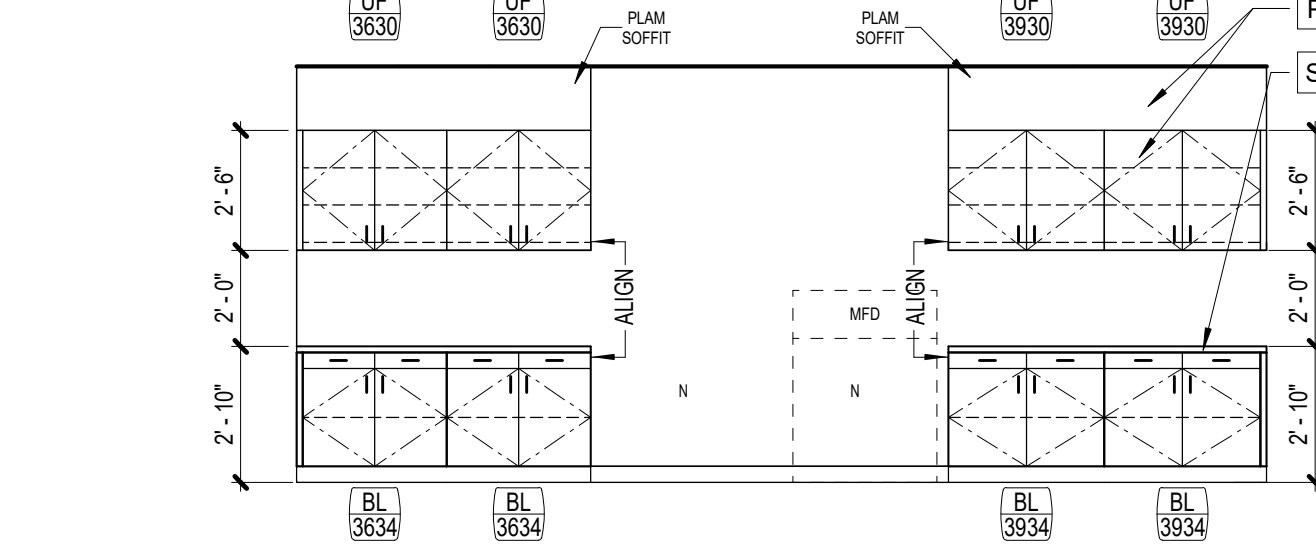


14 LIBRARY ADMIN COPY/FILE
SCALE: 1/4" = 1'-0"

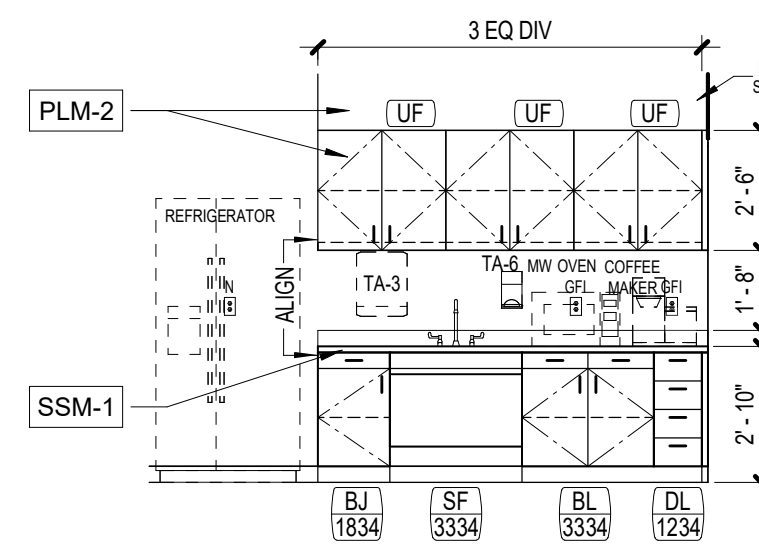


13 LIBRARY ADMIN WORKROOM - NORTHWEST
SCALE: 1/4" = 1'-0"

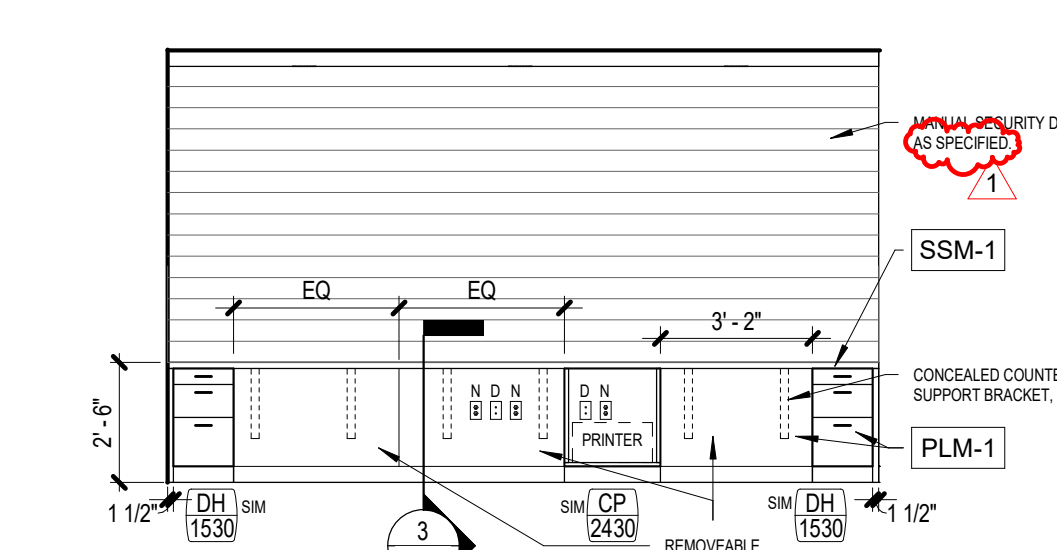


12 PATRON SERVICES - SOUTH
SCALE: 1/4" = 1'-0"

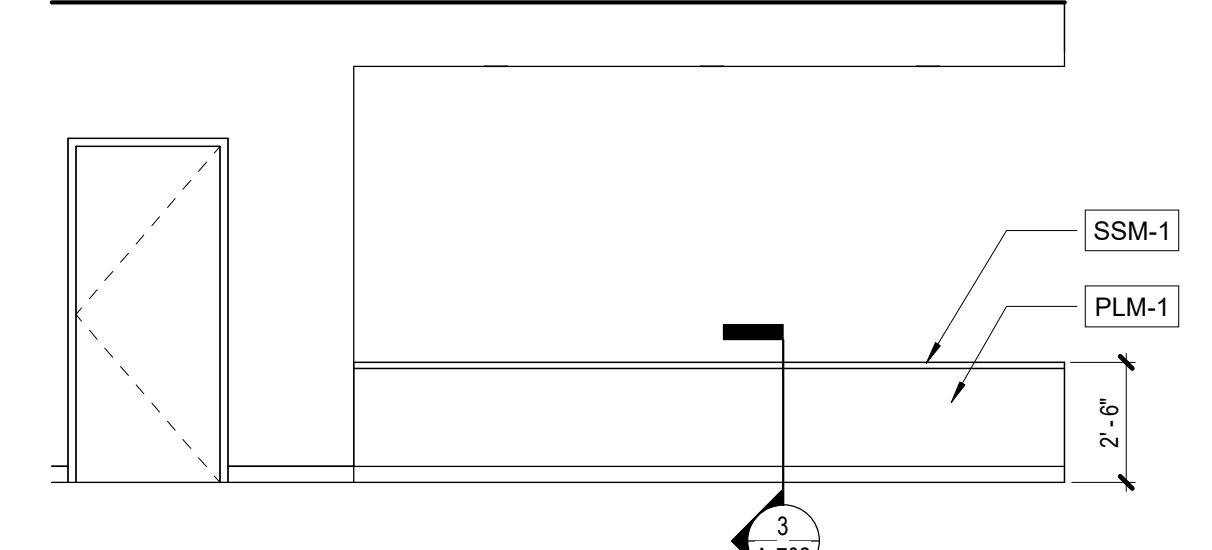


11 PATRON SERVICES - NORTH
SCALE: 1/4" = 1'-0"

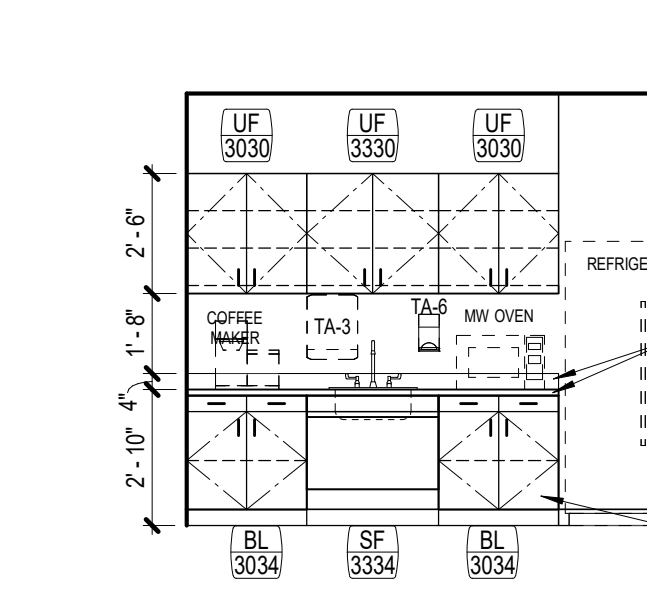


10 LEVEL 2 LOUNGE - EAST
SCALE: 1/4" = 1'-0"

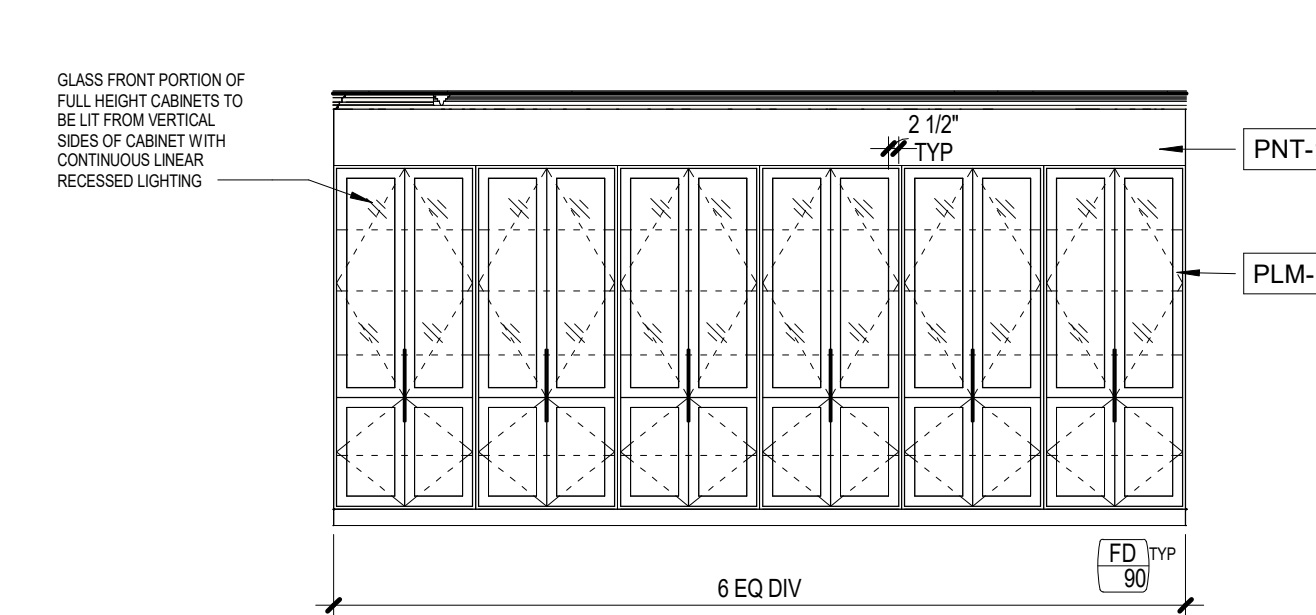


09 RARE BOOKS - WEST
SCALE: 1/4" = 1'-0"

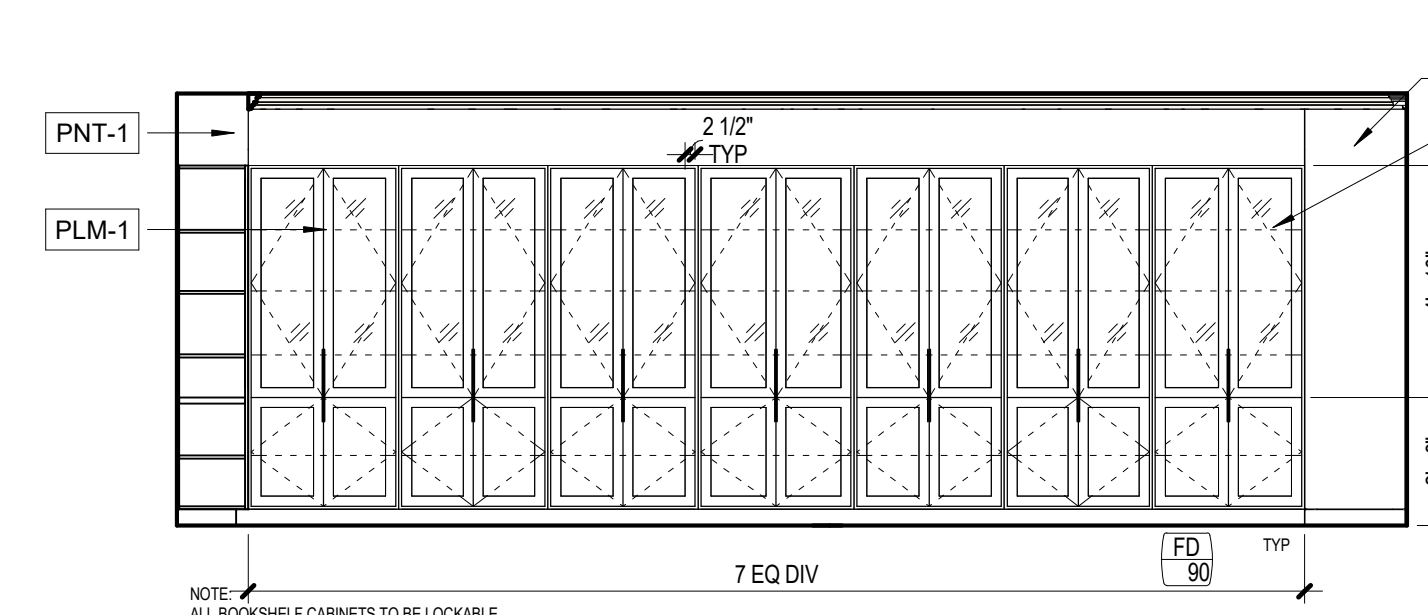


08 RARE BOOKS - SOUTHEAST
SCALE: 1/4" = 1'-0"

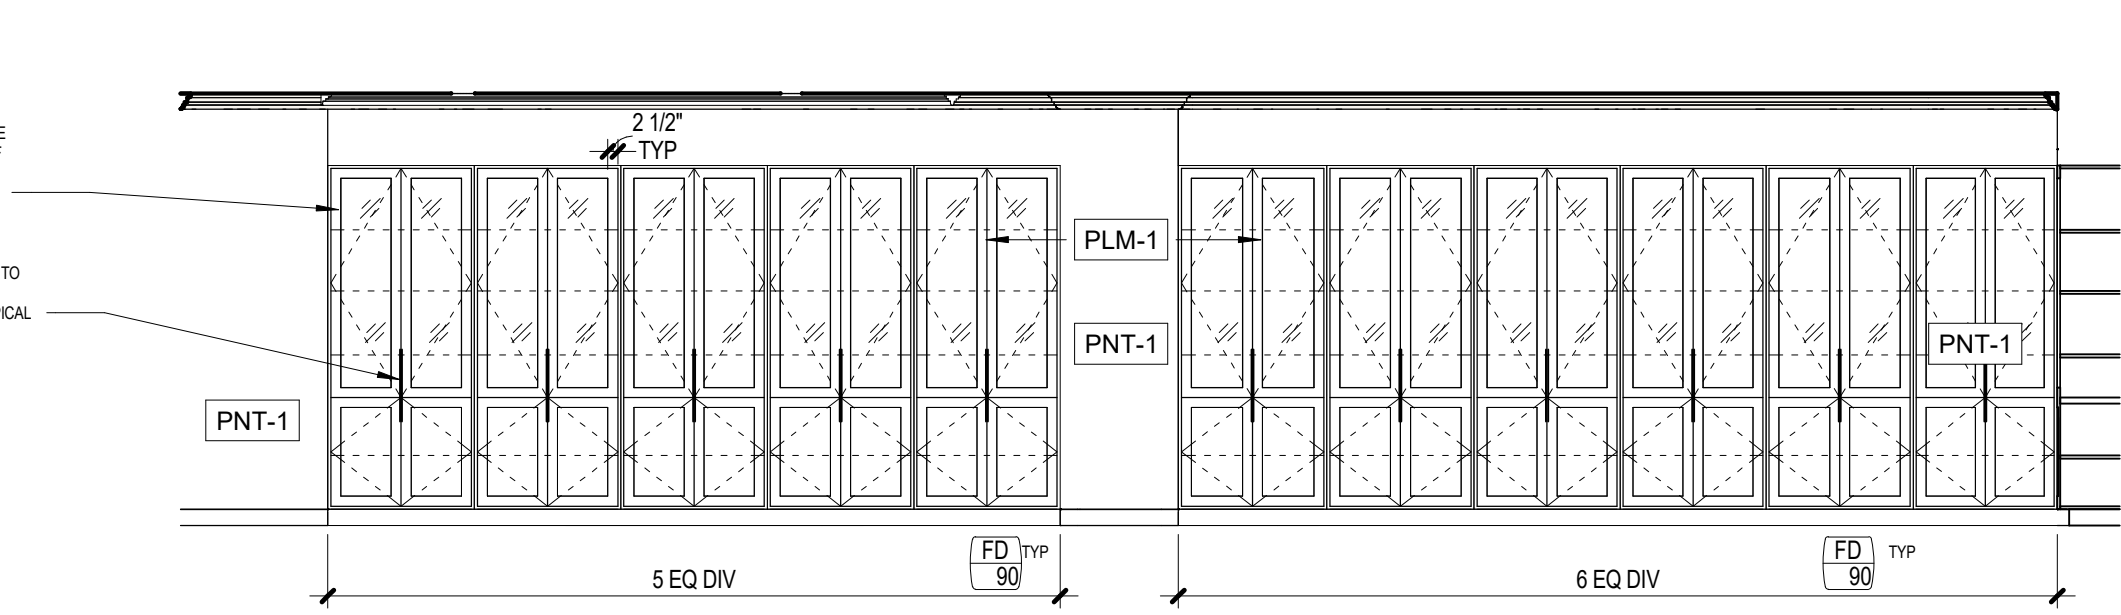


07 RARE BOOKS - NORTHEAST
SCALE: 1/4" = 1'-0"

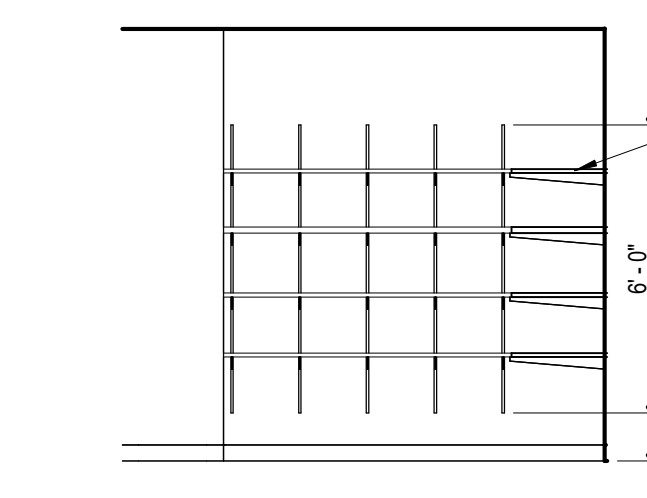


06 MODEL STORAGE - WEST
SCALE: 1/4" = 1'-0"

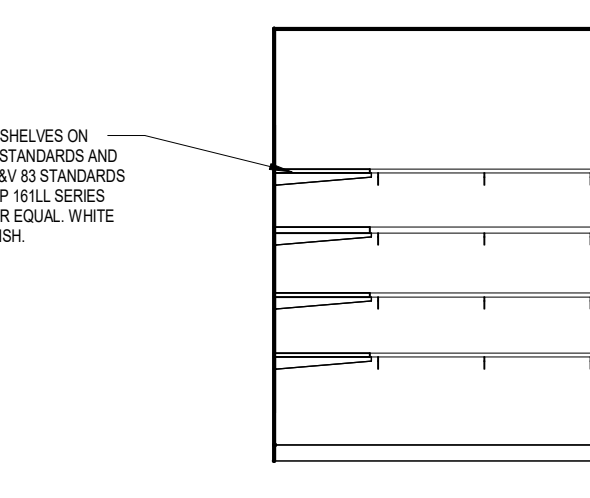


05 MODEL STORAGE - NORTH
SCALE: 1/4" = 1'-0"

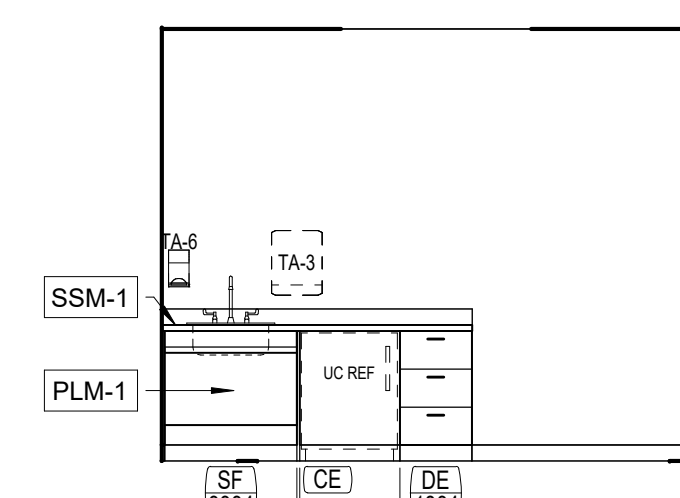


04 RESPIRATORY ROOM
SCALE: 1/4" = 1'-0"

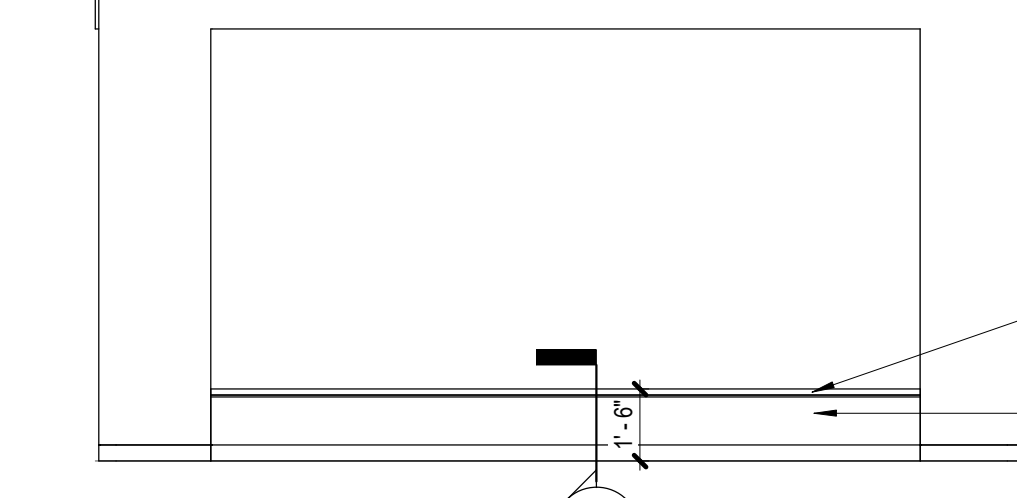

03 COMMUNICATING SPACE
SCALE: 1/4" = 1'-0"

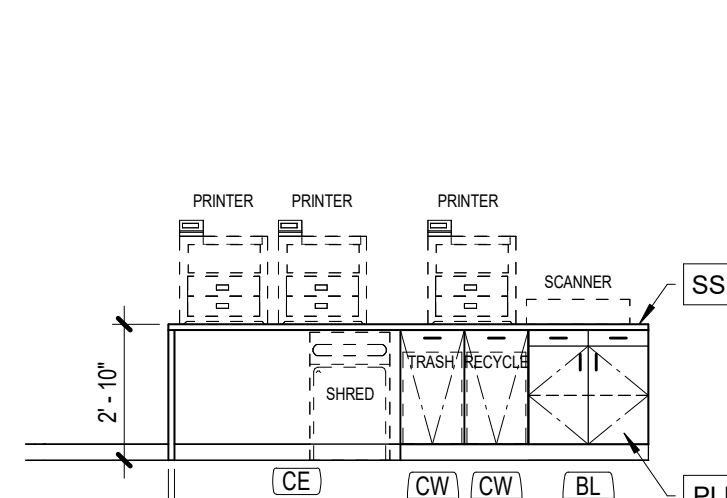


02 LIBRARY TECH - EAST
SCALE: 1/4" = 1'-0"

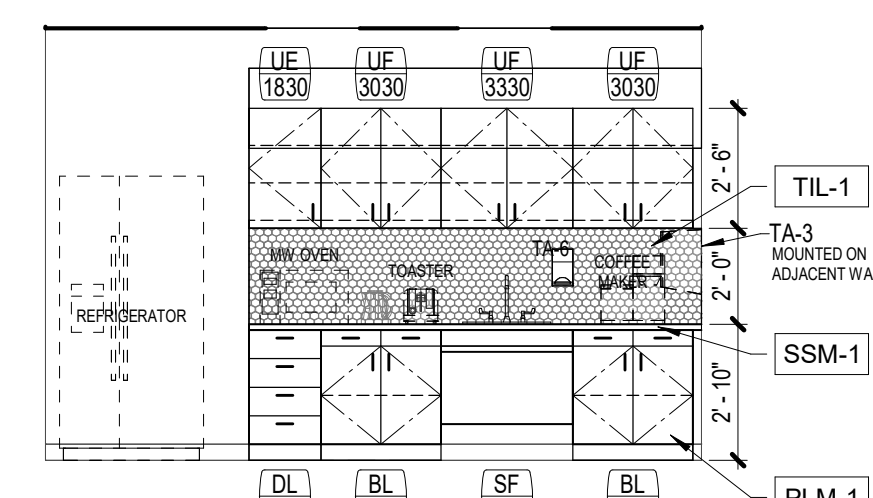


01 LIBRARY TECH LOUNGE - WEST
SCALE: 1/4" = 1'-0"


FILE PATH: Autodesks Docs/320026-TexasTech-HSC-L-PS-Library/320026-A-TTUHSC PSL-1VL 02-R24-CENTRAL.rvt
USER NAME: DATE/TIME: 4/8/2025 5:20:02 PM

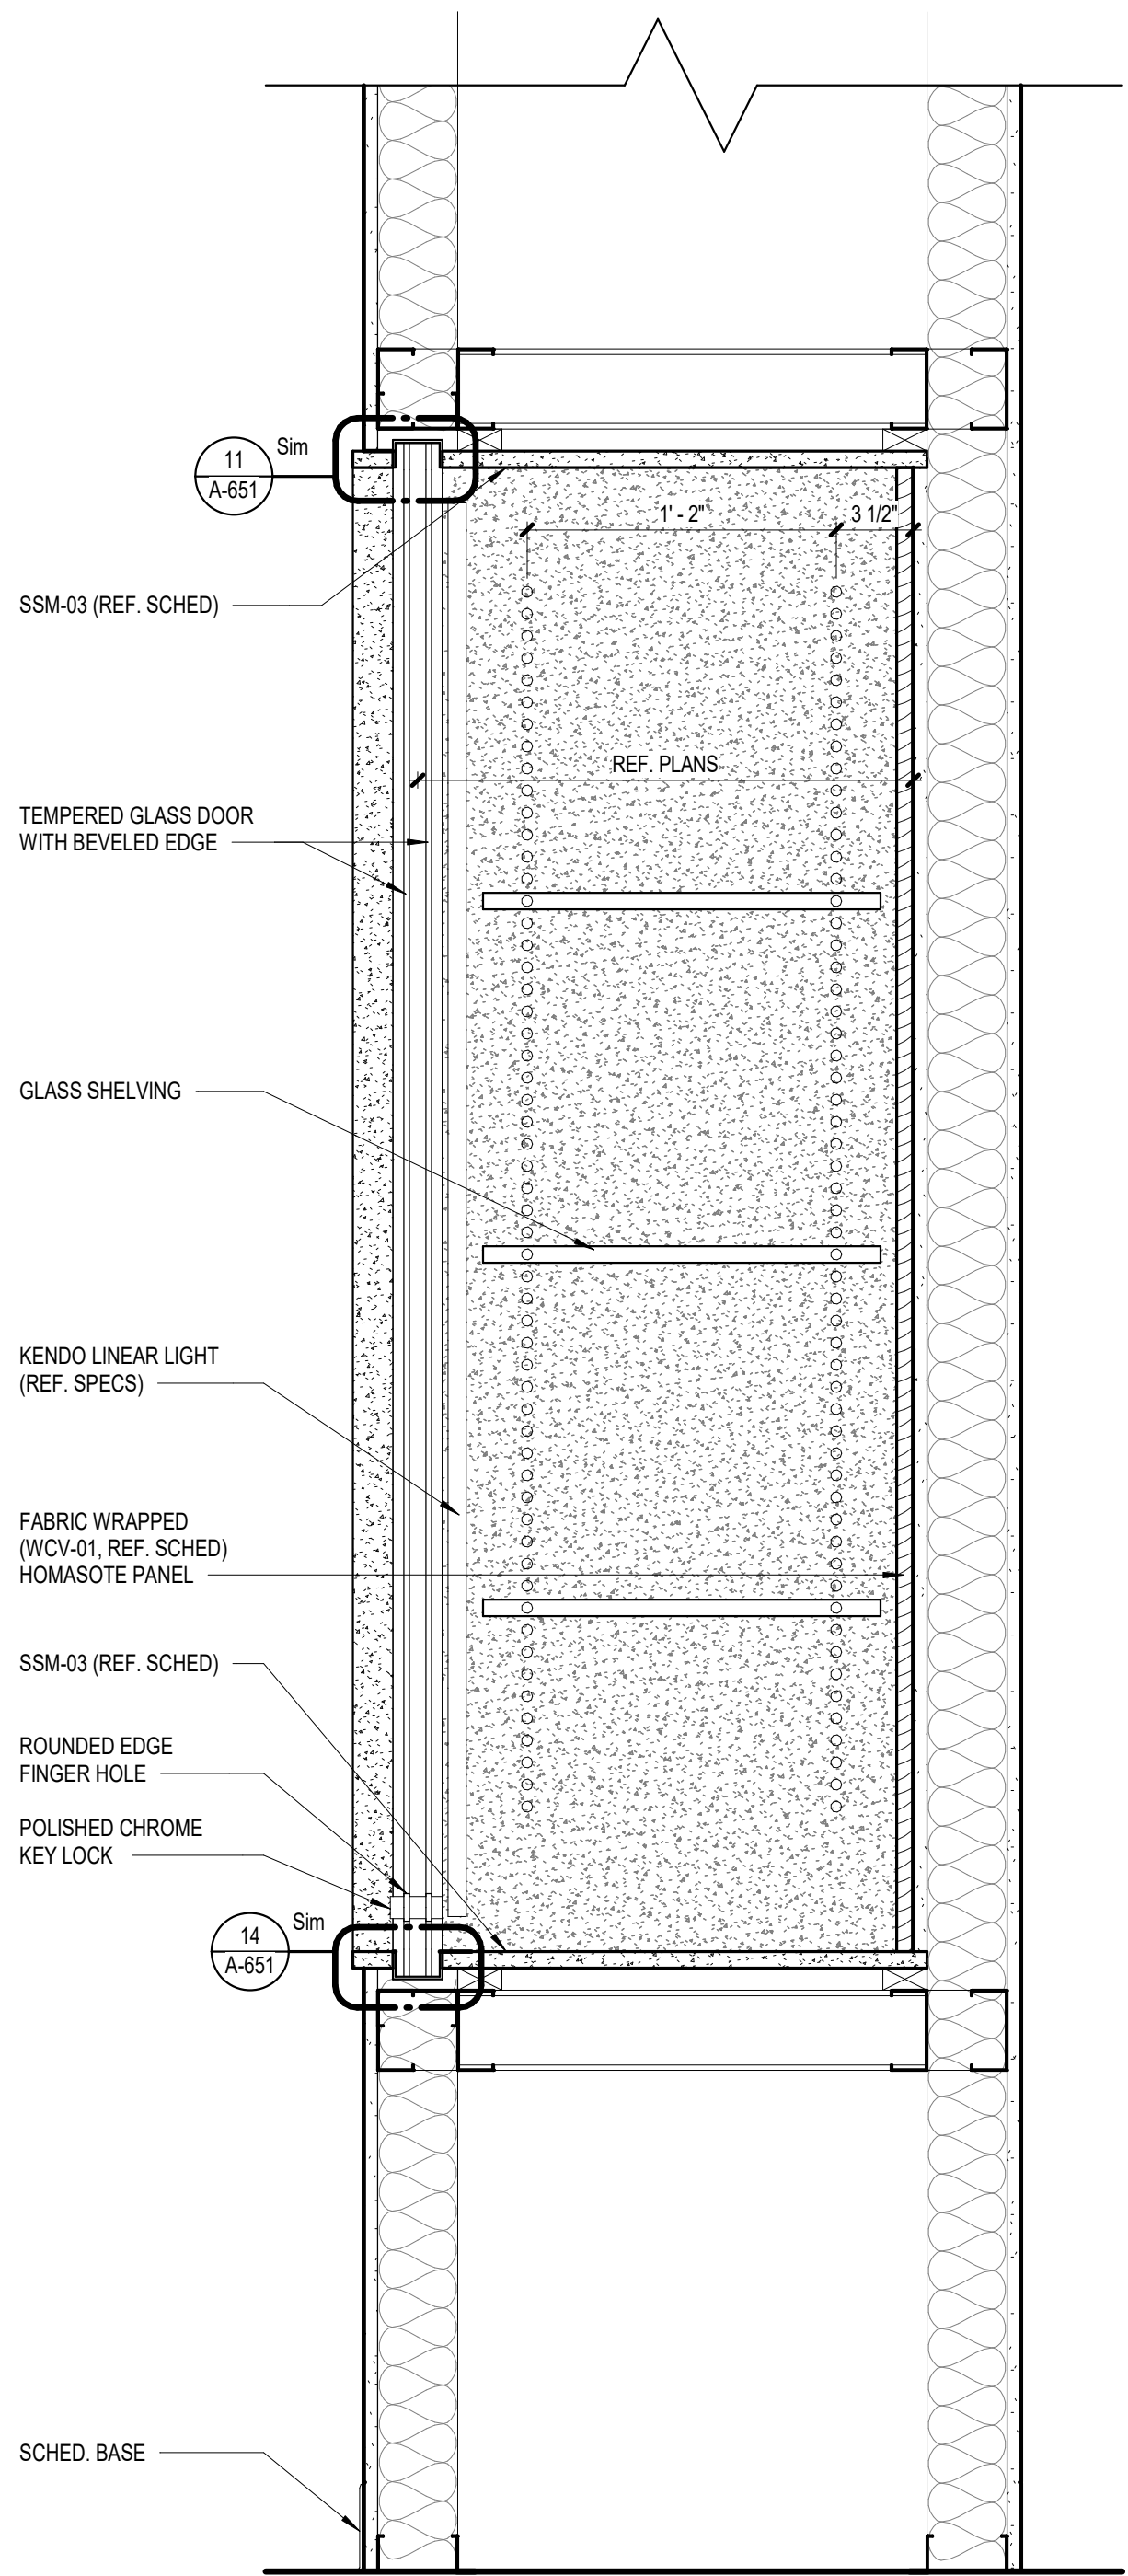


15 DISPLAY WALL SECTION
SCALE: 1 1/2" = 1'-0"

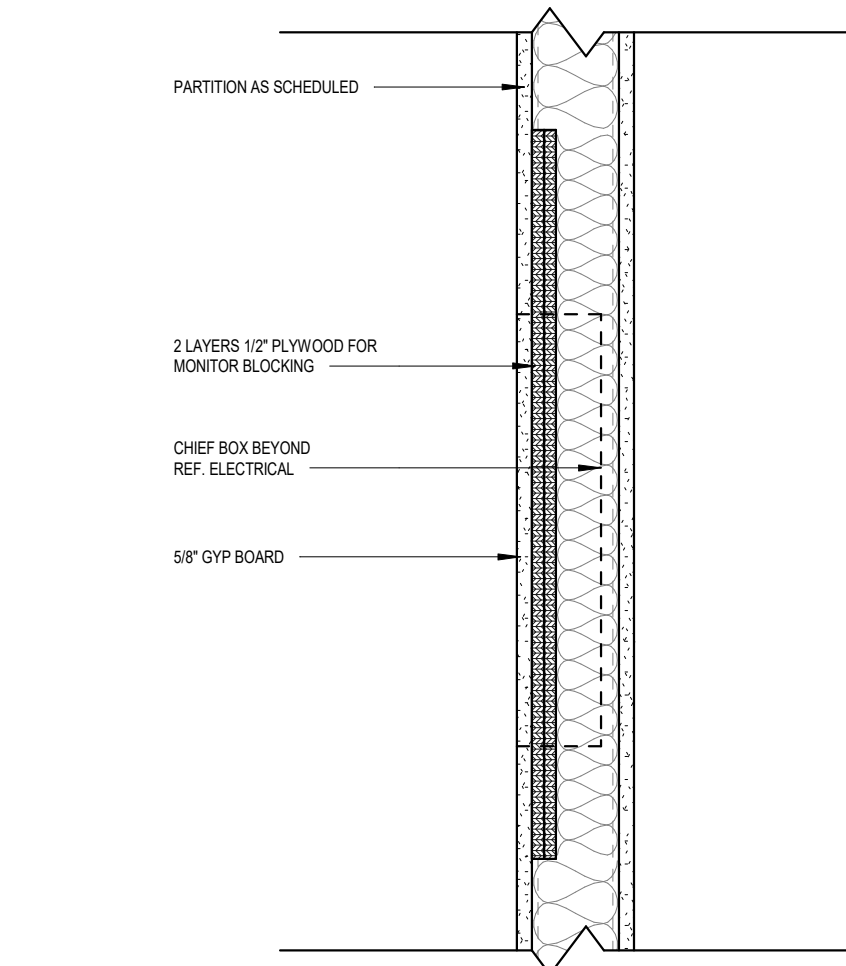


13 WALL BACKING
SCALE: 1 1/2" = 1'-0"

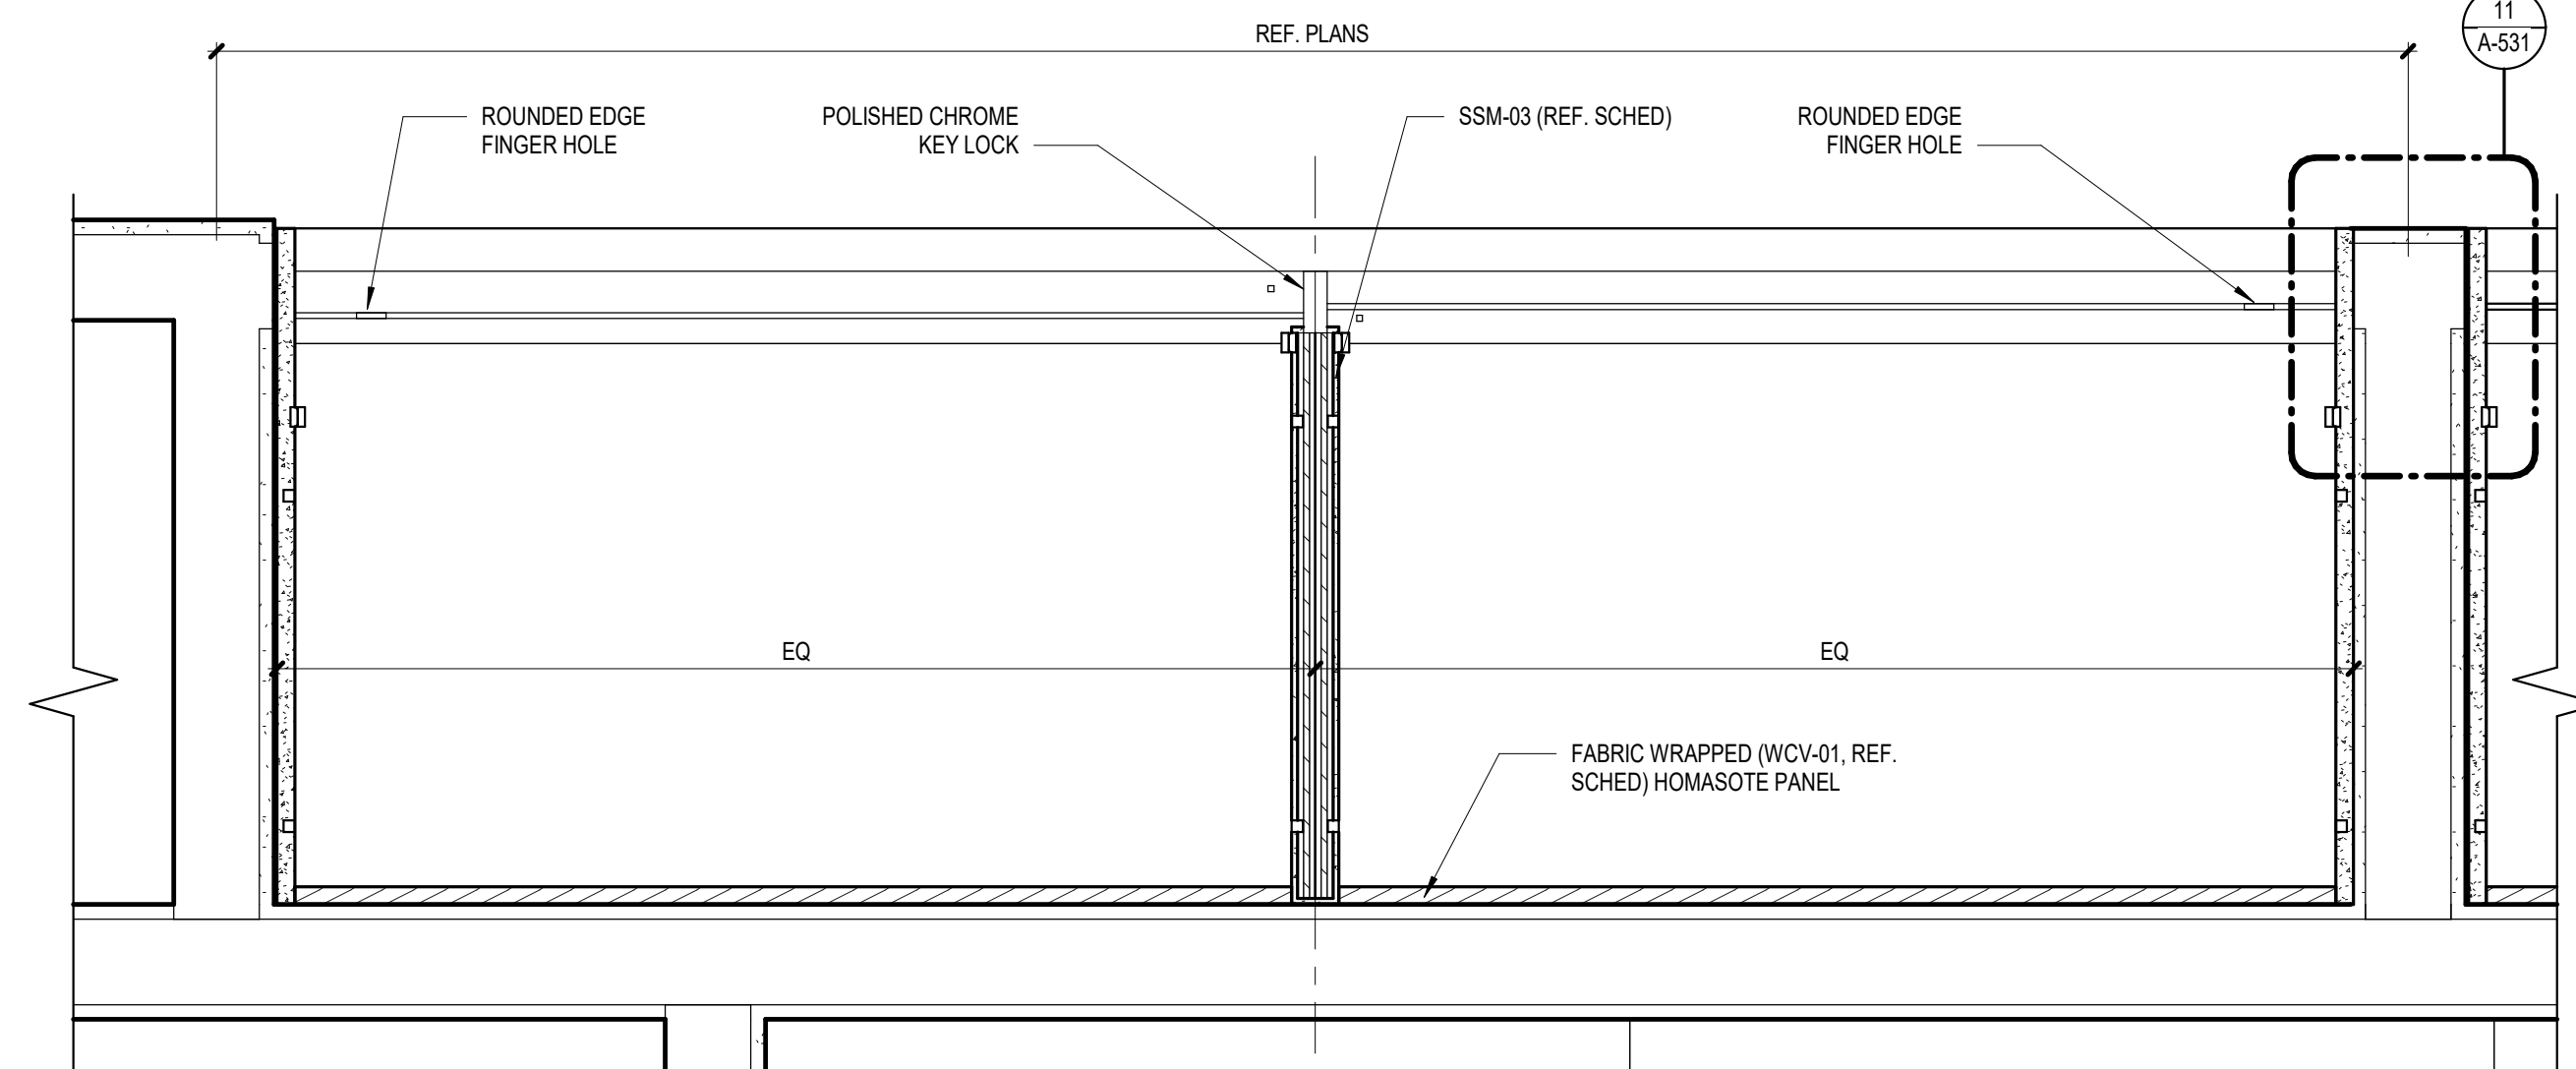


10 DISPLAY WALL ENLARGED VIEW
SCALE: 1 1/2" = 1'-0"

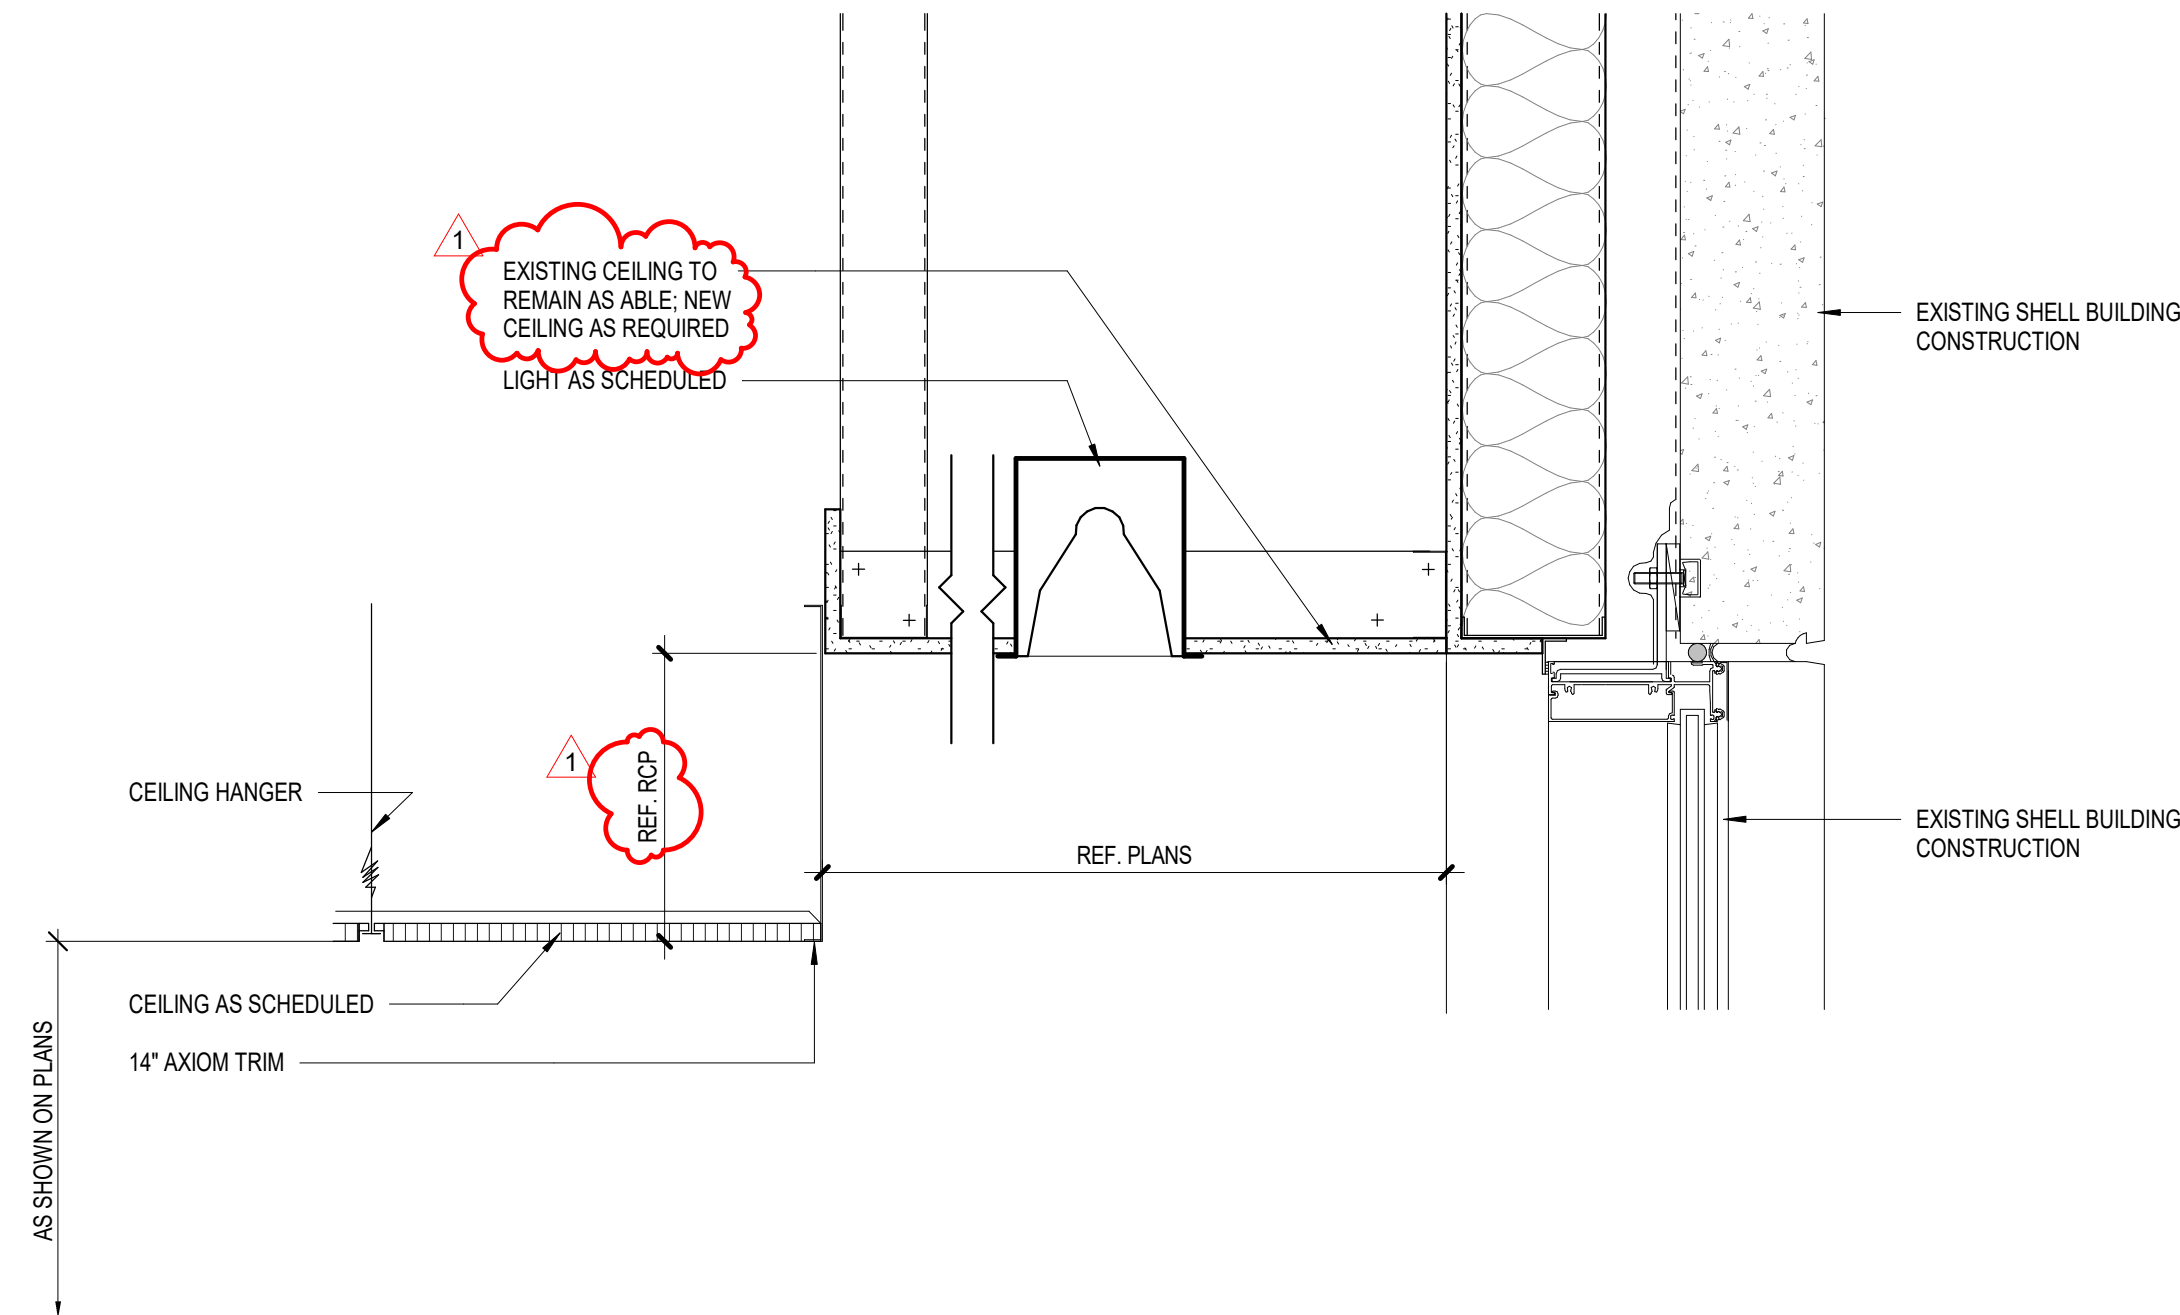


14 EXTERIOR WINDOW HEAD DETAIL
SCALE: 1 1/2" = 1'-0"

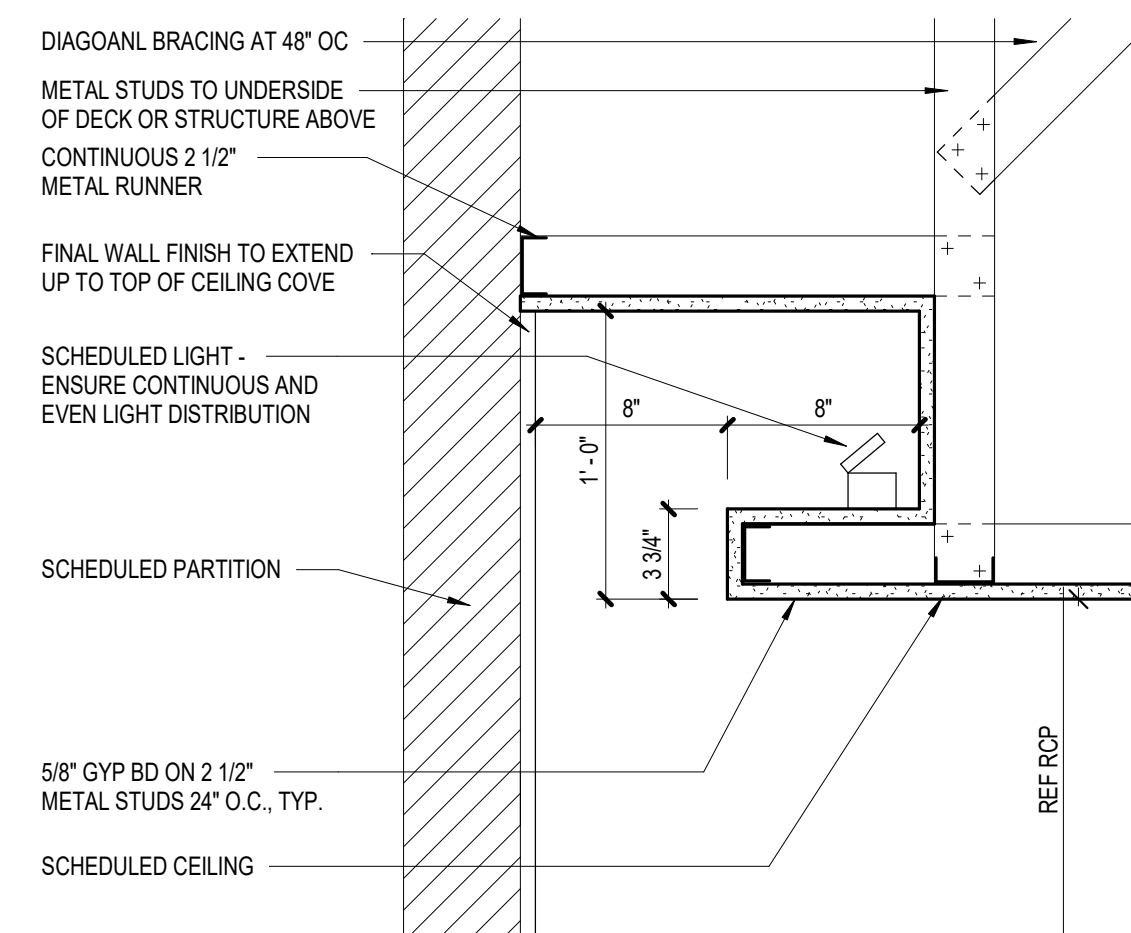


12 LIGHT COVE SECTION DETAIL
SCALE: 1 1/2" = 1'-0"

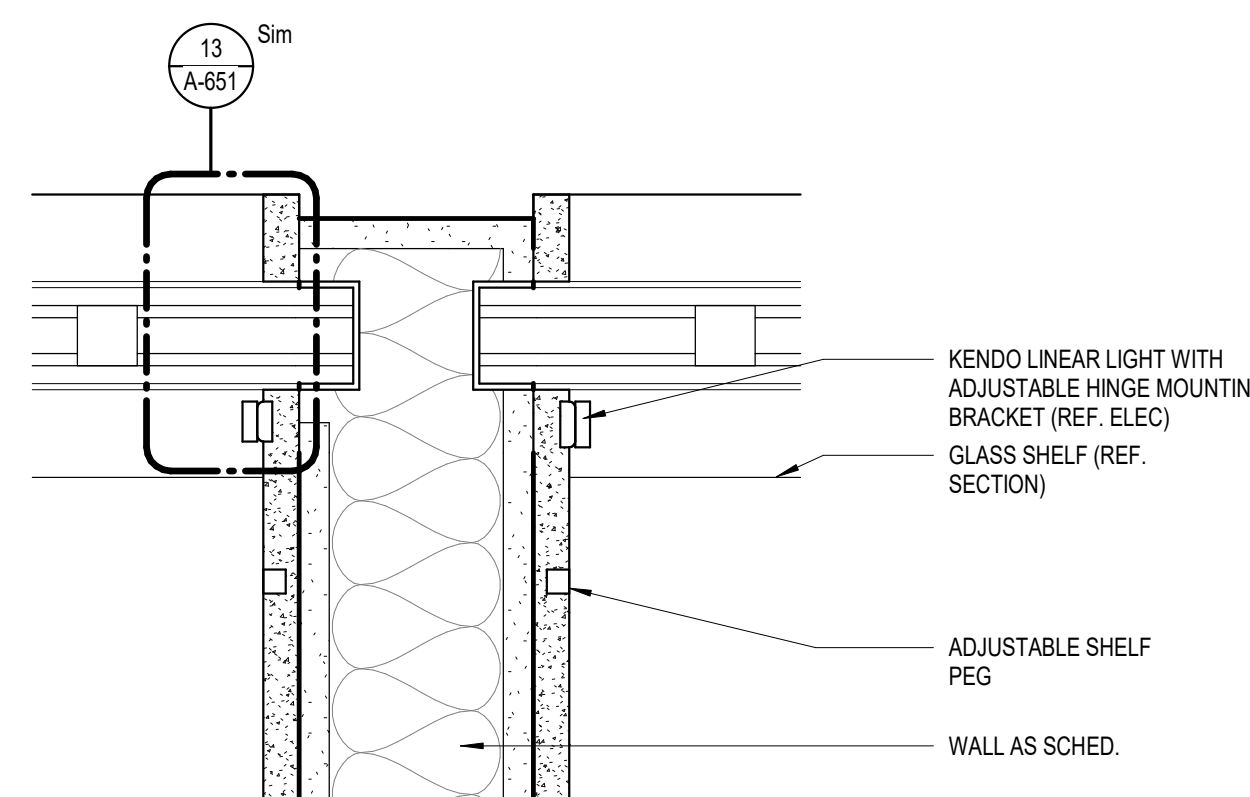


11 DISPLAY WALL DETAIL
SCALE: 3" = 1'-0"

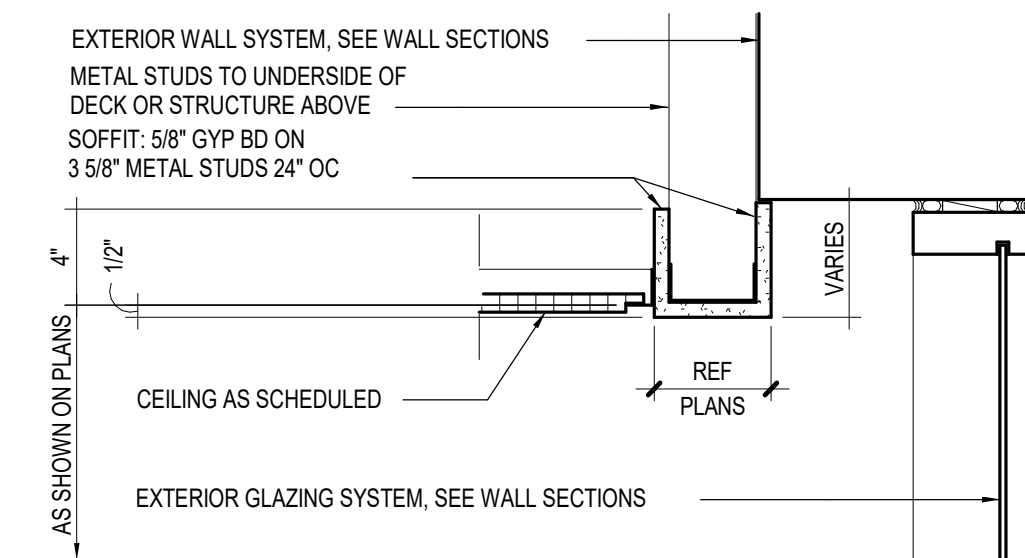


9 SOFFIT DETAIL
SCALE: 1 1/2" = 1'-0"

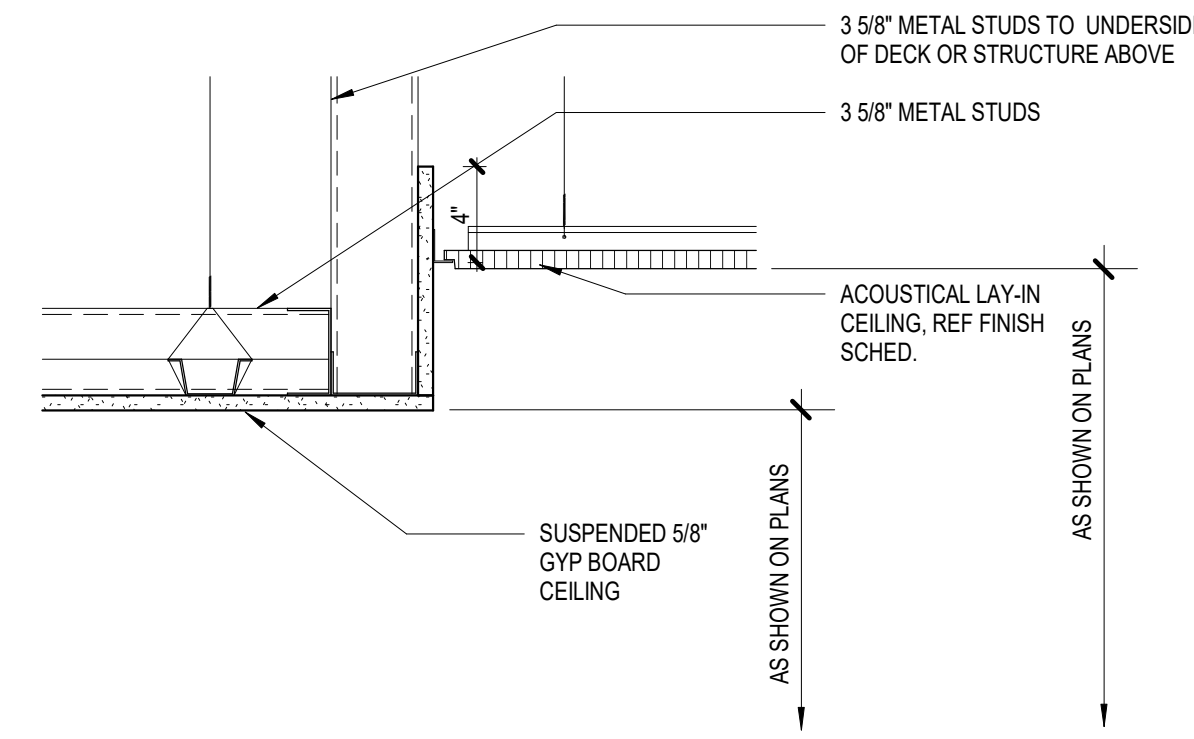


8 CEILING TRANSITION DETAIL
SCALE: 1 1/2" = 1'-0"

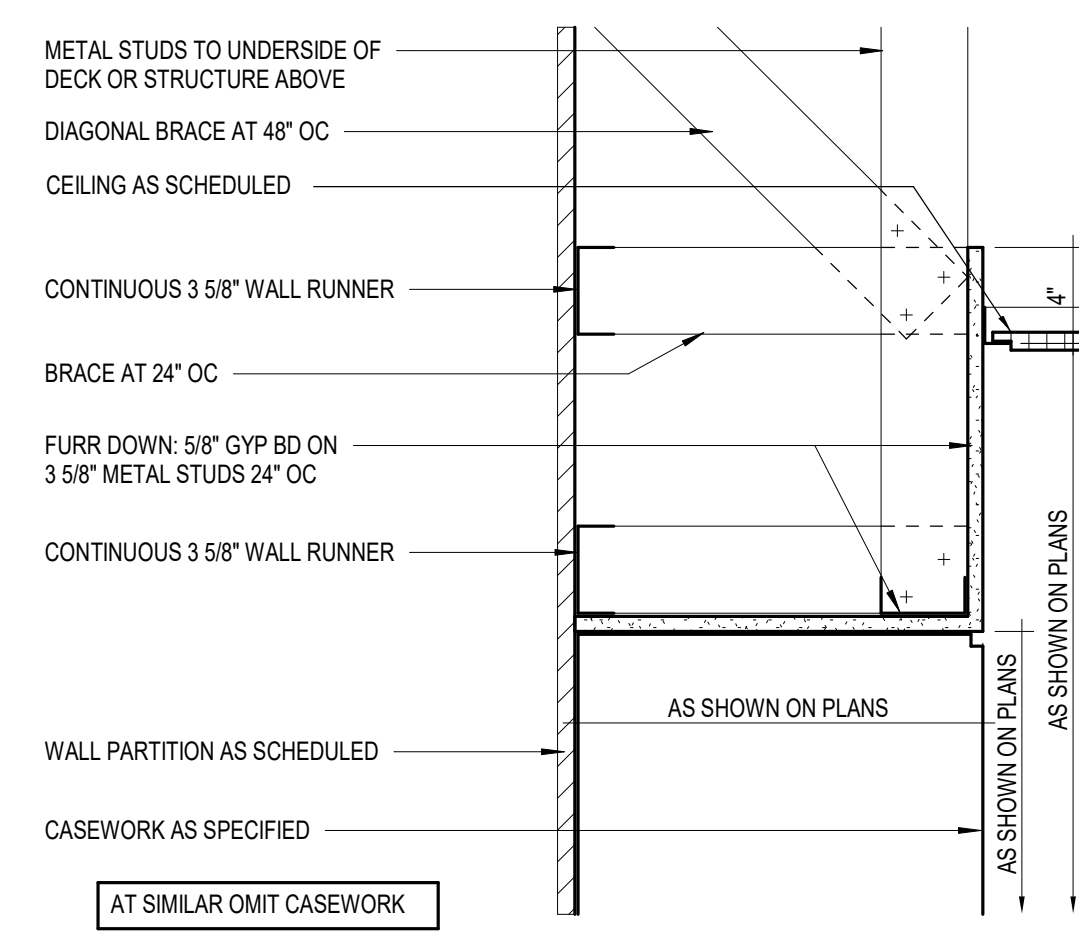

7 SOFFIT DETAIL
SCALE: 1 1/2" = 1'-0"

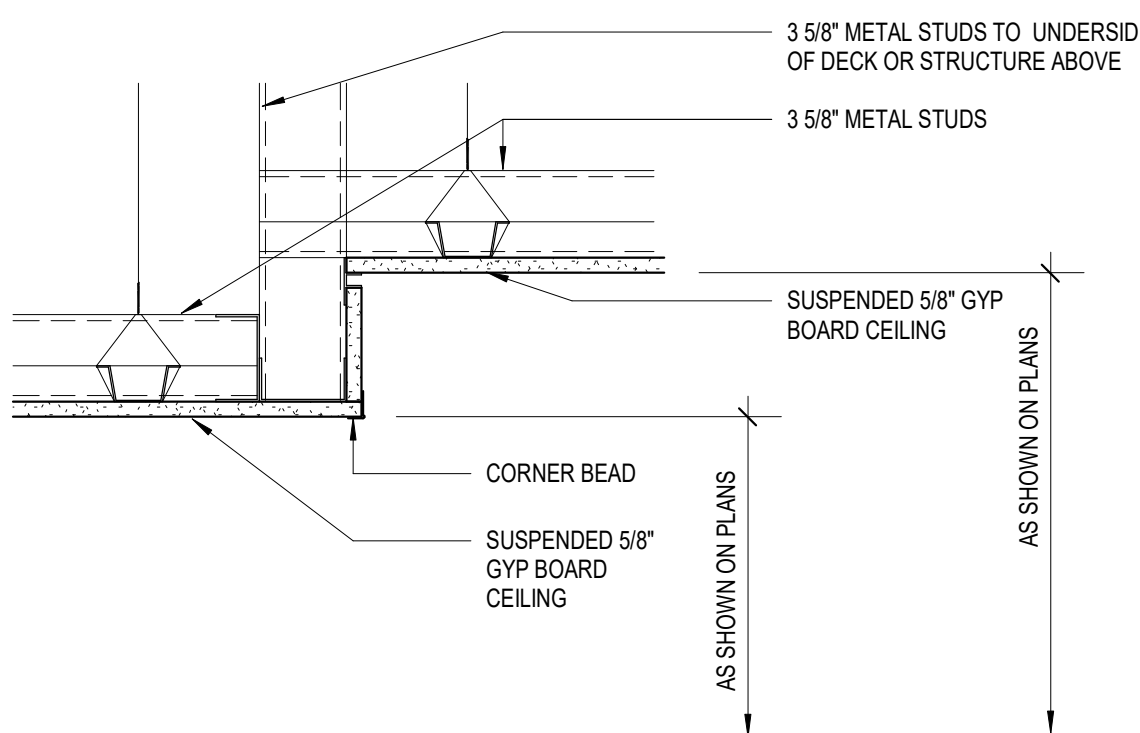


6 GYP CEILING TRANSITION DETAIL
SCALE: 1 1/2" = 1'-0"

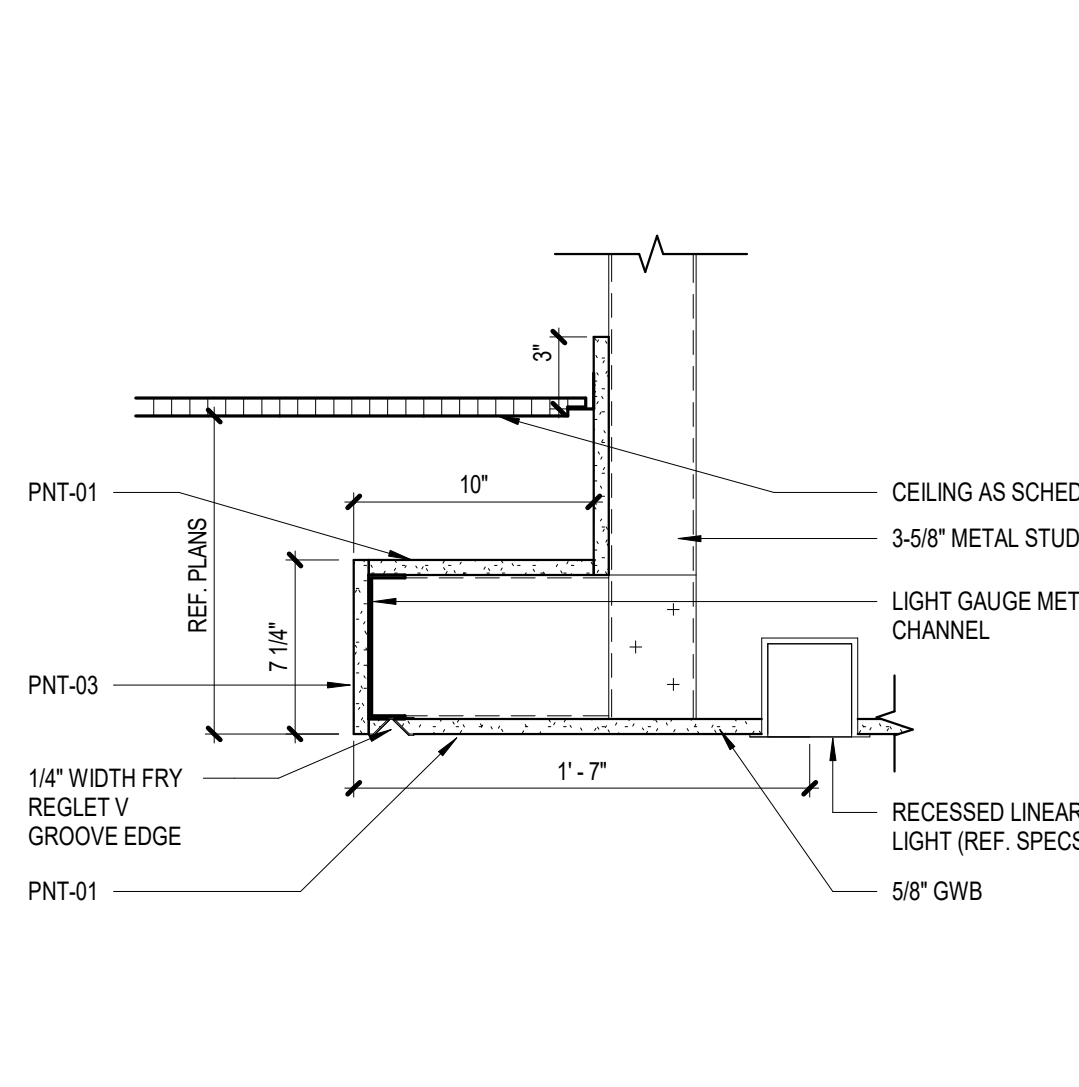


5 GYP CEILING CLOUD DETAIL
SCALE: 1 1/2" = 1'-0"


FLOOR PLAN LEGEND	
1.	SEE REFLECTED CEILING PLANS FOR CEILING HEIGHT AND TYPE.
2.	SEE FLOOR PLANS FOR PARTITION TYPES AND PARTITION SCHEDULE FOR PARTITION CONSTRUCTION.
3.	SEE SPECIFICATIONS FOR METAL STUD AND GYP. BD. MATERIALS.
4.	ALL GYP BOARD EXPOSED CORNERS SHALL RECEIVE CORNER BEADS.

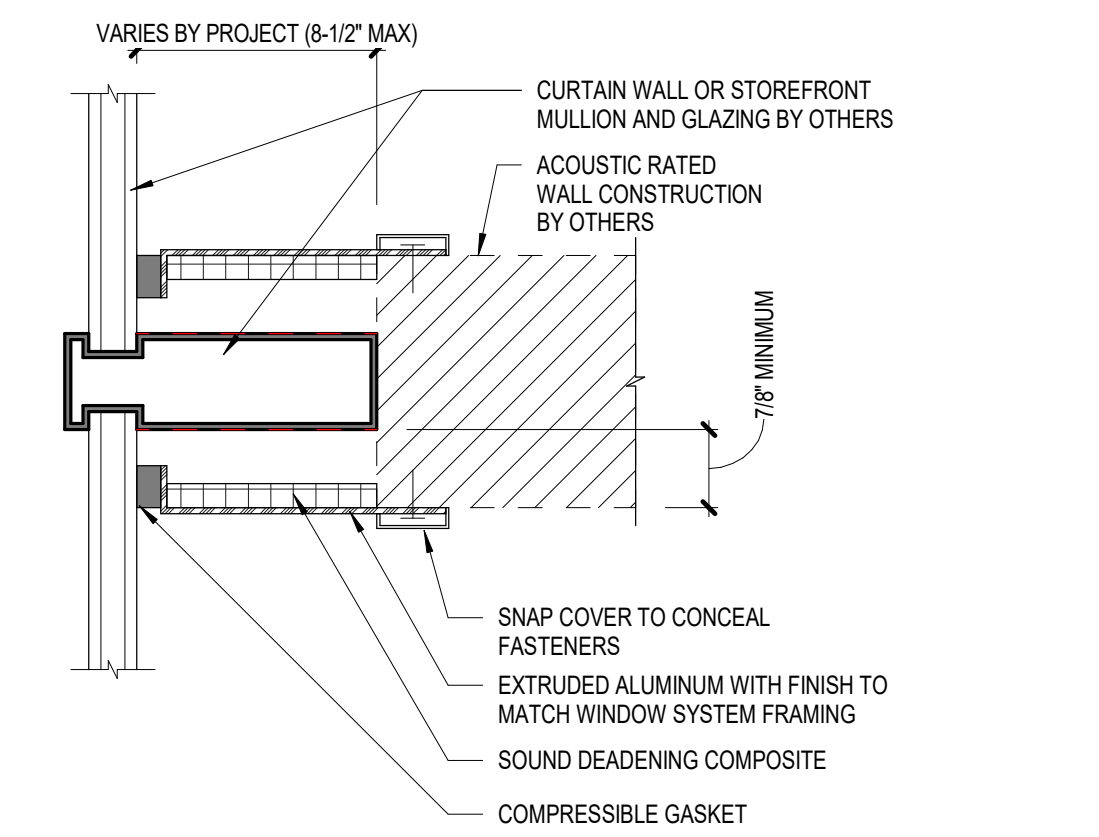


4 WALL TERMINATION DETAIL - MULL-IT-OVER 60 WIDE
SCALE: 3" = 1'-0"

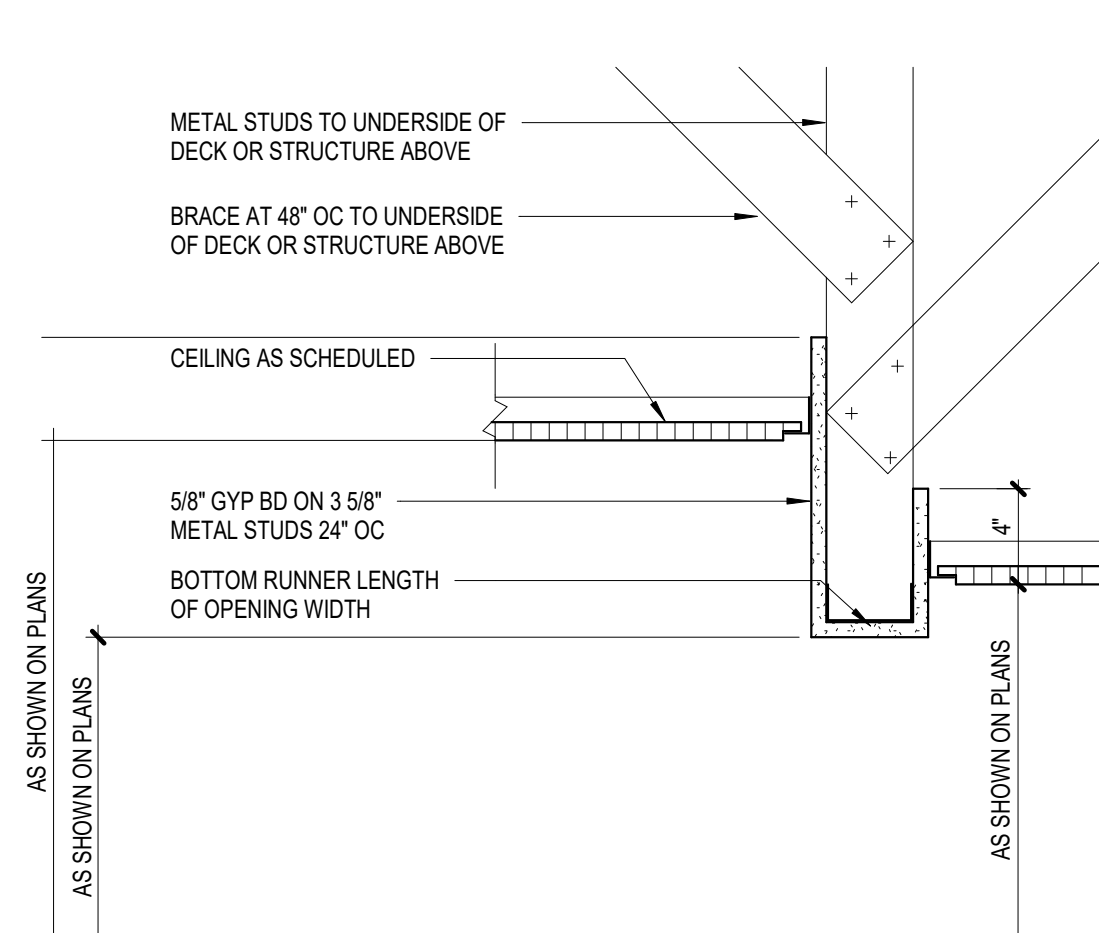

3 HEADER SECTION DETAIL
SCALE: 1 1/2" = 1'-0"

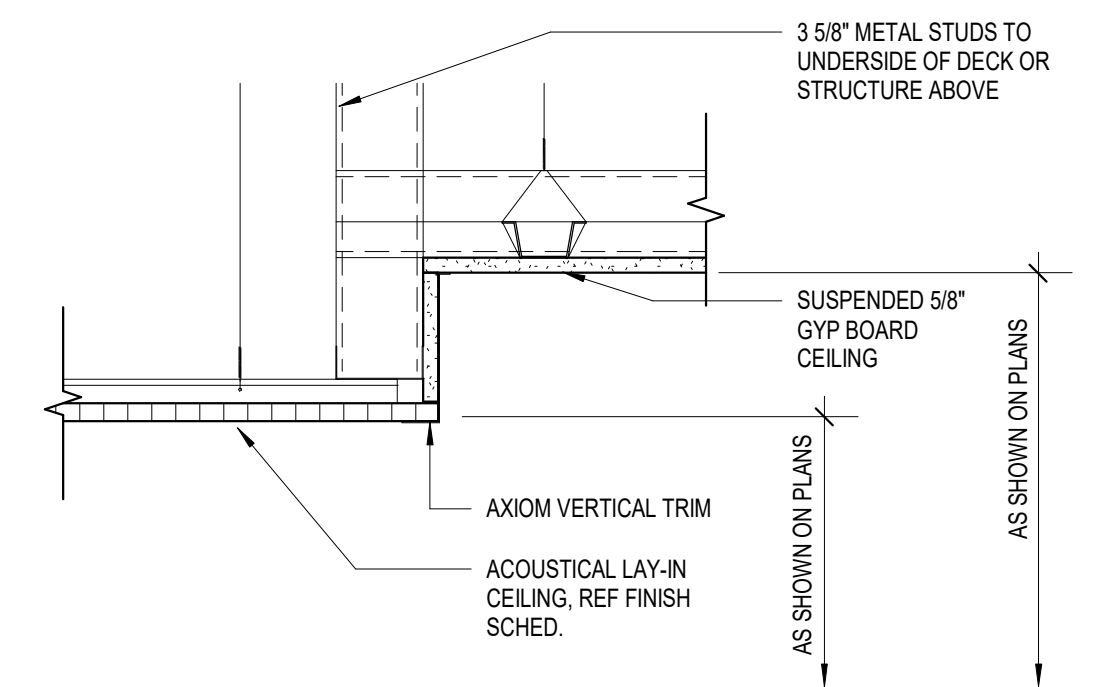

2 CEILING TRANSITION DETAIL
SCALE: 1 1/2" = 1'-0"

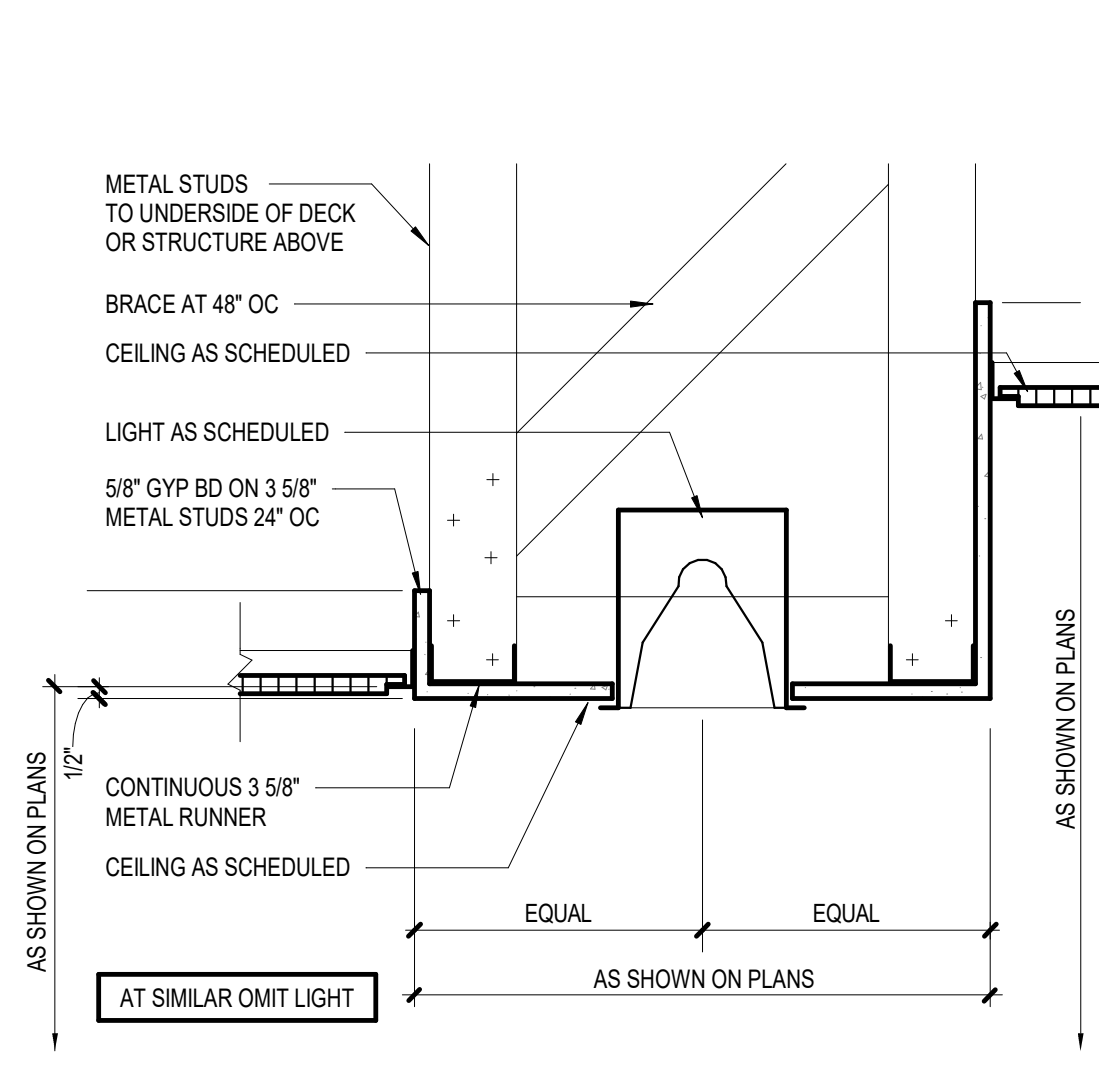

1 LIGHTED FURR DOWN SECTION DETAIL
SCALE: 1 1/2" = 1'-0"




TTUHSC Preston Smith Library
Renovation - Level 01 / 02
3601 4th Street, STOP 7781
Lubbock, TX 79430-7781

REVISION HISTORY

1	ADDENDUM 02	10 APR 2025
REVISION	DESCRIPTION	DATE
PROFESSIONAL SEALS		
REGISTERED ARCHITECT	ARCHITECT	04/10/2025
ARCHITECTURAL - INTERIOR/RCP DETAILS		
DRAWN BY	CHECKED BY	TEAM
PROJECT NUMBER	PROJECT ABBREVIATION	TTUHSC-PSL-02-01
320026.05	DATE	21 MAR 2025
ORIGINAL ISSUE	ISSUE FOR CONSTRUCTION	

NON-RATED PARTITION	PRIORITY 7 - LOWE
---------------------	-------------------

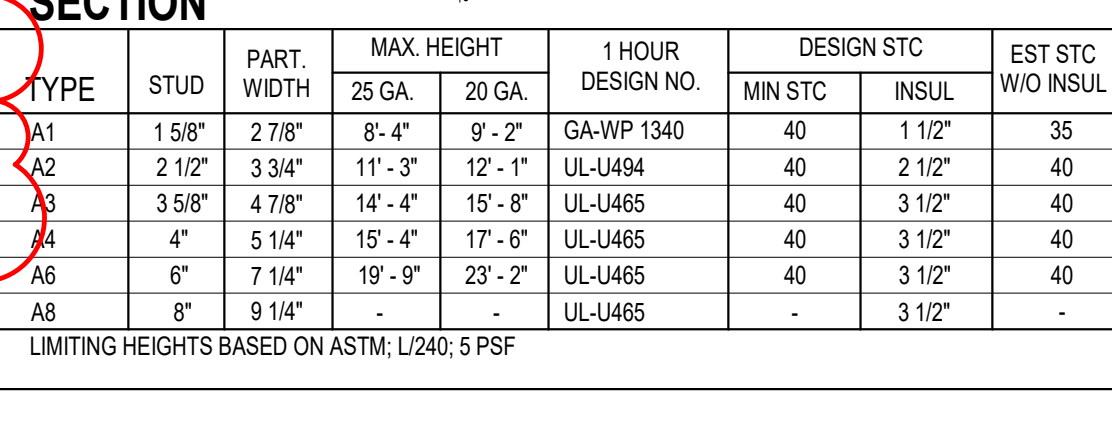

Autodesk Docs://320026-TexasTech-HSC-L-PS-Library/320026-A-TTUHSC-PSL-LVL-02-R24-CENTRAL.rvt
FILE PATH: 4/8/2025 5:20:43 PM
USER NAME: DATE STAMP: 4/8/2025 5:20:43 PM



1 INTERIOR - FINISH FLOOR PLAN - LEVEL 02
SCALE: 1/8" = 1'-0"

INTERIOR FINISH GENERAL NOTES

1. NO SUBSTITUTIONS OF FINISHES ARE ALLOWED WITHOUT APPROVAL OF ARCHITECT.
2. SUBMIT (2) SAMPLES OF EACH FINISH AS SPECIFIED ON APPROPRIATE SUBSTRATE TO ARCHITECT FOR APPROVAL PRIOR TO ORDERING.
3. FLAME SPREAD AND SMOKE DEVELOPMENT RATINGS FOR INTERIOR FINISHES ARE TO BE IN ACCORDANCE WITH APPLICABLE CODES.
4. FLOOR TRANSITIONS SHALL OCCUR AT CENTERLINE OF DOOR IN CLOSED POSITION, UNO.
5. PROVIDE TRANSITION STRIP BETWEEN SCHEDULED CARPET, RESILIENT FLOORING, STONE FLOORING, AND TILE AS REQUIRED, UNO. REFER TO SECTION 09650. COLOR TO MATCH CARPET.
6. FLOORING TRANSITIONS SHALL BE COMPLETELY FLUSH. FIELD VERIFY FLOOR SLAB AND NOTIFY ARCHITECT OF AREAS TO BE LEVELLED BEFORE COMMENCING WORK. PROVIDE ADEQUATE FLOOR LEVELING MATERIAL TO MAINTAIN CONSISTENT LEVEL FLOOR SURFACE BETWEEN DIFFERENT FLOORING FINISH MATERIALS. NOTIFY ARCHITECT IMMEDIATELY IF EXCESSIVE FLOOR FLOAT IS REQUIRED.
7. TYPICAL FLOOR BASE SHALL BE RB-1, UNO.
8. REFER TO REFLECTED CEILING PLANS FOR CEILING FINISH INFORMATION.
9. REFER TO INTERIOR ELEVATIONS FOR ADDITIONAL FINISH REQUIREMENTS, INCLUDING DIMENSIONS AND EXTENT OF SPECIAL WALL FINISHES.
10. GYPSUM BOARD PARTITIONS SHALL BE FLOATED OUT TO MAINTAIN A SMOOTH, EVEN, CONSISTENT APPEARANCE IN ACCORDANCE WITH SPECIFICATION SECTION 09200. NOTICEABLE JOINTS OR TAPE LINES IN GYPSUM BOARD PARTITIONS WILL NOT BE ACCEPTABLE. REFER TO FINISH SCHEDULE AND SPECIFICATIONS FOR ADDITIONAL WALL FINISH INFO.
11. PAINTED WALLS SHALL HAVE AN EVEN DEPTH OF COLOR AND REFLECTANCE. IF A PORTION OF A WALL IS REPAINTED AND AN EVEN FINISH IS NOT ACHIEVED, THE ENTIRE WALL SHALL BE REPAINTED.
12. ACCESS PANELS, ELECTRICAL PANELS, AND OTHER UNFINISHED OR PRIME COATED ITEMS SHALL BE PAINTED TO MATCH THE WALL OR CEILING.
13. TYPICAL WINDOW COVERING AT ALL PERIMETER WINDOW WALLS ARE BUILDING PROVIDED MINI-BLINDS, UNLESS NOTED OTHERWISE. GC TO PROTECT FROM DAMAGE THROUGHOUT THE DURATION OF CONSTRUCTION. PRIOR TO TENANT MOVE-IN, MINI-BLINDS ARE TO BE CLEANED AND REINSTALLED.
14. ELECTRICAL COMMUNICATION DEVICES AND COVER PLATES SHALL BE WHITE, UNO.
15. WALLS SHALL RECEIVE (PT-1) AND RB-1, TYPICAL, UNO. ALLOW FOR PRIMER AND TWO TOPCOATS FOR PAINT APPLICATION OVER GYPSUM BOARD WITH (EGGSHELL).
16. WHEN A CEILING RECEIVES A COLOR OTHER THAN THE STANDARD, PAINT CEILING MOUNTED DEVICES TO MATCH, INCLUDING DIFFUSERS.
17. ACCESS PANELS, ELECTRICAL PANELS, AND OTHER UNFINISHED OR PRIME COATED ITEMS SHALL BE PAINTED TO MATCH THE WALL OR CEILING IN WHICH IT IS INSTALLED.
18. ACCENT PAINT SHALL EXTEND HORIZONTALLY FROM INSIDE CORNER TO INSIDE CORNER ALONG WALL. CONTINUE ACCENT PAINT ACROSS FURROWS AND BULKHEADS ONLY IF THEY ARE IN THE SAME PLANE AS THE ACCENT WALL.
19. CAULKING AND SEALANT SHALL MATCH SURFACE TO WHICH IT IS APPLIED, UNO. SUBMIT COLOR CHART FOR ARCHITECT'S SELECTION. WHERE TWO DIFFERENT MATERIALS/COLORS ALIGN IN THE SAME PLANE, MATCH THE DARKER COLOR.
20. PAINT HOLLOW METAL DOORS SAME COLOR AS FRAME, TYPICAL, UNO. HOLLOW METAL FRAMES SHALL BE SEMI-GLOSS.
21. SCHEDULED FLOOR FINISH TO RUN CONTINUOUSLY UNDERNEATH MILLWORK, UNO.


KEYED NOTES

NUMBER	DESCRIPTION
AI.14	TERRAZZO FLOOR FINISH ON STAIRS BETWEEN ALL LEVELS.

FINISH FLOOR LEGEND

SYMBOL	DESCRIPTION
	CPT-1 (FIELD)
	CPT-2 (COLLABORATIVE)
	CPT-3 (QUIET)
	SEC-1
	LVT-1
	TRZ-1
	EPX-1
	WOC-1
	TIL-1
	RSF-1

KEY PLAN (NOT TO SCALE)

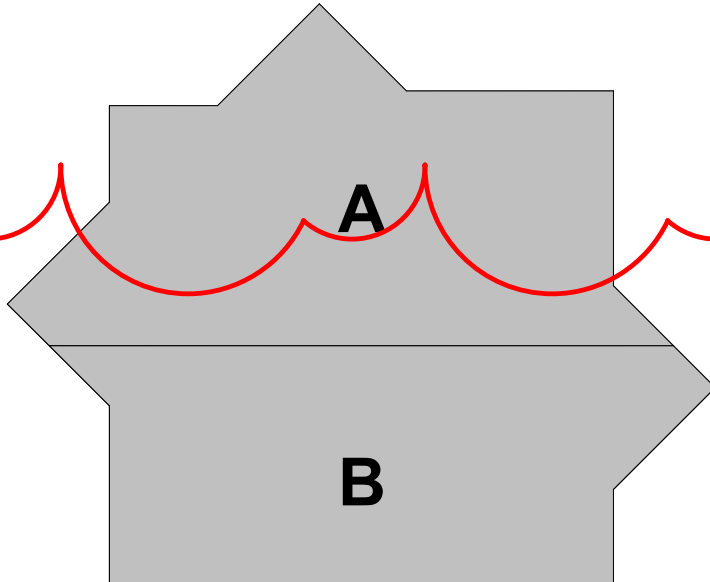

Page Southerland Page, Inc.
1800 Main Street Suite 123
Dallas, TX 75201
page@pspi.com
TEL: 214.522.3900
FAX: 214.522.4380

ARCHITECTURE / ENGINEERING / INTERIORS / PLANNING / CONSULTING
Austin / Dallas / Denver / Dubai / Houston / Mexico City / Phoenix /
San Francisco / Washington DC / International Affiliate Offices


MEP ENGINEER
FANNING, FANNING & ASSOCIATES, INC.
2555 74th Street
Lubbock, Texas 79423
(806) 745-2533



TTUHSC Preston Smith Library
Renovation - Level 01 / 02
3601 4th Street, STOP 7781
Lubbock, TX 79430-7781

REVISION HISTORY

REVISION	DESCRIPTION	DATE
1	ADDENDUM 02	10 APR 2025
2	PROFESSIONAL SEALS	

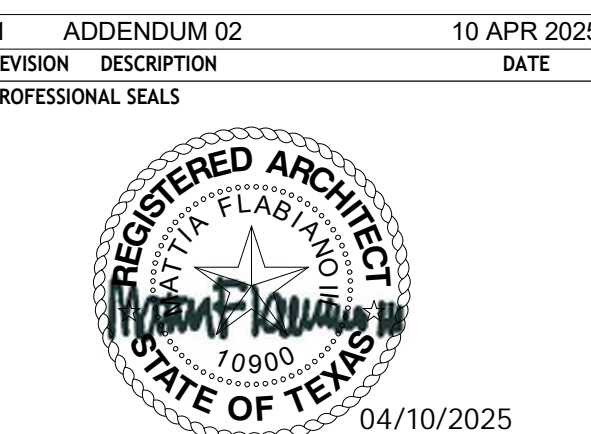

ARCHITECTURAL - INTERIORS PLAN -
LEVEL 02

DRAWN BY TEAM	CHECKED BY TEAM
PROJECT NUMBER 320026.05	PROJECT ABBREVIATION TTUHSC-PSL-02-01
ORIGINAL ISSUE DATE	DATE 21 MAR 2025
ISSUE FOR CONSTRUCTION	

AI-102
SHEET NUMBER



TTUHSC Preston Smith Library
Renovation - Level 01 / 02
3601 4th Street, STOP 7781
Lubbock, TX 79430-7781

REVISION HISTORY

[illegible]

1	ADDENDUM 02	10 APR 20
REVISION	DESCRIPTION	DATE
PROFESSIONAL SEALS		



04/10/2025

ARCHITECTURAL - INTERIORS FINISH
SCHEDULE


DRAWN BY TEAM	CHECKED BY TE
PROJECT NUMBER 320026.05	PROJECT ABBREVIATION TTUHSC-PSL-02
ORIGINAL ISSUE ISSUE FOR CONSTRUCTION	DATE 21 MAR 20

AI-601

ITEM CODE	ITEM DESIGNATION	MANUFACTURER	MODEL	COLOR	COLOR NUMBER	FINISH, TEXTURE, PATTERN, SIZE	COMMENT/S/CONTACT
Base	Integral Base	TORREY	TO SP18A	SHARKGLO	187 382	8" HIGH	LOP DOW BASE WITH 1/8" BOND STAINLESS STEEL TRIM
RWB-1	Reinforced Rope	ROPE	10 OFFER	BLACK BROWN	P149	4" BOND	NAME: MEREDITH BROWN PHONE: 488-5434 EMAIL: MEREDITH.BROWN@PROFESSIONALFLOORING.COM
BS-1	Marbles	SSGA MARBLE		EMERALD GRAY IN TILE, FIBROK		6"X6" CRYSTAL	
BS-1	Acoustic Ceiling Tiles	USG	SD900 12"X12" PANELS	WHITE	212	12"X12"	NAME: JANE LEIS PHONE: 488-7300 EMAIL: JANELEIS@USG.COM
Q-1-1	Decorative Ceiling Trim	HYDRONE	CLASSIC 2 STEP BONDING			3" HEIGHT, PAINT TO MATCH CEILING	REFER TO SPEC FOR PAINT SHEEN
Q-1-2	Decorative Ceiling Trim	HYDRONE	SAMPLE COLOR RAL - CASTING (LARGE)			3 1/4" HIGH, PAINT TO MATCH CEILING	REFER TO SPEC FOR PAINT SHEEN
DOOR/STAIRCASE	Door	DOUG EDWARDS		MATCH DOOR TRIM	MATCH BS-102	68"X40"X1 3/4"	
CH-1	Chandelier	SHAW	HAND WOVEN TILE	TEALATE	2518	ASBLAR INSTALL, 18" X 36"	
CH-2	Chandelier	SHAW	NEW HEIGHT	CHALK CARNIVAL	1302	ASBLAR INSTALL, 18" X 36"	NAME: LISA MONTY PHONE: 488-7300 EMAIL: LISA.MONTY@SUNWATCO.COM
CH-3	Chandelier	SHAW	ALBAN TILE	TEALATE	2518	ASBLAR INSTALL, 18" X 36"	
LY-1	Reinforced Tile	SHAW	CROSSING PATHS 13	SMOXY GAY	0511	12"X12"	
LY-2	Reinforced Floor - Rubber	SHAW	SPRINKLE	SHAWNET	0511	12"X12"	
CV-1	Concrete - Solid	DOUG EDWARDS	3" OFFER	CLEAR		1/4" THICK	
WOC-1	Wall Off Corner	SSGA MARBLE	DOUG-118	BLACK GRAY W/ RED		DOUG 12"X24"	
MeliorConnect							
PL-1	Plastic Laminate	WELDONET	MODERN WALNUT	DOUG	7108-76	FINISHED GLOSS FRESH WHITE TRIM	MELLYWOODS TO RUN HORIZONTALLY AND DOORS (DOWN TO RUN VERTICALLY)
SM-1	Solid Surface	CORIAN	DOUG	RAIN LAGOON	096-0		
SM-2	Solid Surface	CORIAN	ARTISTA DUST				
SM-3	Solid Surface	LIVINGSTONE	FLAX		130		
Acoustics							
AL-1	Acoustic	MP3 ACOUSTICS	COLOD	SLATE	33		REFER TO ELEVATION
AL-2	Acoustic	MP3 ACOUSTICS	COLOD	GRANITE	18		REFER TO ELEVATION
AL-3	Acoustic	MP3 ACOUSTICS	COLOD	MARBLE	0		REFER TO ELEVATION
AL-4	Acoustic	MP3 ACOUSTICS	COLOD	CHEVRON	1		REFER TO ELEVATION
AL-5	Standard	CLARUS	FLOAT	WHITE			BOX TRAY - EQUAL MIX OF WHITE, RED, BLACK, MAGNET, GRASS, 3 BOND MATERIALS
AL-6	Standard	CLARUS	FLOAT	WHITE			
W-1	Wall	SCHLITZER	JULY			STAINLESS STEEL	
W-2	Wander Panel Finish	TRD	TRD Standard Finish		TRD		
RWB-1	Reinforced Panel	3FIBER	VARIA	RED		SMOINTE, 1/4"	GREYER CRUSHSHANK - 214 782 782; GREYER CRUSHSHANKS.COM; PH: 603 482 8880
RWB-2	Reinforced Panel	3FIBER	VARIA	RED		SMOINTE, 1/4"	GREYER CRUSHSHANK - 214 782 782; GREYER CRUSHSHANKS.COM; PH: 603 482 8880
PL-1	Panel	DOUG EDWARDS		HIC BONE WHITE		EGGSHILL	
PL-1A	Panel	BENJAMIN MOORE	SCUFF-X	HIC BONE WHITE		EGGSHILL	
PL-2	Panel	DOUG EDWARDS		WASH CAR	MATCH BS8170	EGGSHILL	
PL-3	Panel	BENJAMIN MOORE	SCUFF-X	WASH CAR	MATCH BS8170	EGGSHILL	
PL-4	Panel	DOUG EDWARDS	MATCH BS8888	WASH CAR	MATCH BS8888	EGGSHILL	
PL-4A	Panel	DOUG EDWARDS	MATCH BS8879	WASH CAR	MATCH BS8879	EGGSHILL	
PL-4B	Panel	BENJAMIN MOORE	SCUFF-X	WASH CAR	MATCH BS8879	EGGSHILL	
PL-5	Tile	TILEBAR	EM-15	ANTIGUA SILVER			
PL-6	Tile	ANTIGUA SURFACES	EM-15	ANTIGUA SILVER			
TL-1	Tile	HEAVY POP	GRAY GRAY				
DOOR-1	Door	EVERETT	TEXTURE	CHALK	4347-101	8"	WRAPPED AROUND CORNER PANEL

INTERIOR FINISH GENERAL NOTES

1. NO SUBSTITUTIONS OF FINISHES ARE SPECIFIED WITHOUT APPROVAL OF ARCHITECT
2. SURVEY / SAMPLES OF EACH FINISH AS OBTAINED ON APPROPRIATE SUBSTRATE TO ARCHITECT FOR APPROVAL PRIOR TO ORDERING
3. FLAME SPREAD AND SMOKE DEVELOPMENT RATINGS FOR INTERIOR FINISHES ARE TO BE IN ACCORDANCE WITH APPLICABLE CODES
4. FLOOR TRANSITIONS SHALL OCCUR AT SCHEDULED OF DOOR IN CLOSED POSITION, UNO
5. PROVIDE TRANSITION STRIP BETWEEN CERULEAN CARPET, RESILIENT FLOORING, STONE FLOORING, AND TILE AS REQUIRED, UNO. REFER TO SECTION 096500. COLOR TO MATCH CARPET.
6. FLOORING TRANSITIONS SHALL BE COMPLETELY FLUSH. FIVE FEET VERTICAL FLASB AND NOTIFY ARCHITECT OF AREAS TO BE LEVELLED BEFORE COMMENCING WORK. PROVIDE CARPET TRANSITION STRIP TO MAINTAIN CONSTANT LEVEL FLOOR SURFACE BETWEEN DIFFERENT FLOORING FINISHES MATERIALS. NOTIFY ARCHITECT IMMEDIATELY IF EXCESSIVE FLOOR FLOAT IS REQUIRED
7. TYPICAL FLOOR BASE SHALL BE RB-1, UNO
8. REFER TO REFLECTED CEILING PLANS FOR CEILING FINISH INFORMATION
9. REFER TO INTERIOR ELEVATIONS FOR ADDITIONAL FINISH REQUIREMENTS, INCLUDING DIMENSIONS AND EXTENT OF SPECIAL WALL FINISHES
10. GYPSUM BOARD PARTITIONS SHALL BE FLOATED OUT TO MAINTAIN A SMOOTH, EVEN, CONTINUOUS SURFACE. FINISH WITH SPECIFICATION SECTION 09500. NOT ACCEPTABLE JOINTS OR TAPE LINES ON GYPSUM BOARD PARTITIONS WILL NOT BE RECEIVABLE. REFER TO FINISH SCHEDULE AND SPECIFICATIONS FOR ADDITIONAL WALL FINISH UNO
11. PAINTED WALLS SHALL HAVE AN EVEN DEPTH OF COLOR AND REFLECTANCE. IF A PORTION OF WALL IS REPAINTED AND AN EVEN FINISH IS NOT ACHIEVED, THE ENTIRE WALL SHALL BE REPAINTED
12. ACCESS PANELS, ELECTRICAL PANELS, AND OTHER UNFINISHED OR PRIME COATED ITEMS SHALL BE PAINTED TO MATCH THE WALL OR CEILING
13. TYPICAL WINDOW COVERING AT ALL PERMETER WINDOW UNITS ARE BUILDING PROVIDED MINIBLINDS, UNLESS NOTED OTHERWISE. GC TO PREVENT MOVE-IN DAMAGE THROUGHOUT THE DURATION OF CONSTRUCTION. GC TO TENDANT MOVE-IN DAMAGES ARE TO BE CLEANED AND REINSTALLED
14. ELECTRICAL COMMUNICATION DEVICES AND COVER PLATES SHALL BE WHITE, UNO
15. WALLS SHALL RECEIVE PTI-1] AND RB-1, TYPICAL UNO. ALLOW FOR PRIMER AND TWO TOPCOATS FOR PAINT APPLICATION OVER GYPSUM BOARD WITH EGGSHELL
16. WHEN A CEILING REQUIRES A COLOR OTHER THAN THE STANDARD, PAINT CEILING MOUNTED DEVICES TO MATCH, INCLUDING DIFFUSERS
17. ACCESS PANELS, ELECTRICAL PANELS, AND OTHER UNFINISHED OR PRIME COATED ITEMS SHALL BE PAINTED TO MATCH THE WALL OR CEILING IN WHICH IT IS INSTALLED
18. ACCEINT PAINT SHALL EXTEND HORIZONTALLY FROM INSIDE CORNER TO INSIDE CORNER. ALL OTHER ACCESSORIES SUCH AS DOOR SWEEPS AND BULHEADS JOINTS IF THEY ARE IN THE SAME PLANE AS THE ACCESS WALL
19. GULKING AND SEALANT SHALL MATCH SURFACE TO WHICH IT IS APPLIED, UNO. SUBMIT COLOR CHART FOR ARCHITECTS SELECTION. WHERE TWO DIFFERENT MATERIALS/COLORS ARE IN THE SAME PLANE, COLOR MATCH THE DARKER COLOR
20. PAINT HOLLOW METAL DOORS SAME COLOR AS FRAME, TYPICAL UNO. HOLLOW METAL FRAMES SHALL BE SEM-GLOSS
21. SCHEDULED FLOOR FINISH TO RUN CONTINUOUSLY UNDERNEATH MILLWORK, UNO

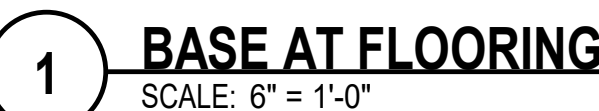



TTUHSC Preston Smith Library
Renovation - Level 01/02
3601 4th Street, STOP 7781
Lubbock, TX 79430-7781

WORK IN THIS AREA IS UNDER ADD ALTERNATE 01

- NOTES INDICATED BY "O"
- EXISTING DUAL DUCT VAV WITH PNEUMATIC CONTROLS TO REMAIN
 - RETROFIT EXISTING DUAL DUCT VAV WITH NEW DDC BOX CONTROLLER AND NETWORK THERMOSTAT. MODIFY THE EXISTING DUCTWORK AT THE INLETS AND OUTLETS OF THE EXISTING BOX AS REQUIRED TO COMPLY WITH THE DDVAV MOUNTING DETAIL ON M201
 - REMOVE EXISTING PNEUMATIC THERMOSTAT
 - REMOVE EXISTING TRANSFER DUCT ASSEMBLY. COORDINATE WITH GENERAL CONTRACTOR TO PATCH ABOVE CEILING PARTITION WHERE REQUIRED
 - REMOVE EXISTING GRILLE AND DUCTWORK SHOWN DASHED

FIRST FLOOR PLAN - MECHANICAL DEMOLITION

GRAPHIC SCALE: 1/8"=1'-0"



REVISION HISTORY

REVISION	DESCRIPTION	DATE
1	ADDENDUM 02	10 APR 2025

PROFESSIONAL SEALS



FIRST FLOOR PLAN -
MECHANICAL DEMOLITION

DRAWN BY	CHECKED BY
PROJECT NUMBER 24028	PROJECT ABBREVIATION TTUHSC-PSL-01-02
ORIGINAL ISSUE	DATE
ISSUE FOR CONSTRUCTION	21 MAR 2025

MD-101

SHEET NUMBER



TTUHSC Preston Smith Library
Renovation - Level 01/02
3601 4th Street, STOP 7781
Lubbock, TX 79430-7781

REVISION HISTORY

REVISION	DESCRIPTION	DATE
1	ADDENDUM 02	10 APR 2025


PROFESSIONAL SEALS	DATE
--------------------	------



FIRST FLOOR PLAN -
MECHANICAL

DRAWN BY	CHECKED BY
PROJECT NUMBER 24028	PROJECT ABBREVIATION TTUHSC-PSL-01-02
ORIGINAL ISSUE	DATE
ISSUE FOR CONSTRUCTION	21 MAR 2025

M-101
SHEET NUMBER

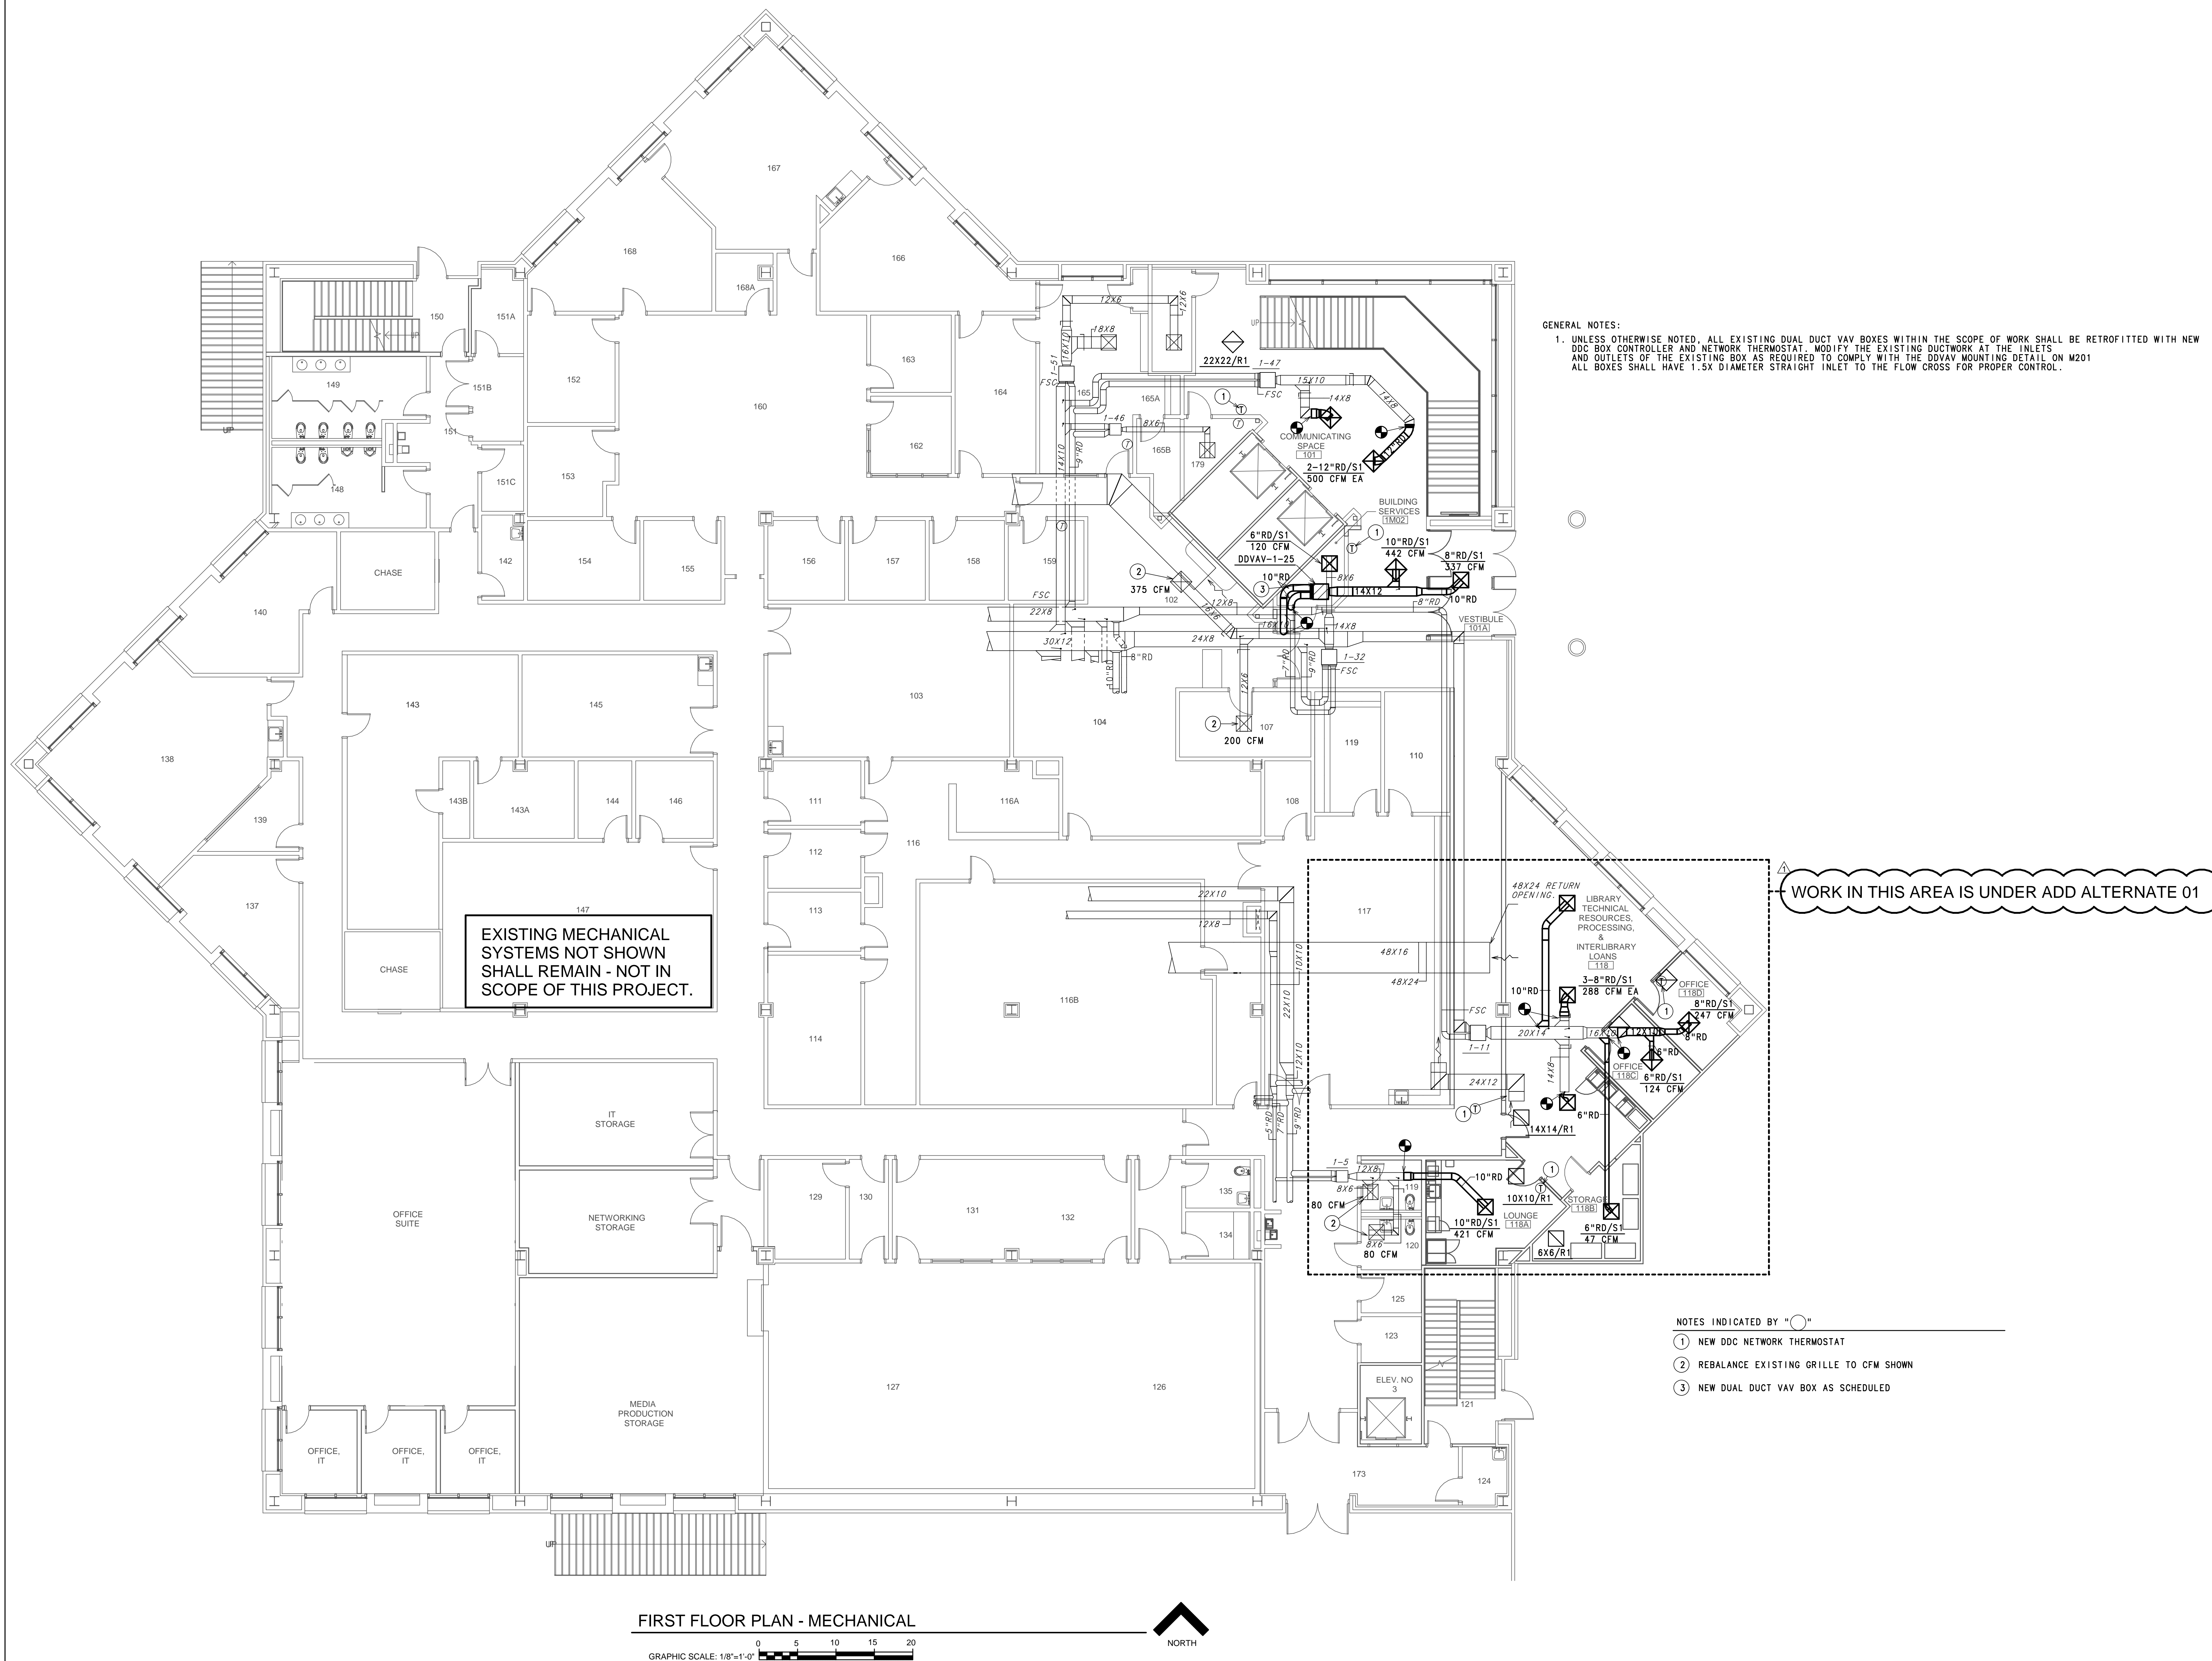

GENERAL NOTES:
1. UNLESS OTHERWISE NOTED, ALL EXISTING DUAL DUCT VAV BOXES WITHIN THE SCOPE OF WORK SHALL BE RETROFITTED WITH NEW DDC BOX CONTROLLER AND NETWORK THERMOSTAT. MODIFY THE EXISTING DUCTWORK AT THE INLETS AND OUTLETS OF THE EXISTING BOX AS REQUIRED TO COMPLY WITH THE DDAV MOUNTING DETAIL ON M201. ALL BOXES SHALL HAVE 1.5X DIAMETER STRAIGHT INLET TO THE FLOW CROSS FOR PROPER CONTROL.

WORK IN THIS AREA IS UNDER ADD ALTERNATE 01

NOTES INDICATED BY "O"

- 1 NEW DDC NETWORK THERMOSTAT
- 2 REBALANCE EXISTING GRILLE TO CFM SHOWN
- 3 NEW DUAL DUCT VAV BOX AS SCHEDULED

FIRST FLOOR PLAN - MECHANICAL

GRAPHIC SCALE: 1/8"=1'-0"




TTUHSC Preston Smith Library
Renovation - Level 01/02

3601 4th Street, STOP 7781
Lubbock, TX 79430-7781

[illegible]


M-102

SHEET NUMBER

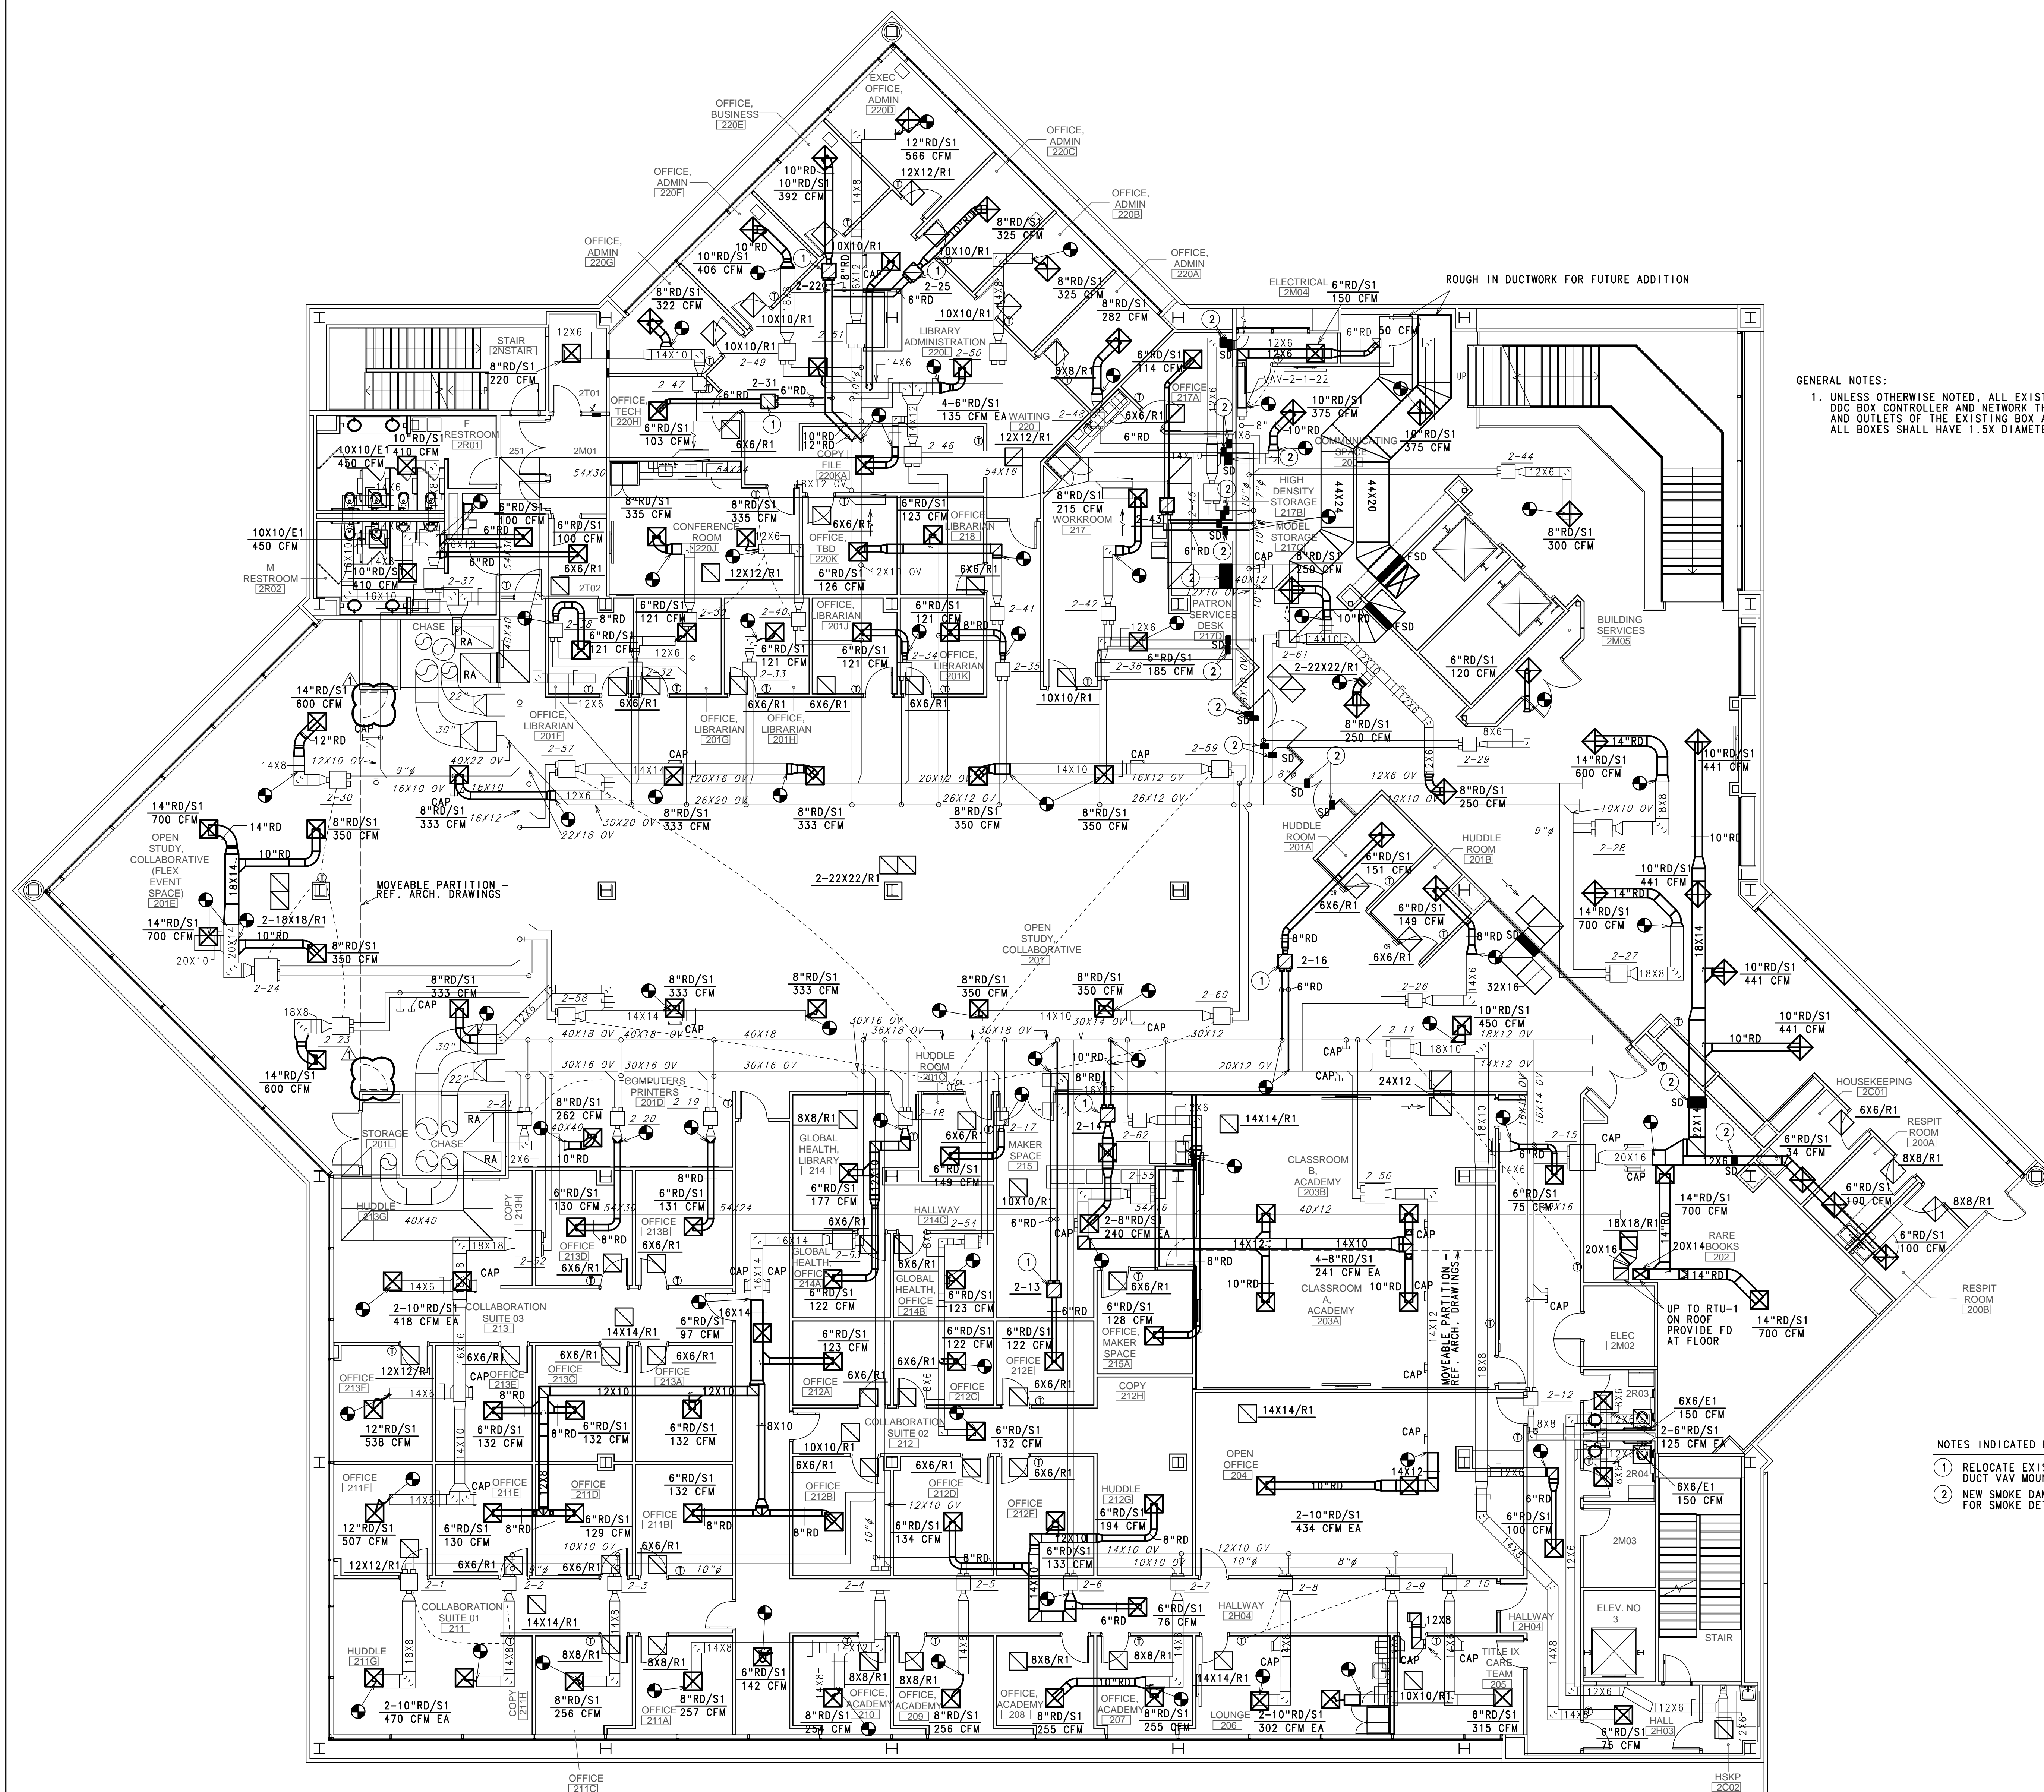

SECOND FLOOR PLAN - MECHANICAL



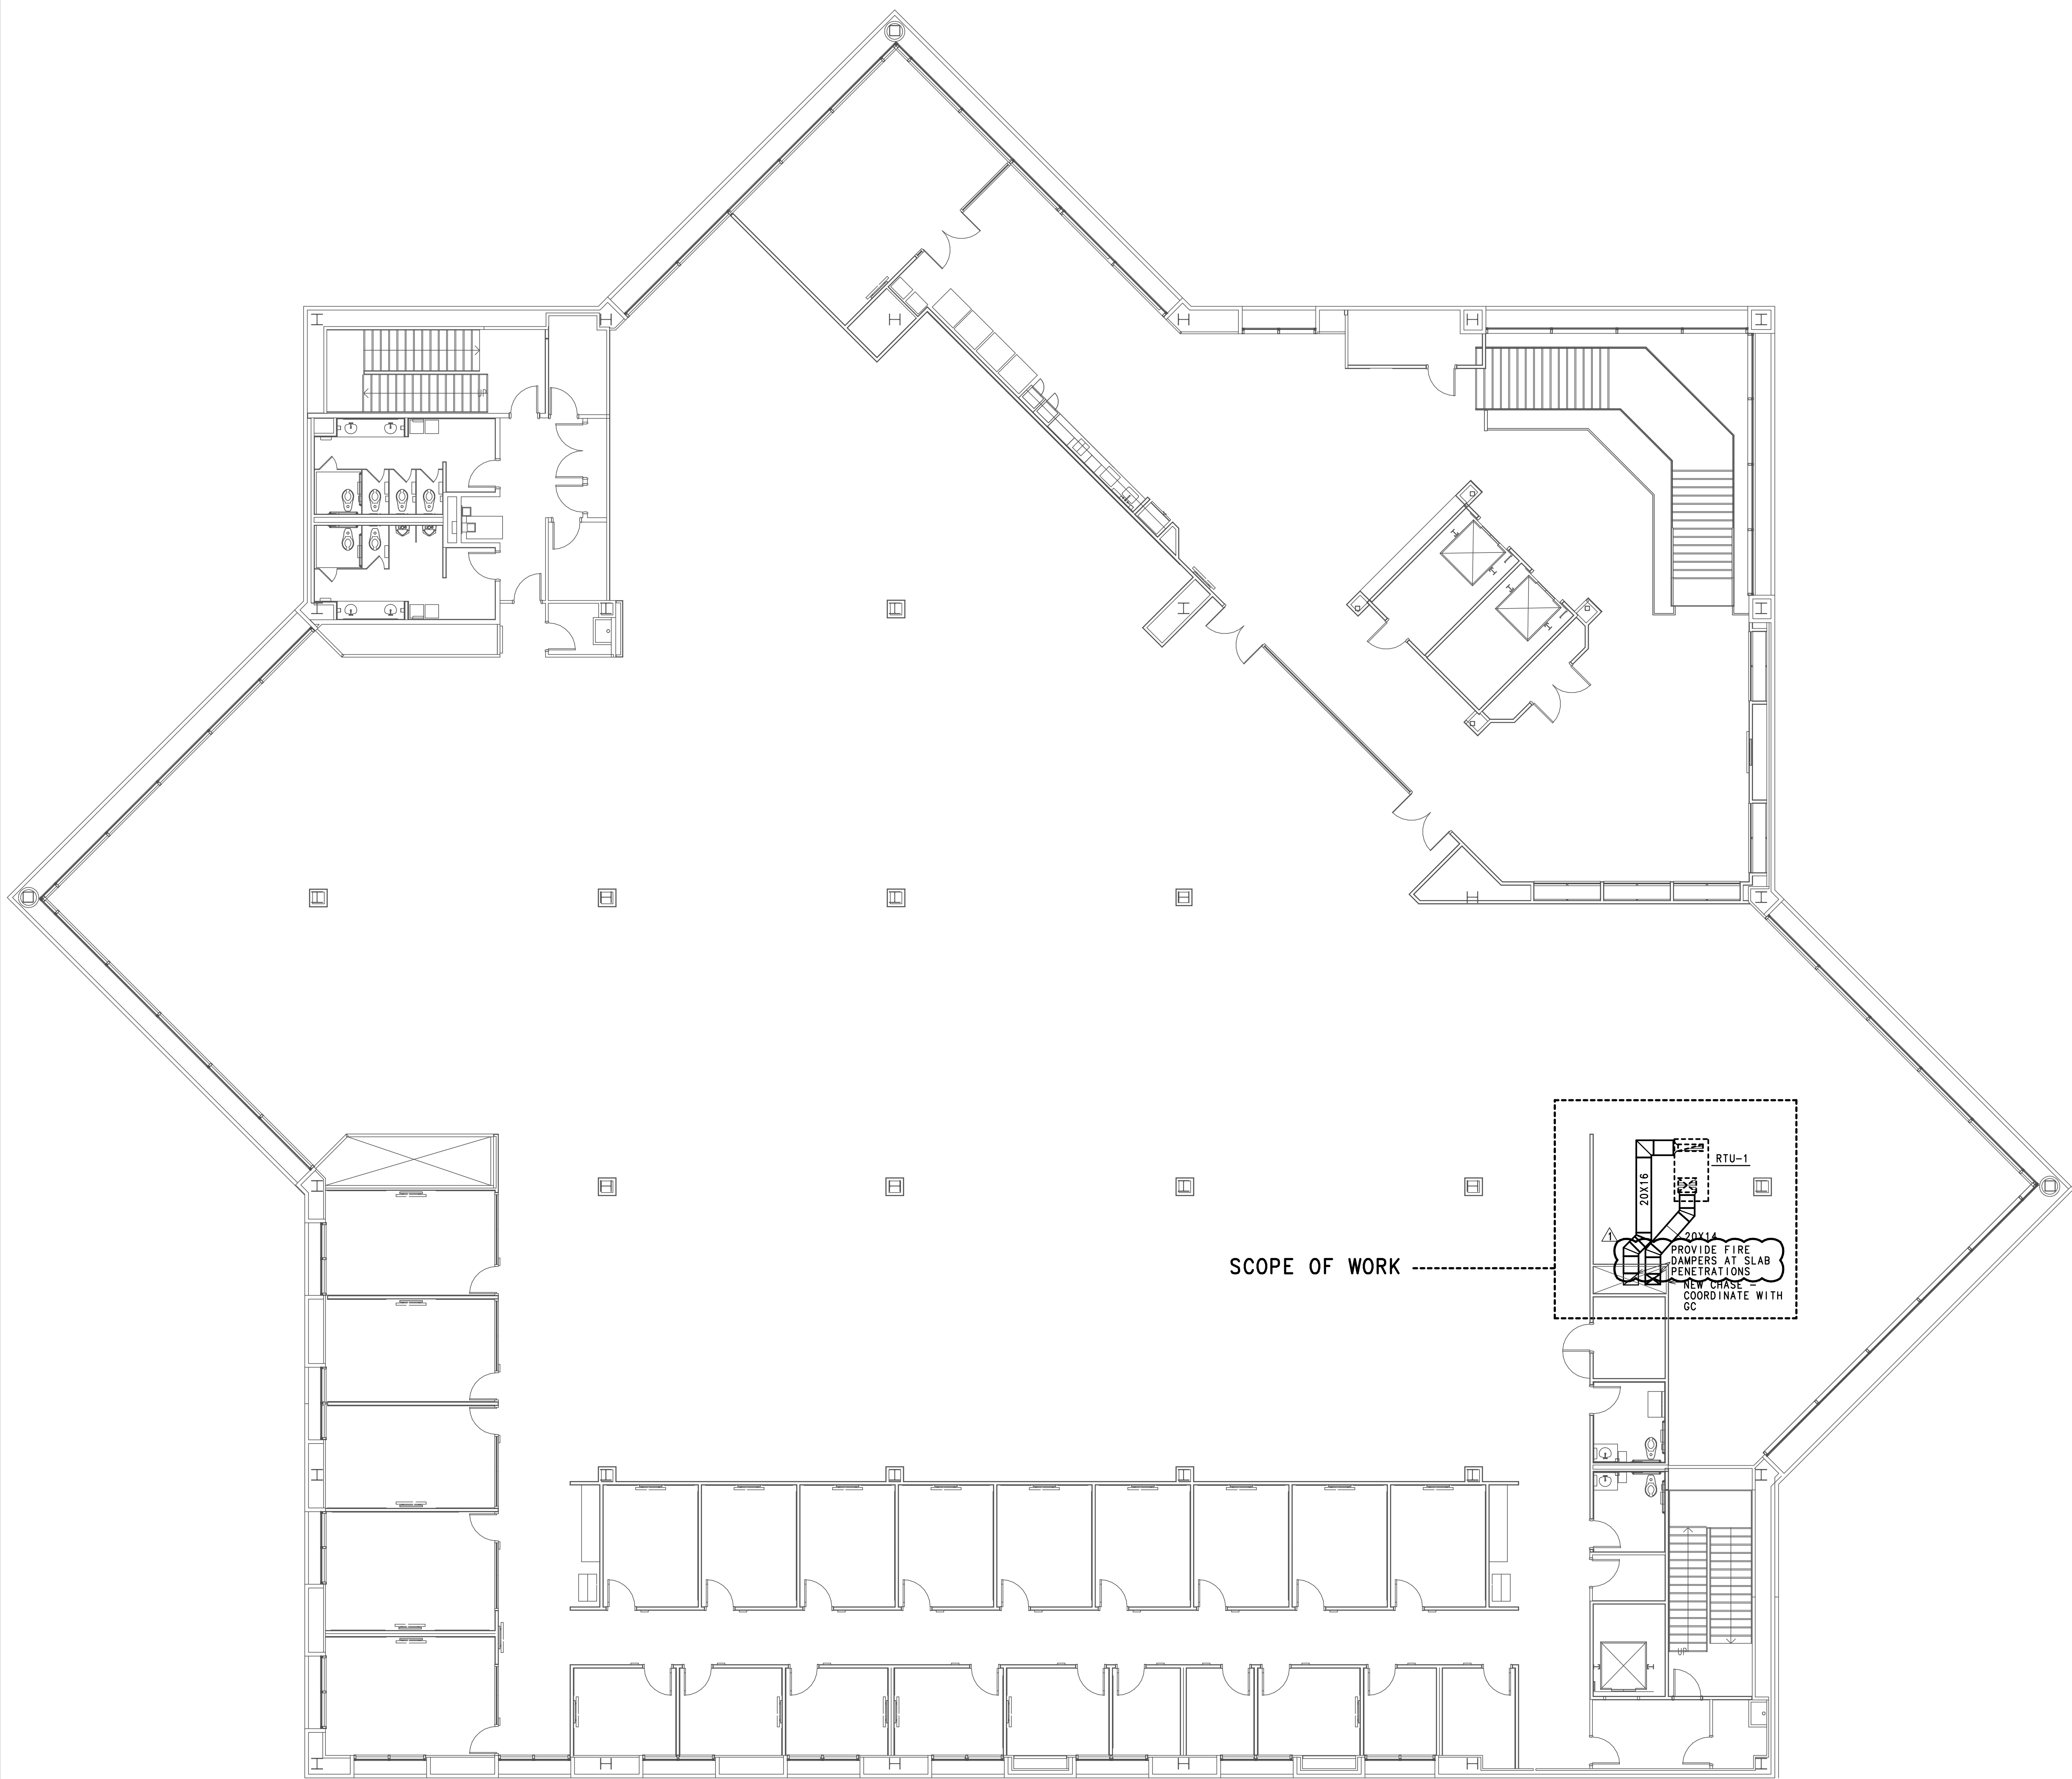

3RD FLOOR PLAN - MECHANICAL

GRAPHIC SCALE: 1/8"=1'-0"



Page Southerland Page, Inc.
1800 Main Street Suite 123
Dallas, TX 75201
pagethink.com
TEL 214 522 3900
FAX 214 522 4380
ARCHITECTURE / ENGINEERING / INTERIORS / PLANNING / CONSULTING
Austin / Dallas / Denver / Dubai / Houston / Mexico City / Phoenix /
San Francisco / Washington DC / International Affiliate Offices

MEP ENGINEER
FANNING, FANNING & ASSOCIATES, INC.
2555 74th Street
Lubbock, Texas 79423
(806) 745-2533



TTUHSC Preston Smith Library
Renovation - Level 01/02
3601 4th Street, STOP 7781
Lubbock, TX 79430-7781

REVISION HISTORY

REVISION	DESCRIPTION	DATE
1	ADDENDUM 02	10 APR 2025

PROFESSIONAL SEALS

1
SCOTT M. FANNING
61441
REGISTERED PROFESSIONAL MECHANICAL ENGINEER
STATE OF TEXAS

2
[Signature]

THIRD FLOOR PLAN - MECHANICAL

DRAWN BY	CHECKED BY
PROJECT NUMBER 24028	PROJECT ABBREVIATION TTUHSC-PSL-01-02
ORIGINAL ISSUE	DATE
ISSUE FOR CONSTRUCTION	21 MAR 2025

M-103

SHEET NUMBER




TTUHSC Preston Smith Library
Renovation - Level 01/02
3601 4th Street, STOP 7781
Lubbock, TX 79430-7781

PACKAGED ROOFTOP UNIT SCHEDULE - ELECTRIC HEAT

TAGS	AIRFLOW APPLICATION	DESIGN S.A.	DESIGN O.A.	DESIGN ESP	SUPPLY MOTOR HORSEPOWER	TONNAGE	GROSS TOTAL CAPACITY	GROSS SENSIBLE CAPACITY	COOLING ENTERING DB	COOLING ENTERING WB	SUMMER AMBIENT TEMP.	COIL LAT (DB)	COIL LAT (WB)	SEER	EER	HEATING TYPE	HEATING CAPACITY	REHEAT CAPACITY	HEATING EAT	HEATING LAT	REHEAT LAT DB/WB	VOLTAGE	MCA	MOP	LENGTH	WIDTH	HEIGHT	MODEL NUMBER - AAOB	UNIT OPERATING WEIGHT LB
		CFM	CFM	IN H2O	HP		MBH	MBH	F	F	F	F	F				MBH	MBH	F	F	F		A	A	IN	IN	IN		
RTU-1	DOWNFLOW	1200	240	1	1	5	48.3	40.9	77.6	58.9	100	41.8	41.7	13.4	11.85	SCR ELEC	68.2	37.8	58.0	116.4	72/54	460/60/3	34	35	82	44	47	RQ-005-3-0-CABY-V0-21-000-A	911

- NOTES:
1. PROVIDE INSULATED ROOF CURB
 2. PROVIDE MERV 8 FILTERS ON ALL UNITS.
 3. PROVIDE HAIL GUARDS.
 4. PROVIDE HINGED ACCESS PANELS.
 5. PROVIDE THRU THE BASE ELECTRICAL, NON-FUSED DISCONNECT, & POWERED CONVENIENCE OUTLET.
 6. PROVIDE PIPED CONDENSATE DRAIN.
 7. NEW UNIT SHALL HAVE MODULATING HOT GAS REHEAT, MODULATING SCR ELECTRIC REHEAT, MODULATING VARIABLE CAPACITY COMPRESSOR, AND A HUMIDIFIER SECTION
 8. PROVIDE WITH COMBINATION THERMOSTAT AND HUMIDISTAT. UNIT SHALL CONTROL TEMPERATURE AND HUMIDITY WITHOUT PRIORITIZING EITHER.
 9. REFER TO SPECIFICATIONS SECTION 237100 ROOFTOP UNIT FOR RARE BOOKS ROOM

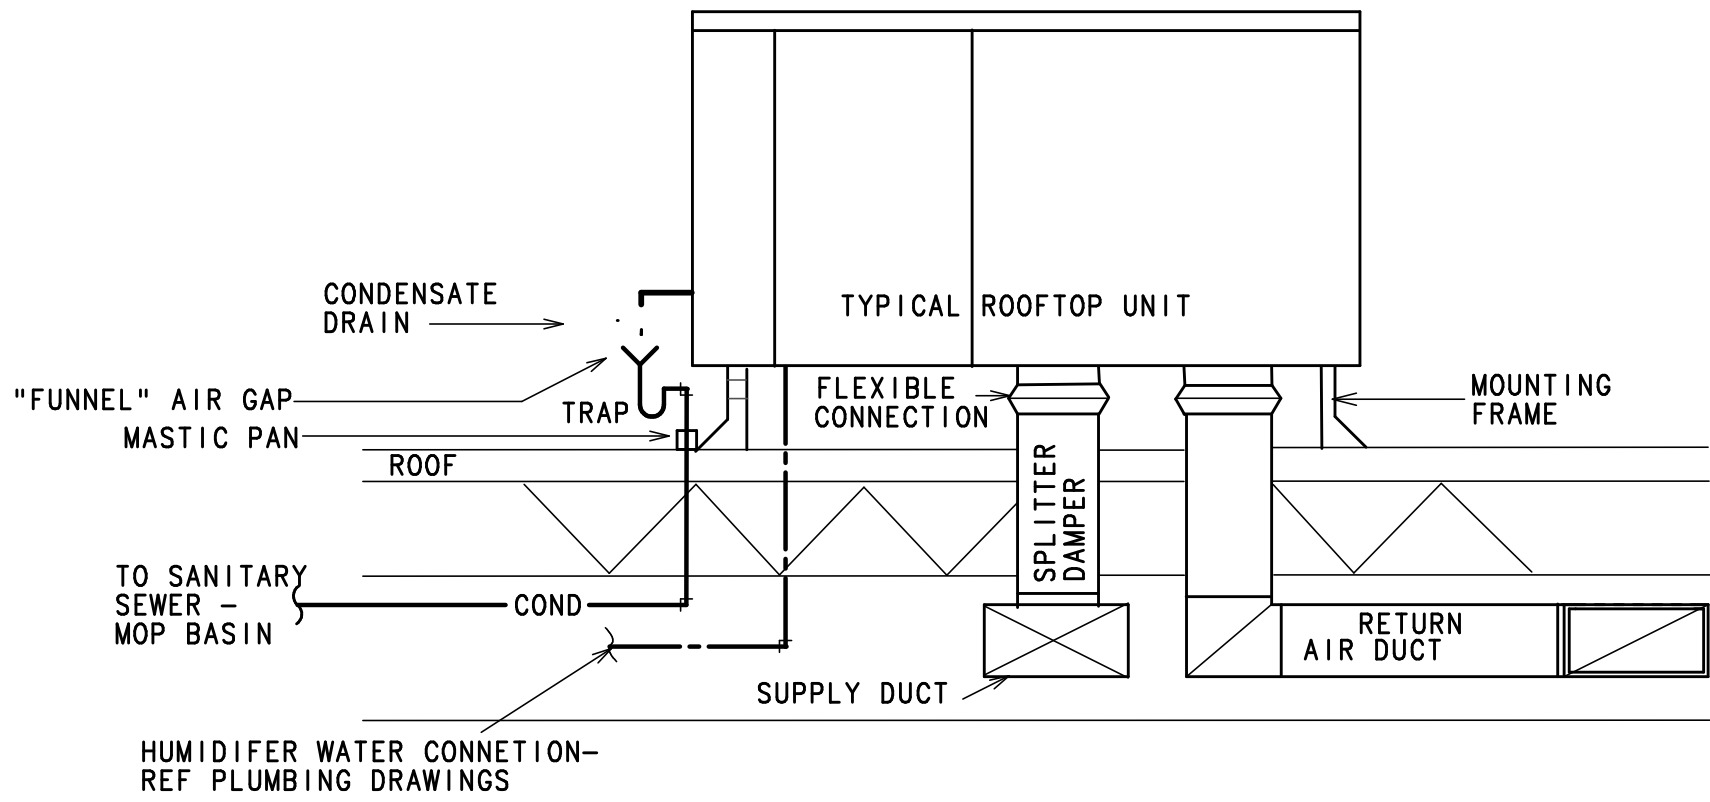

ROOFTOP UNIT MOUNTING DETAIL

NO SCALE

SINGLE DUCT TERMINAL UNIT SCHEDULE

EXISTING TO REMAIN - COOLING ONLY

TAG	ROOM	MODEL	SIZE	CFM		STATIC PRESSURE		NC LEVELS		HOT WATER HEAT COIL										NOTES	
				UNIT	MAX	MIN	INLET	DOWN	MIN	RAD	DIS	CFM	MBH	EAT	EW	LAT	APD	GPM	LWT		WPD
VAV 2-1-22	ELEC 2M04	DESV	04	200	100	1	0.25	0.05	27	34	NOT APPLICABLE - COOLING ONLY										1

- NOTES INDICATED BY " () "
- 1 EXISTING TERMINAL UNIT WITH DDC CONTROLLER TO REMAIN. REPROGRAM MIN AND MAX AIRFLOWS AS SCHEDULED

MECHANICAL SYMBOL SCHEDULE


EXISTING	DEMOLISH	NEW	DESCRIPTION
- CHS -	- CHS -	- CHS -	CHILLED WATER SUPPLY
- CHR -	- CHR -	- CHR -	CHILLED WATER RETURN
- S -	- S -	- S -	STEAM (S=PRESSURE)
- D -	- D -	- D -	COND. DRAIN LINE
- HWS -	- HWS -	- HWS -	HEATING WATER SUPPLY
- HWR -	- HWR -	- HWR -	HEATING WATER RETURN
- AR -	- AR -	- AR -	ATMOSPHERIC RELIEF LINE
- BT -	- BT -	- BT -	BUCKET TRAP
- FT -	- FT -	- FT -	FLOAT AND THERMOSTATIC TRAP
- GV -	- GV -	- GV -	GATE VALVE
- GLV -	- GLV -	- GLV -	GLOBE VALVE
- BV -	- BV -	- BV -	BALL VALVE
- BFV -	- BFV -	- BFV -	BUTTERFLY VALVE
- PV -	- PV -	- PV -	PLUG VALVE
- PRV -	- PRV -	- PRV -	PRESSURE REDUCING VALVE
- AV -	- AV -	- AV -	AUTOMATIC VALVE
- A3V -	- A3V -	- A3V -	AUTOMATIC 3-WAY VALVE
- CV -	- CV -	- CV -	CHECK VALVE
- TW -	- TW -	- TW -	THERMOMETER WELL
- T -	- T -	- T -	THERMOMETER
- GC -	- GC -	- GC -	GAGE COCK
- GCW -	- GCW -	- GCW -	GAGE COCK WITH GAGE
- STR -	- STR -	- STR -	STRAINER
- SWB -	- SWB -	- SWB -	STRAINER WITH BLOWOFF VALVE
- UN -	- UN -	- UN -	UNION
- FCP -	- FCP -	- FCP -	FLEXIBLE CONNECTION - PIPING
- CR -	- CR -	- CR -	CONCENTRIC REDUCER
- ER -	- ER -	- ER -	ECCENTRIC REDUCER
- FID -	- FID -	- FID -	FLOW IN DIRECTION OF ARROW
- PD -	- PD -	- PD -	PITCH DOWN IN DIRECTION SHOWN
- RU -	- RU -	- RU -	RISER UP
- RD -	- RD -	- RD -	RISER DOWN
- RO -	- RO -	- RO -	RISE OR DROP
- BCO -	- BCO -	- BCO -	BRANCH CONNECTION OUT OF TOP
- BCB -	- BCB -	- BCB -	BRANCH CONNECTION OUT OF BOTTOM
- BCS -	- BCS -	- BCS -	BRANCH CONNECTION OUT OF SIDE
- CE -	- CE -	- CE -	CAP ON END OF PIPE
- 12X6 -	- 12X6 -	- 12X6 -	DUCTWORK - FIRST NUMBER IS VISIBLE DIMENSION
- OV -	- OV -	- OV -	OV = OVAL DUCT
- ME -	- ME -	- ME -	MITERED ELBOW WITH TURNING VANES
- DI -	- DI -	- DI -	DROP IN DUCT
- RI -	- RI -	- RI -	RISE IN DUCT
- SD -	- SD -	- SD -	SUPPLY DIFFUSER
- RD -	- RD -	- RD -	RETURN DIFFUSER
- FD -	- FD -	- FD -	FIRE DAMPER
- FSD -	- FSD -	- FSD -	FIRE/SMOKE DAMPER
- T -	- T -	- T -	THERMOSTAT
- C -	- C -	- C -	CONNECT TO EXISTING

REVISION HISTORY

1	ADDENDUM 02	10 APR 2025
---	-------------	-------------

REVISION	DESCRIPTION	DATE
----------	-------------	------

PROFESSIONAL SEALS

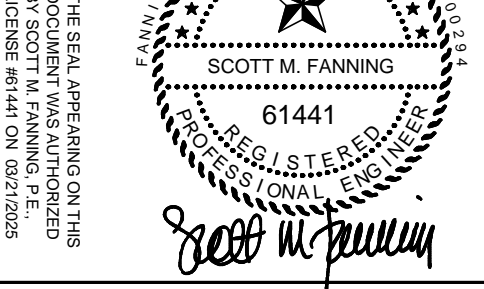

MECHANICAL SCHEDULES AND DETAILS

DRAWN BY	CHECKED BY
PROJECT NUMBER 24028	PROJECT ABBREVIATION TTUHSC-PSL-01-02
ORIGINAL ISSUE	DATE
ISSUE FOR CONSTRUCTION	21 MAR 2025

3601 4th Street, STOP 7781
Lubbock, TX 79430-7781

1	ADDENDUM 02	10 APR 2025
REVISION	DESCRIPTION	DATE
PROFESSIONAL SEALS		



ORIGINAL ISSUE DATE
ISSUE FOR CONSTRUCTION 21 MAR 2025

SHEET NUMBER



NOTES INDICATED BY: "  "

- 6 NEW FLOOR DRAIN WASTE TO EXISTING SEWER IN 1ST CEILING SPACE. (BASE BID).
7 NEW SINK ON 1ST FLOOR (ALT#01). ROUTE SEWER SERVICE IN BASEMENT AND CONNECT.



TTUHSC Preston Smith Library
Renovation - Level 01/02
3601 4th Street, STOP 7781
Lubbock, TX 79430-7781

REVISION HISTORY

REVISION	DESCRIPTION	DATE

ADDENDUM 02 10 APR 2025

PROFESSIONAL SEALS



SECOND FLOOR NEW PLUMBING PLAN

DRAWN BY CHECKED BY

PROJECT NUMBER 24028 PROJECT ABBREVIATION TTUHSC-PSL-01-02

ORIGINAL ISSUE DATE

ISSUE FOR CONSTRUCTION 21 MAR 2025

P-102
SHEET NUMBER

FIRE PROTECTION NOTE:



FLOOR IS PRESENTLY PROVIDED WITH A FIRE PROTECTION SPRINKLER SYSTEM. CONTRACTOR SHALL PROVIDE 100% FIRE SPRINKLER COVERAGE TO ACCOMMODATE NEW FLOOR PLAN IN ACCORDANCE WITH NFPA 13.

PROVIDE CONCEALER TYPE SPRINKLER HEADS - WHITE
PROVIDE SEMI-RECESSED HEADS
ALL QUICK RESPONSE

REROUTE EXISTING CONDENSATE DRAIN TO ACCOMMODATE THE NEW FLOOR PLAN - COORDINATE WITH TTUHSC

SEMI-RECESSED TYPE SPRINKLER HEAD

CONCEALED TYPE SPRINKLER HEAD

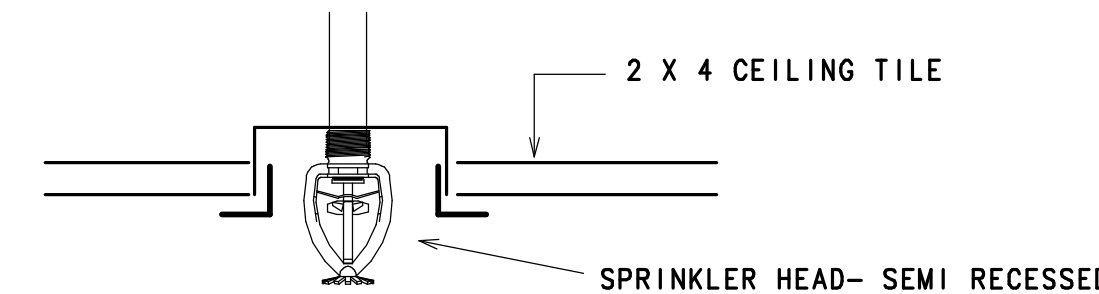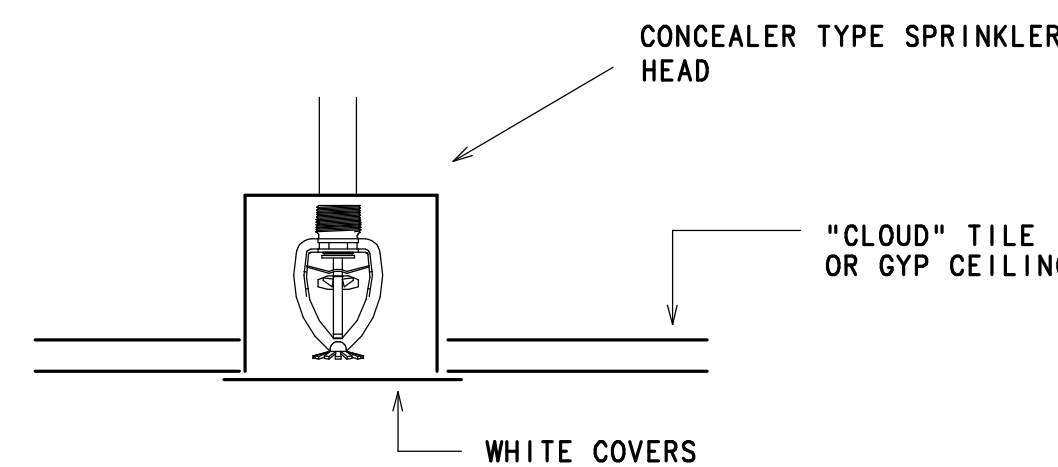

NOTE:

1ST FLOOR WORK IS ALTERNATE #01 - REFER TO ARCHITECTURAL DRAWINGS

PARTIAL 1ST DEMO - PLUMBING

GRAPHIC SCALE: 1/8"=1'-0"

PARTIAL 1ST NEW - PLUMBING

GRAPHIC SCALE: 1/8"=1'-0"

NOTES INDICATED BY: "A" "B"

- REROUTE EXISTING CONDENSATE DRAINS SERVING MORGUE UNITS TO NEW PUMP ON SHELF.
- CAP EXISTING WASTE RISER OPEN SITE DRAIN AND ROUTE EXISTING DRAINS TO NEW PUMP BOX ON SHELF. COORDINATE WITH TTUHSC.
- PROVIDE HUB DRAIN AIR GAP UNDER SINK WITH WALL BOX AND COVER FOR CONDENSATE DRAINAGE. INCORPORATE WITH NEW SINK ROUGH IN WASTE. ROUTE PUMPED CONDENSATE OVERHEAD AS INDICATED TO SINK, HUB DRAIN OR OTHER VENTED PLUMBING FIXTURE.

PARTIAL 3RD FLOOR PLAN - PLUMBING

GRAPHIC SCALE: 1/8"=1'-0"

SECOND FLOOR PLAN - NEW PLUMBING


GRAPHIC SCALE: 1/8"=1'-0"

NOTES INDICATED BY: "A" "B"


- EXISTING PLUMBING FIXTURE(S) TO REMAIN, REFER TO DEMOLITION PLAN.
- REINSTALL WATER COOLER AFTER FINISH WORK IS COMPLETE. PROVIDE NEW FIXTURES AS DETAILED PROVIDE NEW TOPS ON EXISTING FLOOR DRAINS.
- NEW PLUMBING FIXTURES AS SCHEDULED, ROUTE SERVICES TO NEAREST AVAILABLE AND CONNECT. REFER TO P103.
- MODIFY EXISTING FIRE PROTECTION SYSTEM TO EXCLUDE DRY TYPE (PRE-ACTION) DEVICES - RE: DETAIL ON P201
- RELOCATE EXISTING HOSE CABINET TO THE LOCATION INDICATED. ROUTE PIPING IN 1ST FLOOR CEILING AND RECONNECT
- ROUTE NEW CONDENSATE FROM MECH UNIT ON ROOF TO MOP SINK AS INDICATED, ROUTE DOWN IN WALL AND TURN DOWN OVER FLOOD RIM.
- CONNECT NEW 1/2" CW TO EXISTING AT THIS APPROXIMATE LOCATION. ROUTE AS INDICATED AND PROVIDE A CHARCOAL FILTER EQUAL TO AQUA-PURE AP717. ROUTE UP IN UNIT CURB AND MAKE FINAL CONNECTIONS TO HUMIDIFIER IN RTU.

DETAIL NOTES:


1. CAULK CONTINUOUS WITH APPROVED FIRE PROOF CAULK PER MANUFACTURER'S REQUIREMENTS.
2. CONTINUOUS INSULATION THROUGH WALL PENETRATION FOR PIPING THAT REQUIRES INSULATION.
3. 16 GA. PIPING MINIMUM FOR SLEEVES.
4. HOLES WILL BE CORED (DRY OR WET NO HAMMER DRILL PENETRATIONS WILL FIT SNUG TO SLEEVE.)

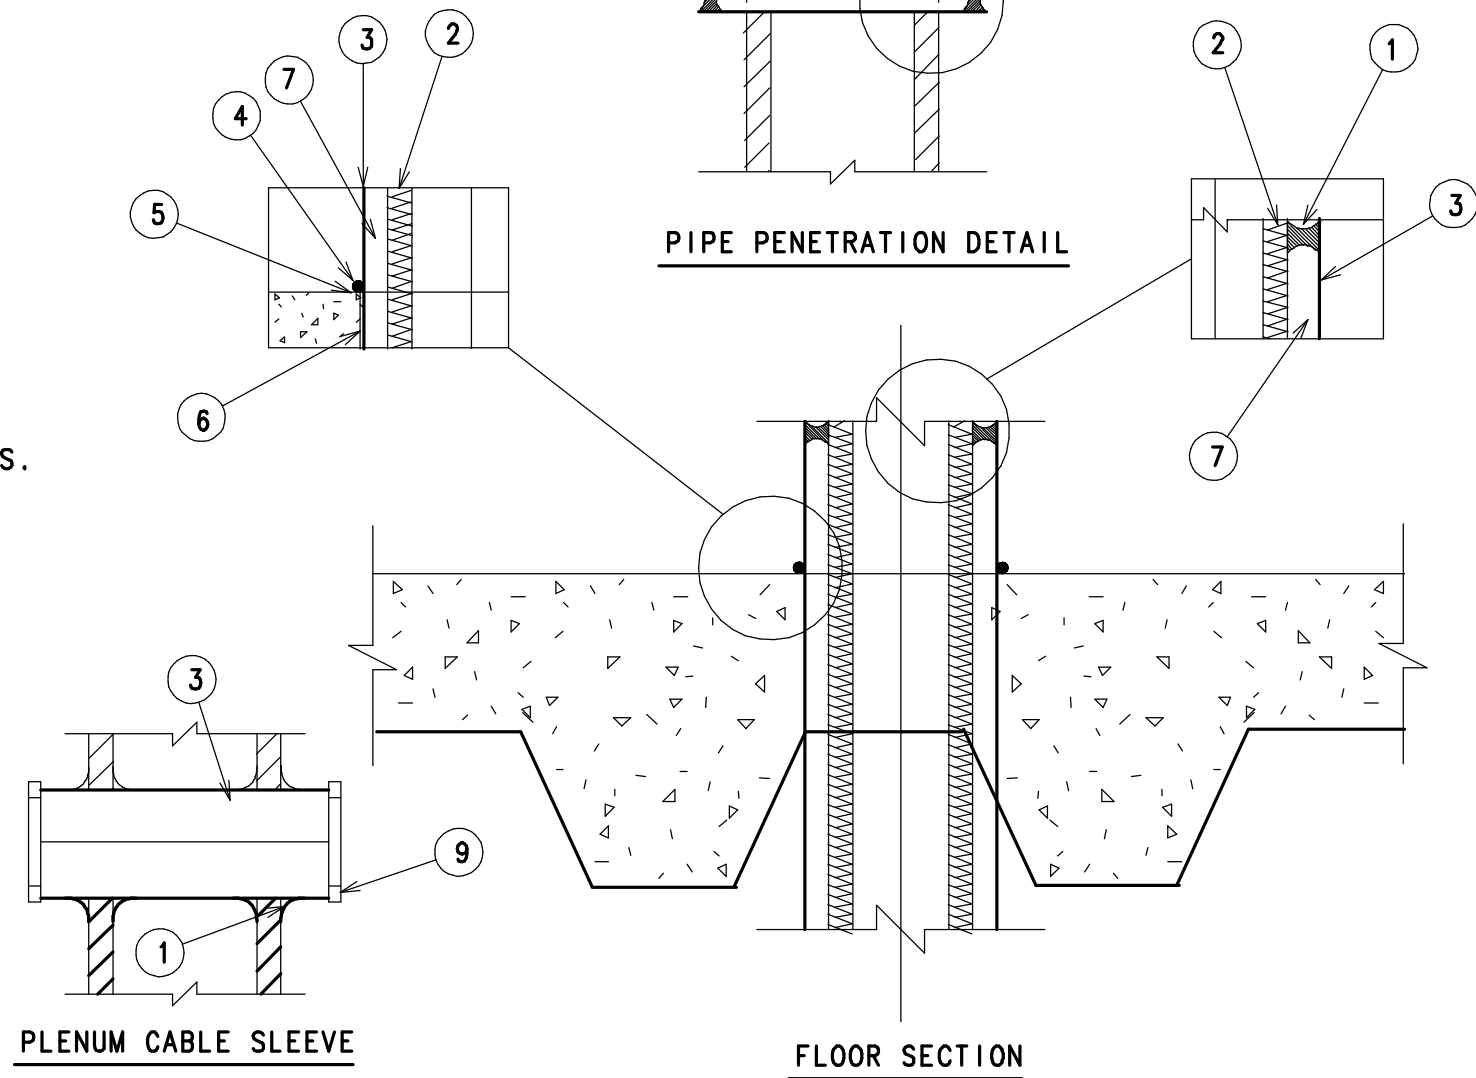

PIPE SLEEVE THRU FLOOR DETAIL

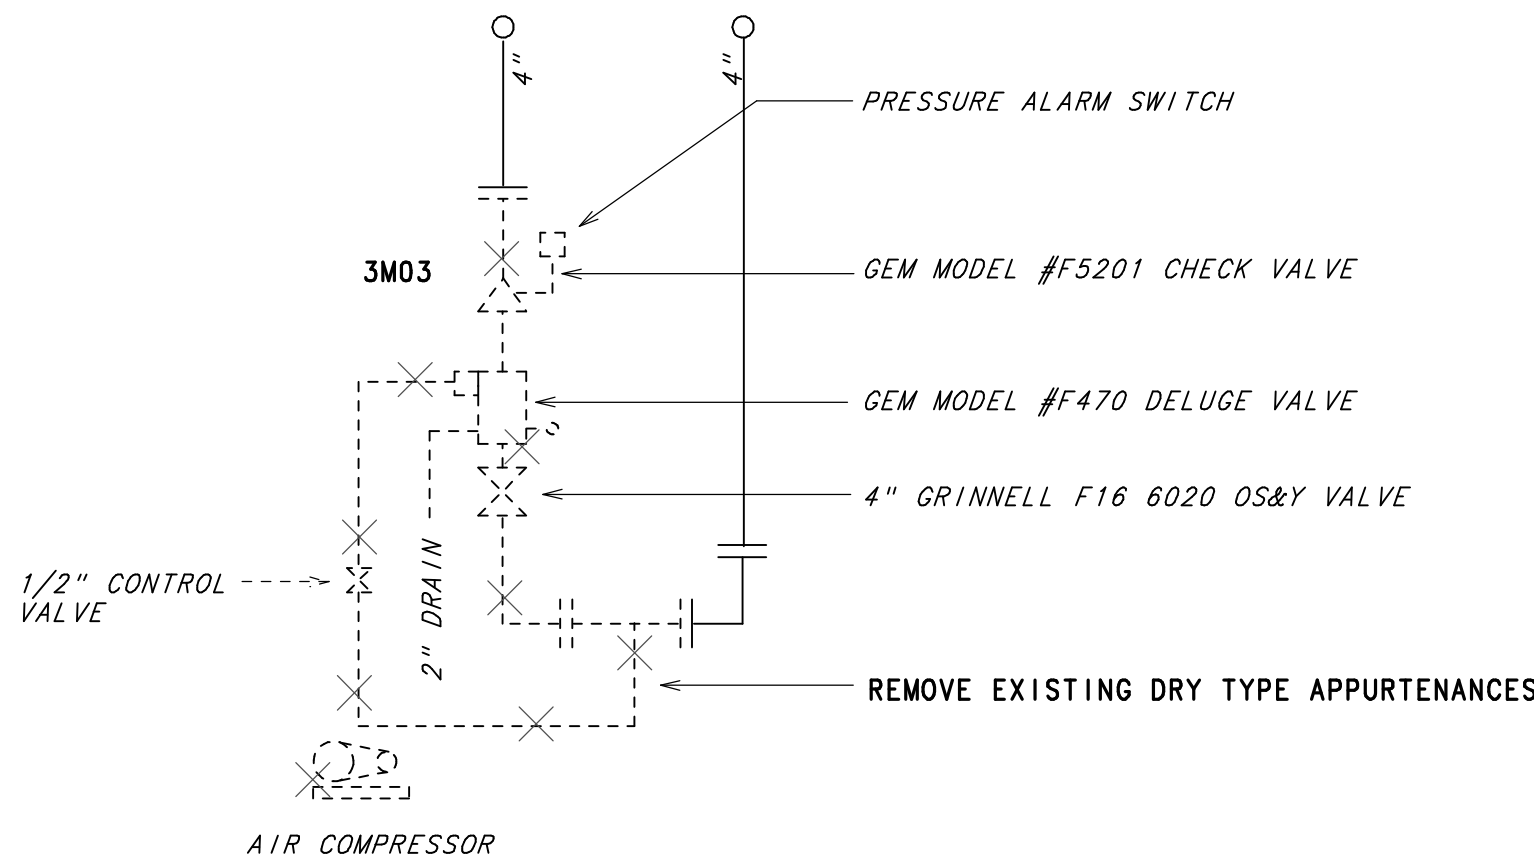

EXISTING DRY TYPE 2ND FLOOR FIRE SUPPRESSION SYSTEM

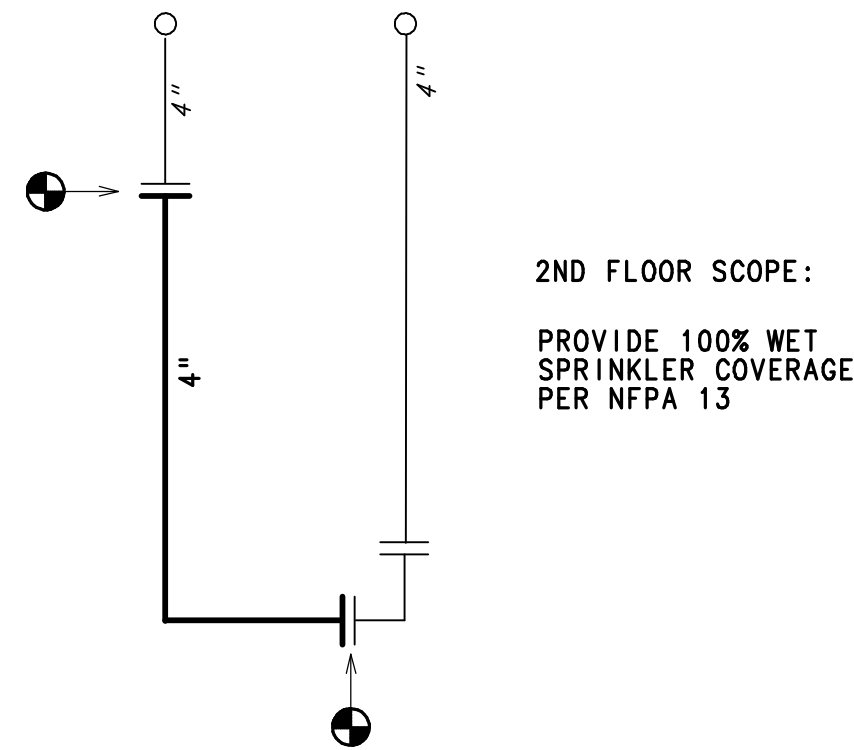

NEW FIRE SUPPRESSION SCOPE 2M03

NOTE: PROVIDE FULL SIZE "SPOOL" PIPING TO REPLACE VALVES REMOVED.


WATER CLOSET WC'B'

FIXTURE: KOHLER K-4325 KINGSTON, WALL HUNG, 1.28 GPF ELONGATED BOWL, SIPHON JET, WITH CLOSET CARRIER FITTING AND CHROME MOUNTING BOLTS.


COLOR: WHITE

BEMIS 1955 SSCT WHITE OPEN FRONT ELONGATED

ROUGH-IN:	CW	HW	WASTE	VENT
	1-1/2"	- - -	4"	2"

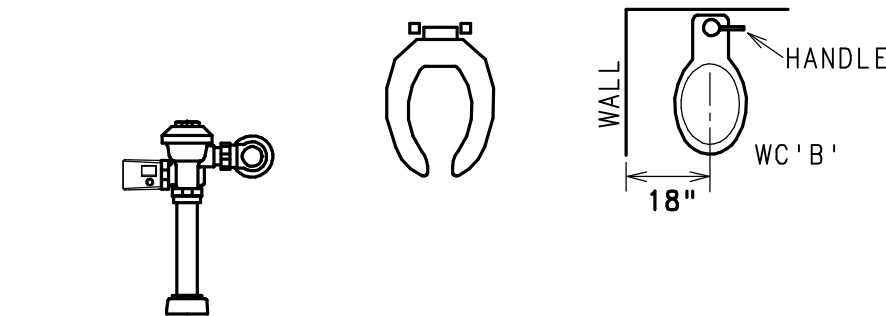

FLUSH VALVE - ROYAL OPTIMA SMO MODEL 111-1.28 GPF HET BATTERY POWER SENSOR

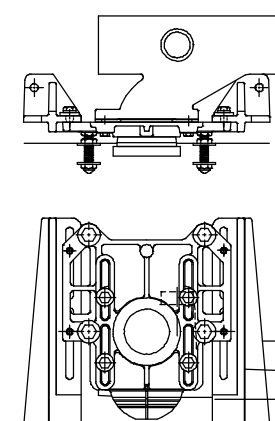

CARRIER RATED CAPACITY - 750 LBS WADE 330XH ADJUSTABLE HORIZONTAL

LAVATORY L'A'

FIXTURE: KOHLER K-2196 PENNINGTON, VITREOUS CHINA 20"x17" SELF RIM, WITH 4" DRILLINGS. TAS COMPLIANT.

STRAINER: KOHLER K-8801 STRAINER AND CRUMB CUP


TAILPIECE: KOHLER K-13885 PERFORATED GRID WITH OFFSET DRAIN.

P-TRAP: KOHLER K-8998 WITH TUBING WASTE AND ESCUTCHEON.


STOPS: BRASSCRAFT KTOR19-C1 WITH FLEXIBLE CHROME RISERS AND QUARTER-TURN HANDLE OPERATION STOPS.

INSULATION: TRUEBRO 102W INSULATION FOR P-TRAP, OFFSET TAILPIECE, AND HOT AND COLD SUPPLIES.

TEMPERATURE LIMITING VALVE: LEONARD 170-LF ASSE 1070 COMPLIANT

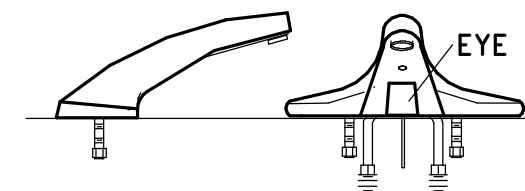

FAUCET: SLOAN OPTIMA SENSOR FAUCET EBF-650 ADA, BATTERY POWERED

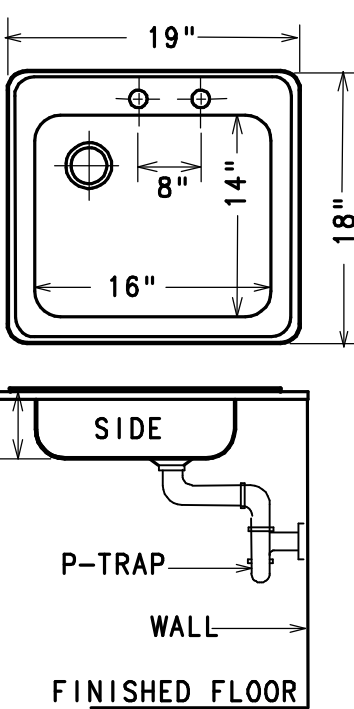

SINK S'A'

FIXTURE: ELKAY LRAD-1918-L, SINGLE COMPARTMENT, 18 GAGE TYPE 302 SELF RIMMING STAINLESS STEEL, MODIFIED WITH TWO FAUCET HOLES ON 8" CENTERS. FOR ADA SINK LOCATIONS, PROVIDE REAR OUTLET WASTE CONFIGURATION SO AS NOT TO CONFLICT WITH ADA KNEE PANEL(S).

STRAINER: KOHLER K-8801 STRAINER AND CRUMB CUP



P-TRAP: KOHLER K-9000 WITH TUBING WASTE AND ESCUTCHEON

STOPS: BRASSCRAFT QUARTER TURN 1/2" AND 3/8" COMPRESSION OUT

RISERS: FLEXIBLE BRAIDED STAINLESS STEEL RISERS

INSULATION: TRUEBRO 102W FOR P-TRAP, OFFSET TAILPIECE, HOT AND COLD SUPPLIES

ROUGH-IN:	CW	HW	WASTE	VENT
	1/2"	1/2"	2"	2"

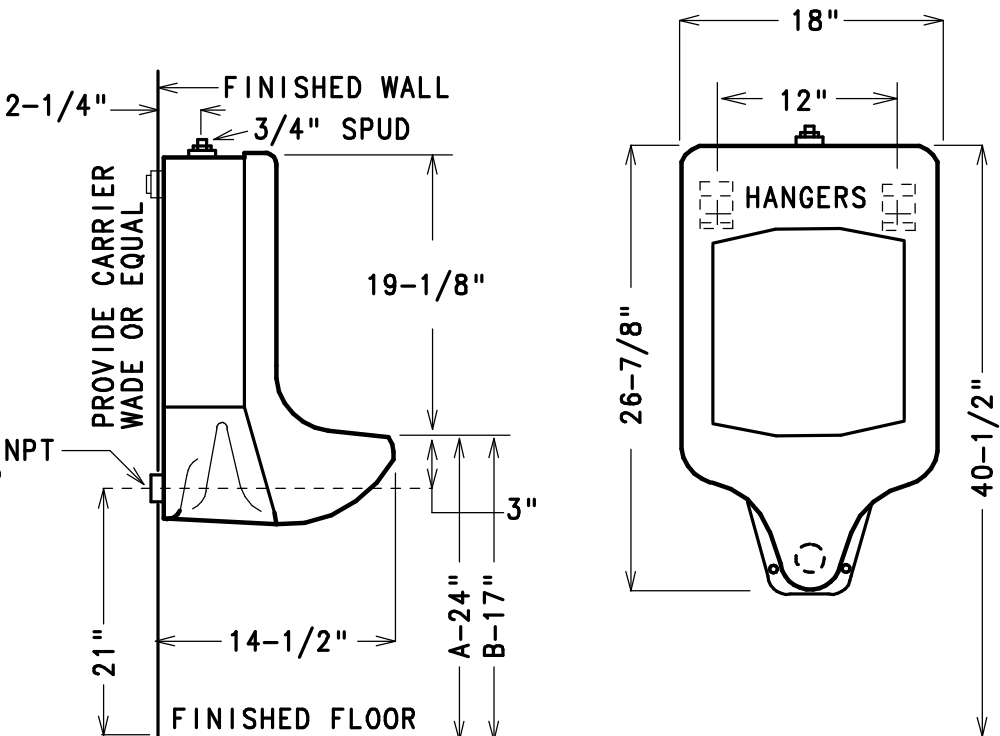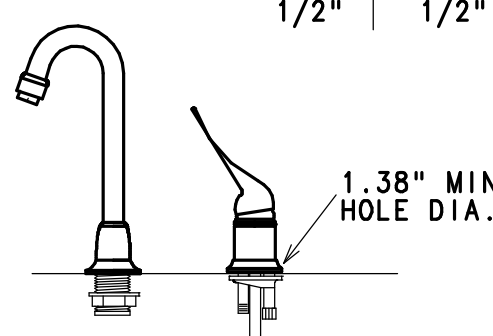


URINAL U'A' & U'B'


FIXTURE: KOHLER STANWELL URINAL K-4972-ET, VITREOUS CHINA, BLOWOUT, 3/4" TOP SPUD, 1 GPF

COLOR: WHITE

ROUGH-IN:	CW	HW	WASTE	VENT
	3/4"	-	3"	2"

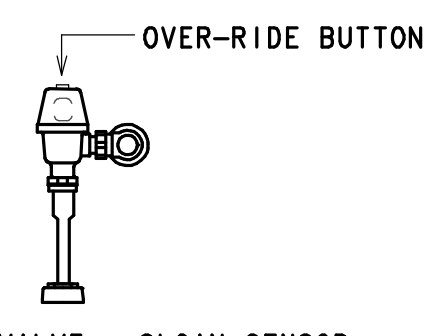

FLUSH VALVE - SLOAN SENSOR FLUSHOMETER 8186-1.0 GPF BATTERY POWER SENSOR

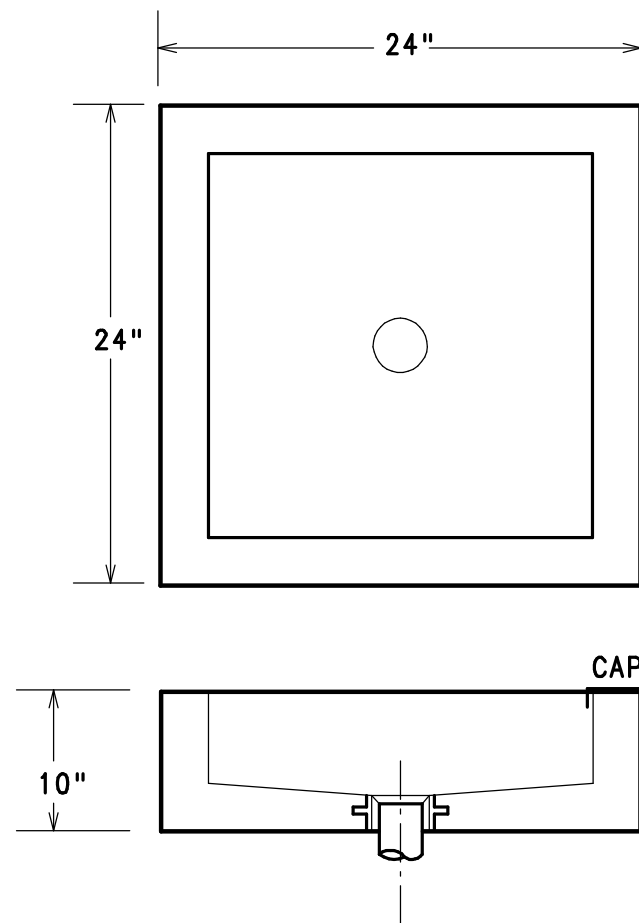


MOP BASIN 'MB'

FIXTURE: SWAN FIBERGLASS MOP SERVICE SINK MODEL #MS2424-3


DRAIN: 3" IPS CAST BRASS, NICKEL BRONZE STRAINER

TRAP: C.I. DEEP SEAL P-TRAP

ROUGH-IN:	CW	HW	WASTE	VENT
	1/2"	1/2"	3"	1-1/2"

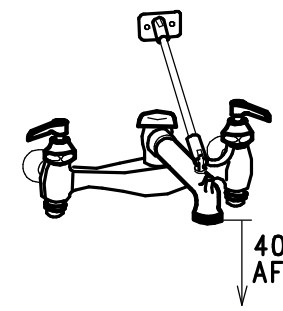


SUPPLY: DELTA 28T9 WITH VACUUM BREAKER, INTEGRAL STOPS, WALL BRACE, PAIL HOOK, 3/4" THREADED SPOUT AND 5' RUBBER HOSE WITH WALL HOSE HOOK.

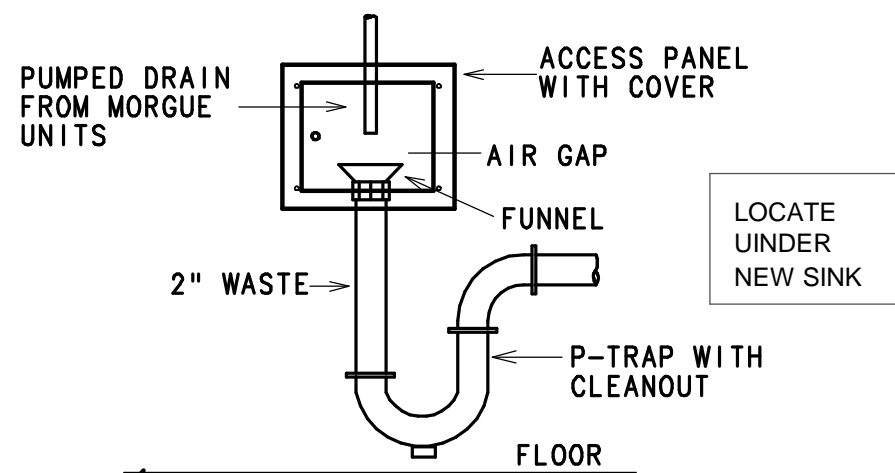

CONDENSATE DRAIN DETAIL 'HUB'

NO SCALE

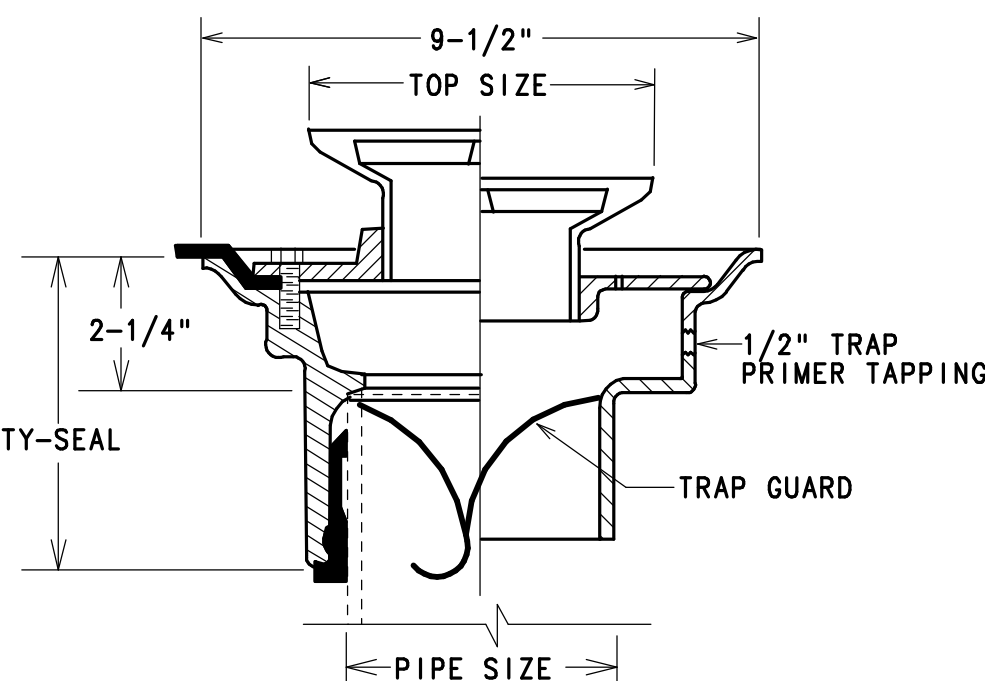

FLOOR DRAIN 'FD'

NO SCALE

FIXTURE: WADE W-1103-G, SQUARE NB TOP, WITH ADJUSTABLE STRAINERS, CI BODY AND DEEP SEAL P-TRAP.

NOTE: PROVIDE PRO SET - TRAP GUARD INSERT MODEL # - T633 WADE 3"

Page Southerland Page, Inc.
1800 Main Street Suite 123
Dallas, TX 75201
page@ink.com
TEL 214 522 3900
FAX 214 522 4380
ARCHITECTURE / ENGINEERING / INTERIORS / PLANNING / CONSULTING
Austin / Dallas / Denver / Dubai / Houston / Mexico City / Phoenix /
San Francisco / Washington DC / International Affiliate Offices

MEP ENGINEER
FANNING, FANNING & ASSOCIATES, INC.
2555 74th Street
Lubbock, Texas 79423
(806) 746-2533



TTUHSC Preston Smith Library
Renovation - Level 01/02
3601 4th Street, STOP 7781
Lubbock, TX 79430-7781

REVISION HISTORY

REVISION	DESCRIPTION	DATE
----------	-------------	------



PLUMBING SCHEDULES


DRAWN BY	CHECKED BY
PROJECT NUMBER 24028	PROJECT ABBREVIATION TTUHSC-PSL-01-02
ORIGINAL ISSUE	DATE
ISSUE FOR CONSTRUCTION	21 MAR 2025



TTUHSC Preston Smith Library
Renovation - Level 01/02
3601 4th Street, STOP 7781
Lubbock, TX 79430-7781

REVISION HISTORY

REVISION	DESCRIPTION	DATE
1	ADDENDUM 02	10 APR 2025

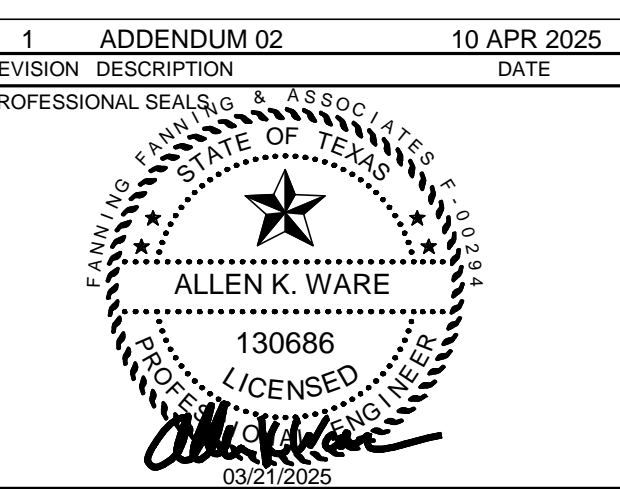

ELECTRICAL - LIGHTING PLAN
LEVEL 02

DRAWN BY	CHECKED BY
PROJECT NUMBER 24028	PROJECT ABBREVIATION TTUHSC-PSL-01-02
ORIGINAL ISSUE	DATE
ISSUE FOR CONSTRUCTION	21 MAR 2025

NOTES INDICATED BY "O":

- GRAPHIC CONTROL WALL STATION FOR ZONES 1-10.
- CONNECT EXIT LIGHT TO "LP-2C-2" WITH 2 #12 & #12G IN 3/4" C.
- RECONNECT TO EXISTING LIGHTING CIRCUIT AND CONTROLS SERVING STAIRWELL LIGHTS.
- CONNECT TO NEW 20A-1P BREAKER IN PANEL "LP-2A" WITH 2 #12 & #12G IN 3/4" C. INSTALL NEW BREAKER IN OPEN SPACE. NEW BREAKER TO MATCH EXISTING.
- RECONNECT TO EXISTING LIGHTING CIRCUIT SERVING THIS AREA WITH 2 #12 & #12G IN 3/4" C.
- BOOK CASE LIGHT DRIVER TO BE INSTALLED ABOVE CEILING. REFER TO LIGHT FIXTURE SCHEDULE.
- LOW VOLTAGE DIMMER SWITCH SHALL BE LUTRON MA-PRO-WH.
- ALTERNATE O2. REFER TO ARCHITECTURAL DRAWINGS.
- ZONE TO BE CONTROLLED BY DAYLIGHT SENSOR.
- CONNECT NEW EXIT LIGHT TO EXISTING EXIT LIGHT CIRCUIT SERVING THIS AREA. WITH 2 #12 & #12G IN 3/4" C.
- NOTE NOT USED.
- CONNECT EXIT LIGHT TO "LP-2B-2" WITH 2 #12 & #12G IN 3/4" C.
- BOTTOM OF FIXTURE TO BE MOUNTED AT 10'-6" AFF.

NOTE: THE LIGHTING DRAWINGS DOES NOT SHOW ALL REQUIRED WIRING AND EQUIPMENT FOR LIGHTING CONTROLS. SENSORS SHOWN ON THE DRAWINGS ARE DIAGRAMMATIC ONLY. SENSOR PLACEMENT AND QUANTITY SHALL BE DETERMINED BY THE MANUFACTURE FOR BEST LOCATION/COVERAGE. MANUFACTURER SHALL SUBMIT DRAWINGS IN SUBMITTAL PHASE INDICATING SENSOR PLACEMENT AND COVERAGE FOR EACH SENSOR. THESE APPROVED SUBMITTAL DRAWINGS SHALL BECOME THE INSTALLATION DRAWINGS FOR THE LIGHTING CONTROL SYSTEM. ALL ROOMS SHALL HAVE FULL OCCUPANCY SENSOR COVERAGE.

NOTE: LIGHTS IN OPEN STUDY AND COMMUNICATING SPACE TO DIM TO 25% WHEN NO MOTION IS DETECTED. INCREASE LIGHT LEVEL TO 100% WHEN MOTION IS DETECTED.

NOTE: ALL PENETRATIONS IN WALL BETWEEN COMMUNICATING SPACE AND OTHER ROOMS TO BE SEALED WITH UL LISTED MATERIALS FOR 1-HR FIRE RATED ASSEMBLY.

ELECTRICAL NEW LIGHTING FLOOR PLAN - LEVEL 02

GRAPHIC SCALE: 1/8"=1'-0"






TTUHSC Preston Smith Library
Renovation - Level 01/02
3601 4th Street, STOP 7781
Lubbock, TX 79430-7781


REVISION HISTORY

REVISION	DESCRIPTION	DATE
1	ADDENDUM 02	10 APR 2025

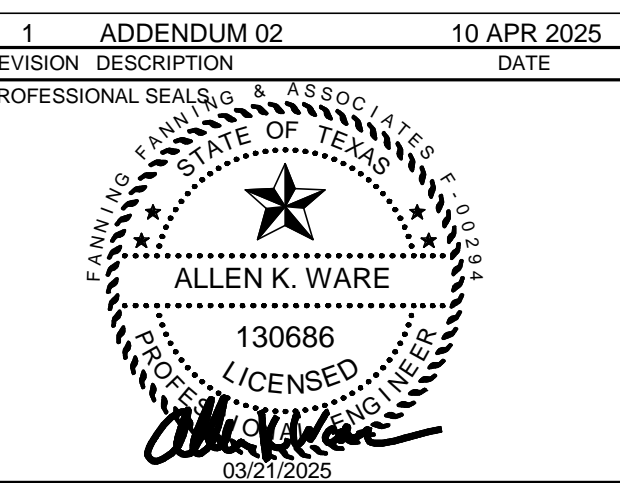

ELECTRICAL - POWER PLAN
LEVEL 01

DRAWN BY	CHECKED BY
PROJECT NUMBER 24028	PROJECT ABBREVIATION TTUHSC-PSL-01-02
ORIGINAL ISSUE	DATE
ISSUE FOR CONSTRUCTION	21 MAR 2025

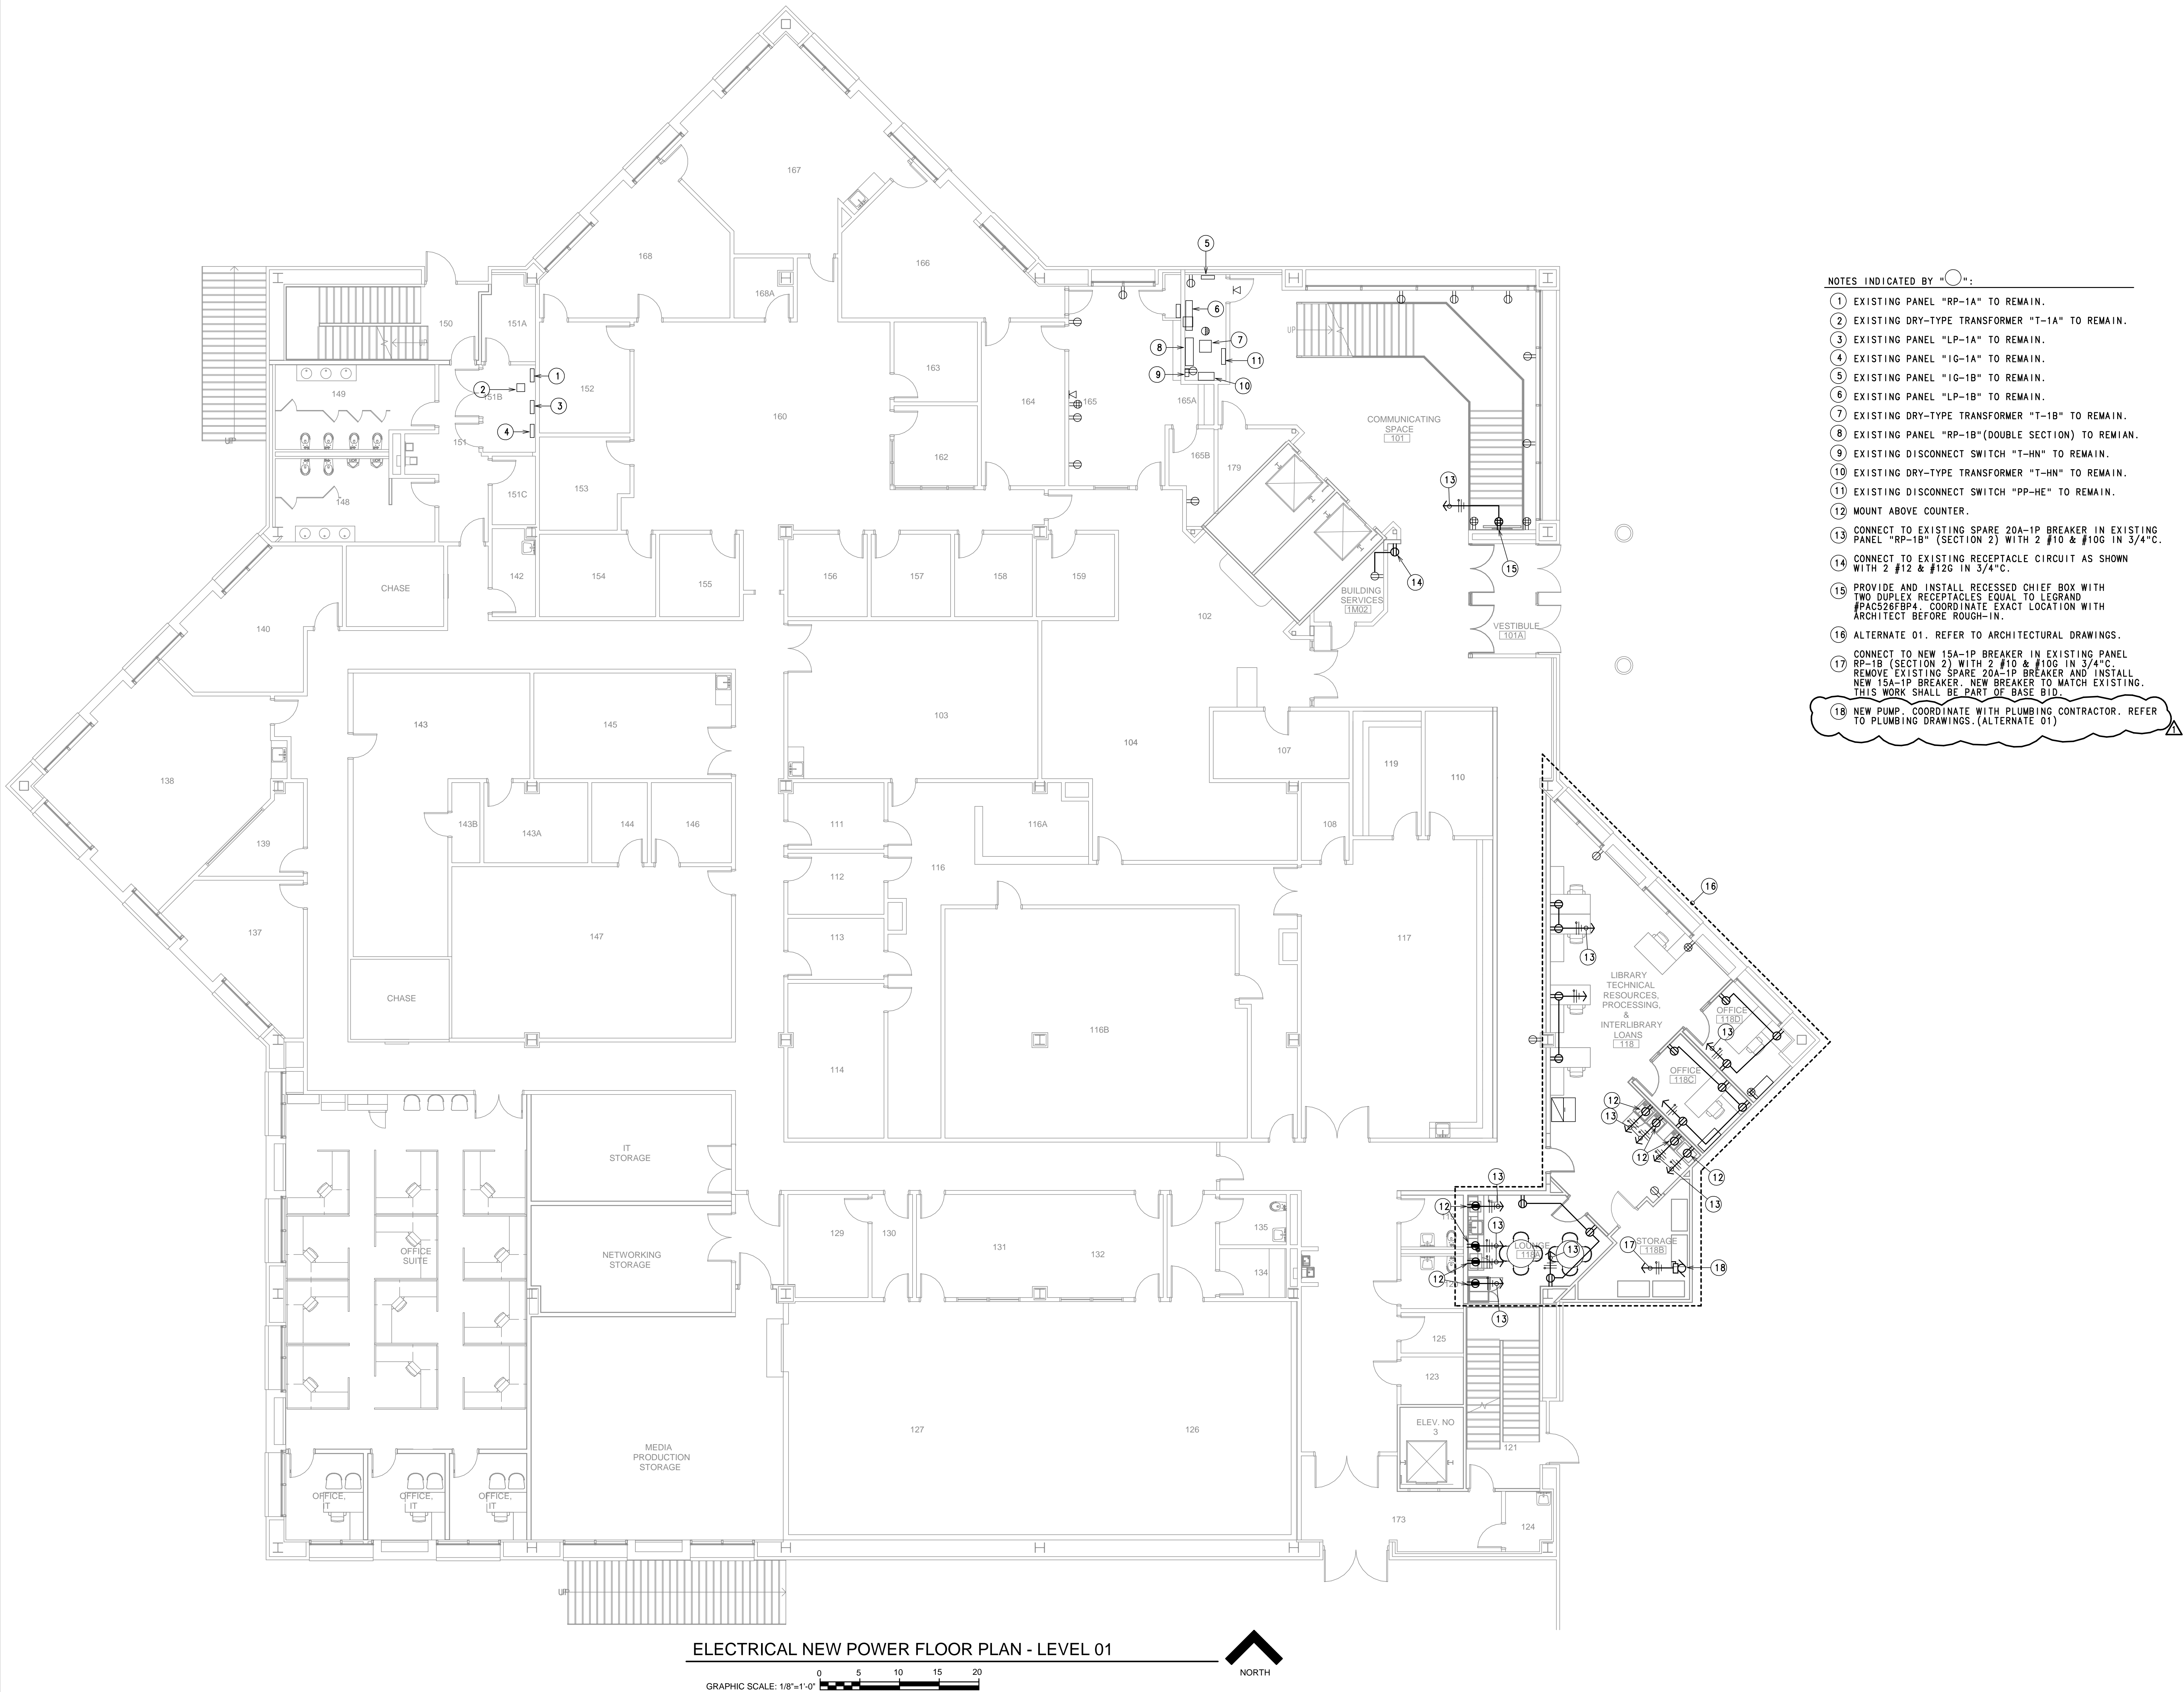


- NOTES INDICATED BY "○":
- EXISTING PANEL "RP-1A" TO REMAIN.
 - EXISTING DRY-TYPE TRANSFORMER "T-1A" TO REMAIN.
 - EXISTING PANEL "LP-1A" TO REMAIN.
 - EXISTING PANEL "IG-1A" TO REMAIN.
 - EXISTING PANEL "IG-1B" TO REMAIN.
 - EXISTING PANEL "LP-1B" TO REMAIN.
 - EXISTING DRY-TYPE TRANSFORMER "T-1B" TO REMAIN.
 - EXISTING PANEL "RP-1B"(DOUBLE SECTION) TO REMIAN.
 - EXISTING DISCONNECT SWITCH "T-HN" TO REMAIN.
 - EXISTING DRY-TYPE TRANSFORMER "T-HN" TO REMAIN.
 - EXISTING DISCONNECT SWITCH "PP-HE" TO REMAIN.
 - MOUNT ABOVE COUNTER.
 - CONNECT TO EXISTING SPARE 20A-1P BREAKER IN EXISTING PANEL "RP-1B" (SECTION 2) WITH 2 #10 & #10G IN 3/4"C.
 - CONNECT TO EXISTING RECEPTACLE CIRCUIT AS SHOWN WITH 2 #12 & #12G IN 3/4"C.
 - PROVIDE AND INSTALL RECESSED CHIEF BOX WITH TWO DUPLEX RECEPTACLES EQUAL TO LEGRAND #PAC526FBP4. COORDINATE EXACT LOCATION WITH ARCHITECT BEFORE ROUGH-IN.
 - ALTERNATE 01. REFER TO ARCHITECTURAL DRAWINGS.
 - CONNECT TO NEW 15A-1P BREAKER IN EXISTING PANEL RP-1B (SECTION 2) WITH 2 #10 & #10G IN 3/4"C. REMOVE EXISTING SPARE 20A-1P BREAKER AND INSTALL NEW 15A-1P BREAKER. NEW BREAKER TO MATCH EXISTING. THIS WORK SHALL BE PART OF BASE BID.
 - NEW PUMP. COORDINATE WITH PLUMBING CONTRACTOR. REFER TO PLUMBING DRAWINGS. (ALTERNATE 01)



TTUHSC Preston Smith Library
Renovation - Level 01/02
3601 4th Street, STOP 7781
Lubbock, TX 79430-7781

REVISION HISTORY

REVISION	DESCRIPTION	DATE
1	ADDENDUM 02	10 APR 2025

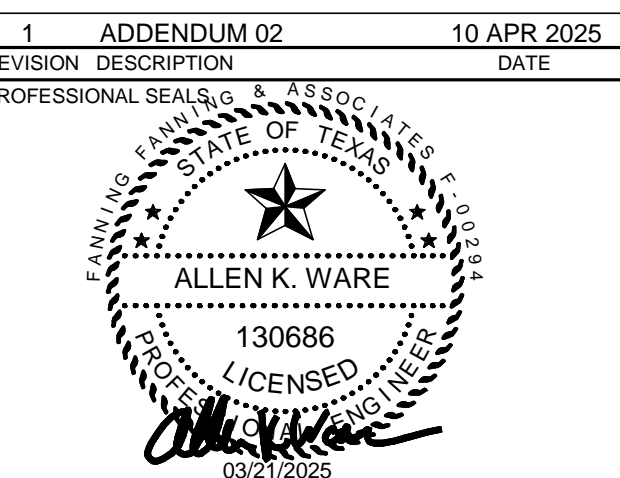

ELECTRICAL - POWER PLAN
LEVEL 02

DRAWN BY	CHECKED BY
PROJECT NUMBER 24028	PROJECT ABBREVIATION TTUHSC-PSL-01-02
ORIGINAL ISSUE	DATE
ISSUE FOR CONSTRUCTION	21 MAR 2025

E-202

SHEET NUMBER

NOTES INDICATED BY "O":

- EXISTING PANEL "RP-2A" TO REMAIN (2 SECTION).
- EXISTING PANEL "LP-2A" TO REMAIN.
- EXISTING PANEL "IG-2A" TO REMAIN.
- EXISTING DRY-TYPE TRANSFORMER "T-2A" TO REMAIN.
- EXISTING PANEL "LP-2B" TO REMAIN.
- EXISTING PANEL "RP-2B" TO REMAIN.
- EXISTING DRY-TYPE TRANSFORMER "T-2B" TO REMAIN.
- EXISTING PANEL "20PB" TO REMAIN.
- MOUNT ABOVE COUNTER.
- CONNECT TO SPARE 20A-1P BREAKER IN EXISTING PANEL "RP-2A" WITH 2 #12 & #12G IN 3/4" C.
- SURFACE ALUMINUM RACEWAY EQUAL TO WIREMOLD #44AB00 SERIES. PROVIDE AND INSTALL THREE DUPLEX RECEPTACLES IN TOP CHANNEL OF RACEWAY AND SIX DATA OUTLETS IN BOTTOM CHANNEL OF RACEWAY. PROVIDE AND INSTALL ALL DEVICES, PLATES AND FITTINGS REQUIRED FOR A COMPLETE ASSEMBLY. MOUNT ABOVE COUNTER.
- CONNECT TO NEW 20A-2P BREAKER IN EXISTING PANEL "RP-2A" WITH 3 #12 & #12G IN 3/4" C. CONNECT THREE DUPLEX RECEPTACLES PER CIRCUIT. REMOVE TWO EXISTING 20A-1P BREAKERS AND INSTALL NEW 20A-2P BREAKER. NEW BREAKER TO MATCH EXISTING.
- FIRE RATED POKE-THRU EQUAL TO WIREMOLD #6ATC2. (BRUSH ALUMINUM FINISH). PROVIDE AND INSTALL ALL PLATES, DEVICES, COVERS, ETC. AS REQUIRED FOR A COMPLETE ASSEMBLY. COORDINATE EXACT LOCATION WITH ARCHITECT BEFORE ROUGH-IN.
- NEW PANEL "LP-2C".
- NEW DRY-TYPE TRANSFORMER "T-2C".
- NEW PANEL "RP-2C".
- PROVIDE AND INSTALL RECESSED CHIEF BOX WITH TWO DUPLEX RECEPTACLES EQUAL TO LEGRAND #PAC526FBP4. COORDINATE EXACT LOCATION WITH ARCHITECT BEFORE ROUGH-IN.
- MOUNT BEHIND MONITOR. COORDINATE EXACT LOCATION WITH ARCHITECT.
- NEW COMMUNICATIONS GROUNDING BAR. REFER TO GROUND BAR DETAIL. COORDINATE EXACT LOCATION WITH OWNER.
- FIRE RATED POKE-THRU TO BE EQUAL TO LEGRAND EVOLUTION SERIES #44ATPARAA (BRUSH ALUMINUM FINISH). PROVIDE WITH TWO DUPLEX RECEPTACLES AS INDICATED ON THE DRAWINGS. PROVIDE AND INSTALL ALL COVERS, PLATES, DEVICES, ETC AS REQUIRED FOR COMPLETE ASSEMBLY. (TYPICAL).
- J-BOX FOR BRANDING WALL TO BE INSTALLED ABOVE CEILING. COORDINATE EXACT LOCATION WITH OWNER AND/OR ARCHITECT.
- CONNECT CARD READER. COORDINATE EXACT REQUIREMENTS WITH OWNER.
- CONNECT ELECTRONIC WALL SCHEDULE TO RP2C-60. COORDINATE EXACT LOCATION WITH ARCHITECT.
- EXISTING FIRE RATED-POKE THRU TO REMAIN. REMOVE EXISTING RECEPTACLES AND REPLACE WITH NEW. RECONNECT AS SHOWN. PROVIDE AND INSTALL NEW COVER MATCHING NEW POKE-THRU.
- ALTERNATE 02. REFER TO ARCHITECTURAL DRAWINGS.

GENERAL NOTE: ALL FLOOR BOXES TO BE APPROVED ON SITE BY OWNER, ARCHITECT, AND ENGINEER BEFORE INSTALLATION. EXACT LOCATIONS TO BE COORDINATED WITH ARCHITECT.

NOTE: ALL PENETRATIONS IN WALL BETWEEN COMMUNICATING SPACE AND OTHER ROOMS TO BE SEALED WITH UL LISTED MATERIALS FOR 1-HOUR FIRE RATED ASSEMBLY.

ELECTRICAL NEW POWER FLOOR PLAN - LEVEL 02

GRAPHIC SCALE: 1/8"=1'-0"






TTUHSC Preston Smith Library
Renovation - Level 01/02
3601 4th Street, STOP 7781
Lubbock, TX 79430-7781

REVISION HISTORY

REVISION	DESCRIPTION	DATE
1	ADDENDUM 02	10 APR 2025


PROFESSIONAL SEAL OF THE STATE OF TEXAS

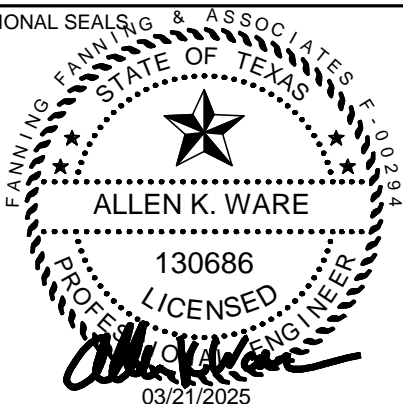

ELECTRICAL - MECHANICAL
CONNECTION PLAN - LEVEL 01

DRAWN BY	CHECKED BY
PROJECT NUMBER 24028	PROJECT ABBREVIATION TTUHSC-PSL-01-02
ORIGINAL ISSUE	DATE
ISSUE FOR CONSTRUCTION	21 MAR 2025

E-203
SHEET NUMBER

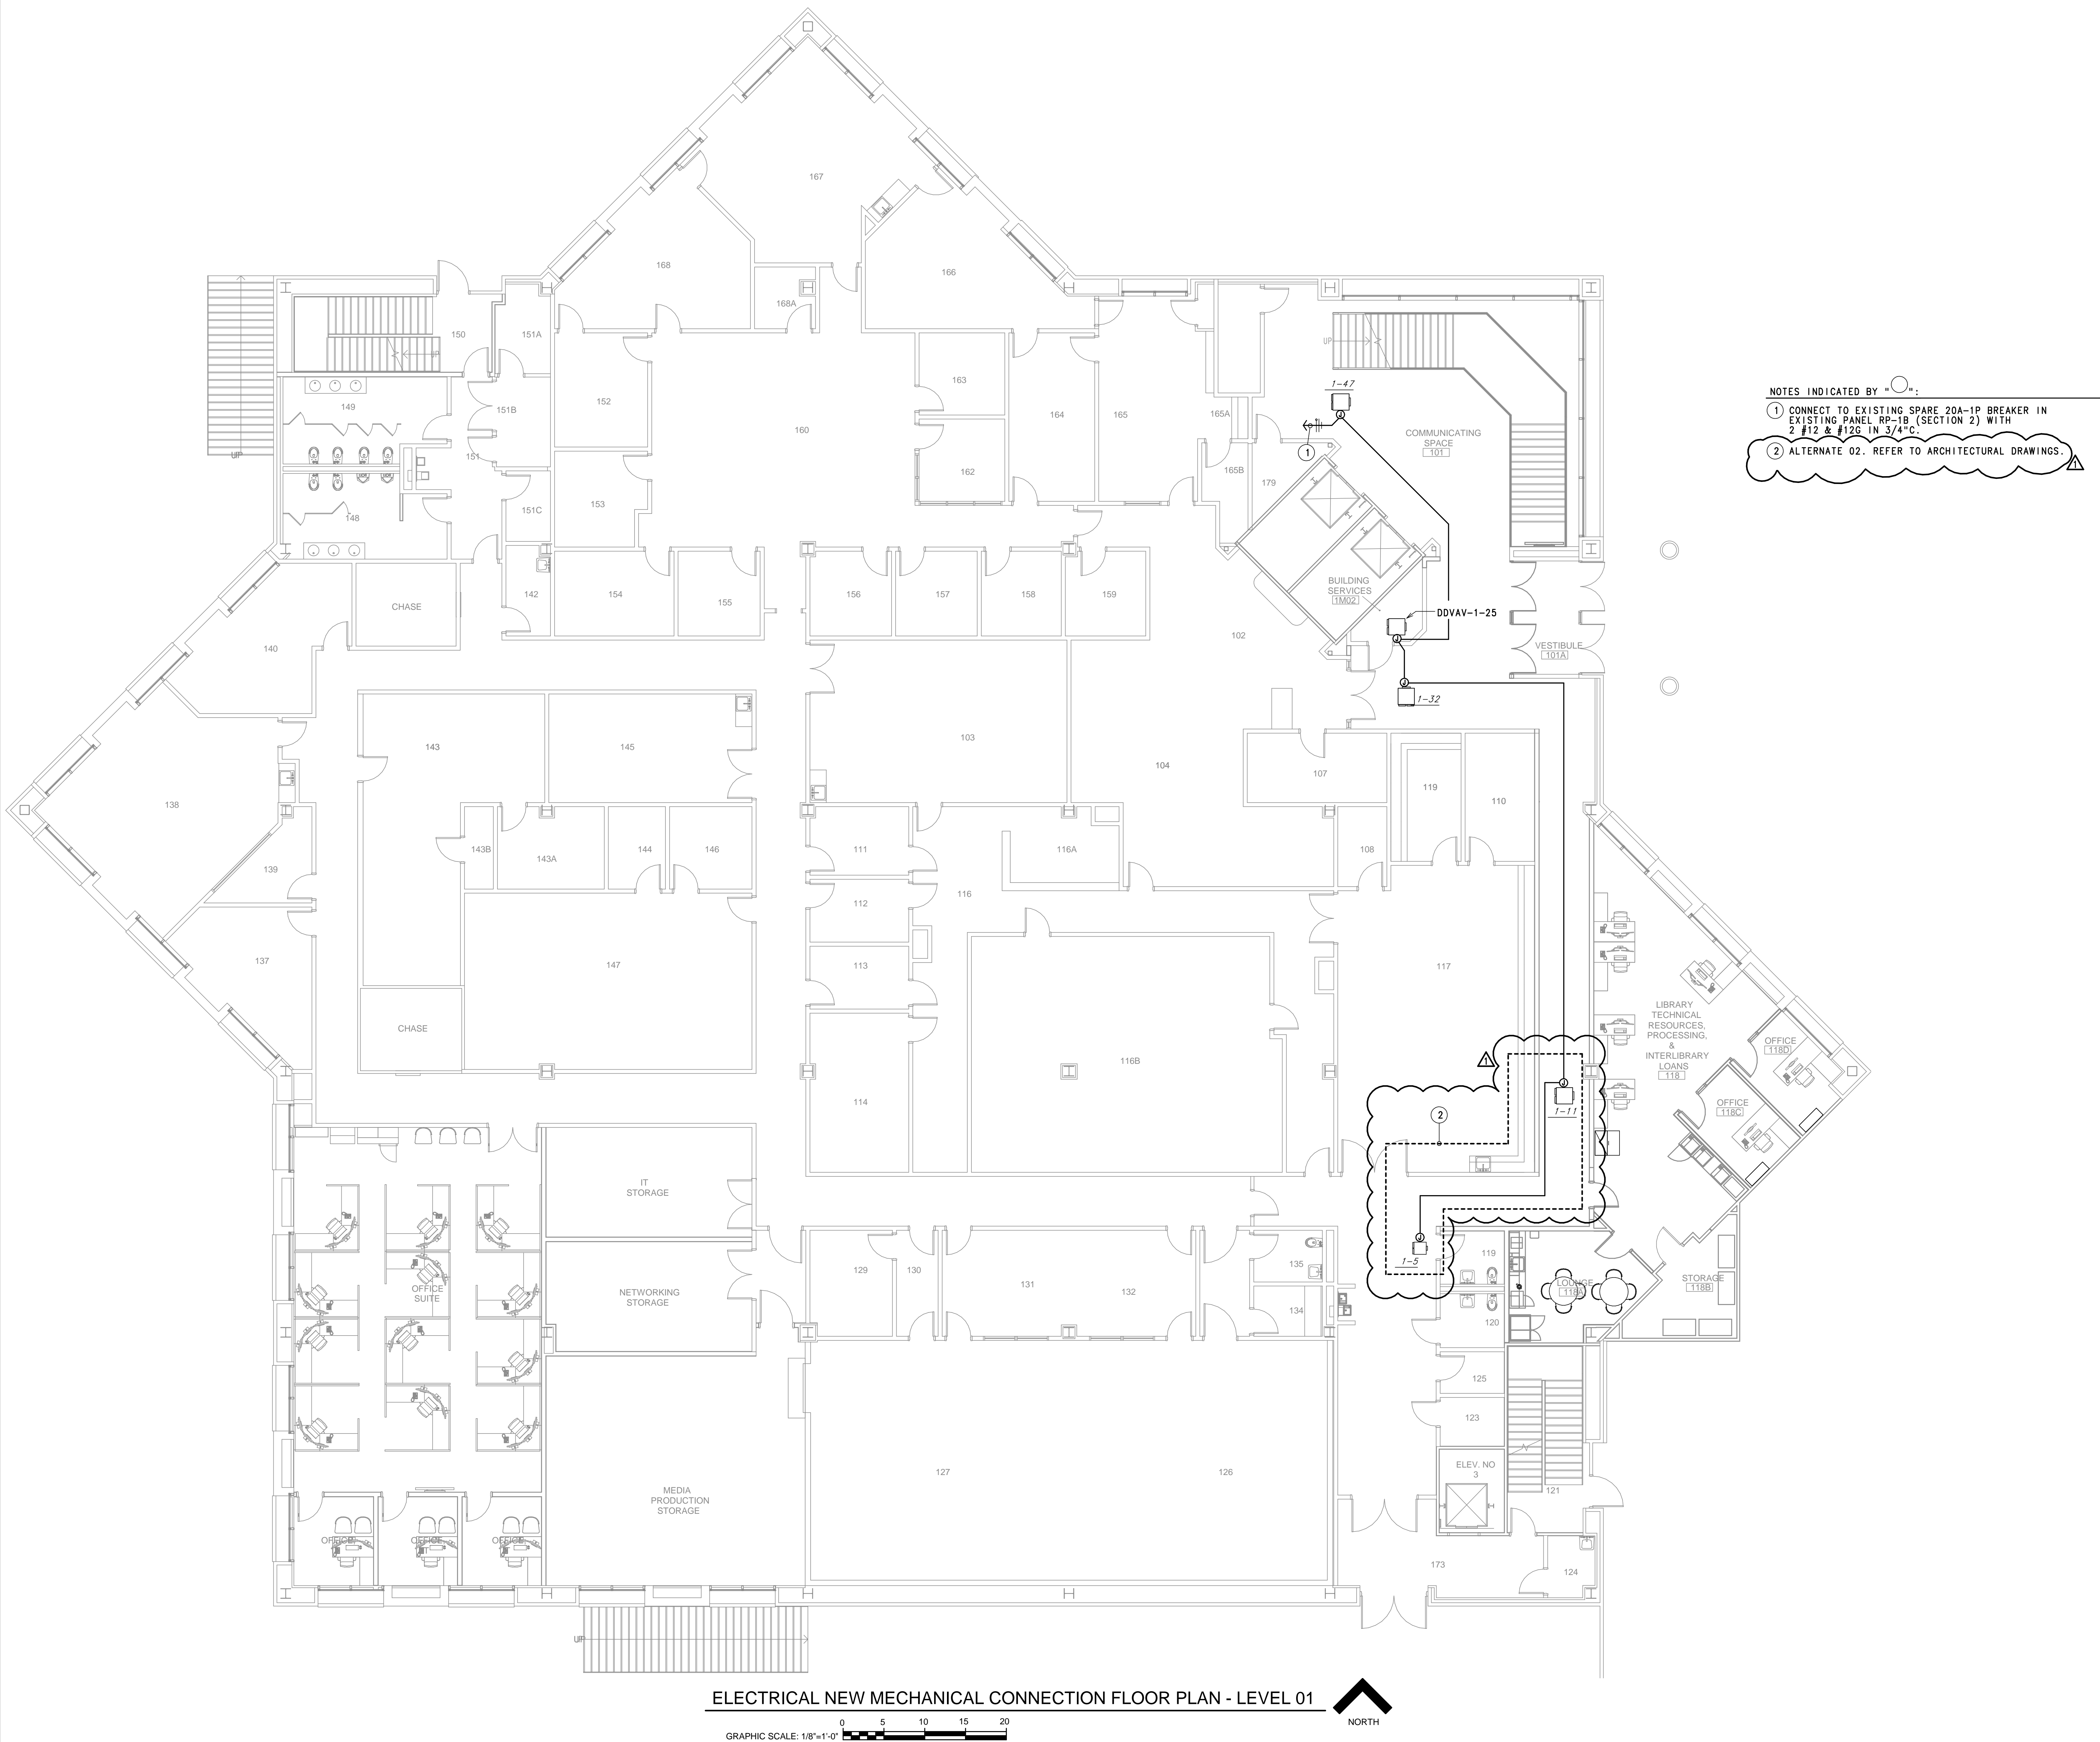



TTUHSC Preston Smith Library
Renovation - Level 01/02
3601 4th Street, STOP 7781
Lubbock, TX 79430-7781

- NOTES INDICATED BY "○":
- 1 CONNECT TO EXISTING SPARE 20A-1P BREAKER IN EXISTING PANEL "RP2A" WITH 2 #12 & #12G IN 3/4"C.
 - 2 CONNECT TO NEW 35A-3P BREAKER IN EXISTING DISTRIBUTION PANEL "2DPB" WITH 3 #8 & #10G IN 3/4"C.
 - 3 CONNECT TO SPARE 20A-1P BREAKER IN EXISTING PANEL "RP-3C" WITH 2 #12 & #12G IN 3/4"C.
 - 4 REFER TO MECHANICAL DRAWINGS FOR ALL SMOKE DAMPER LOCATIONS IN THIS WALL. CONNECT HALF OF THE SMOKE DAMPERS TO "RP2B"-38 AND THE OTHER HALF TO "RP2B"-39.
 - 5 ALTERNATE 02. REFER TO ARCHITECTURAL DRAWINGS. MECHANICAL CONNECTION WORK SHOWN IN THIS AREA TO BE IDENTICAL UNDER BASE BID AND ALTERNATE 02.

NOTE: ALL PENETRATIONS IN WALL BETWEEN COMMUNICATING SPACE AND OTHER ROOMS TO BE SEALED WITH UL LISTED MATERIALS FOR 1-HOUR FIRE RATED ASSEMBLY.


ELECTRICAL NEW MECHANICAL CONNECTION FLOOR PLAN - LEVEL 02

GRAPHIC SCALE: 1/8"=1'-0"



REVISION HISTORY

REVISION	DESCRIPTION	DATE
1	ADDENDUM 02	10 APR 2025

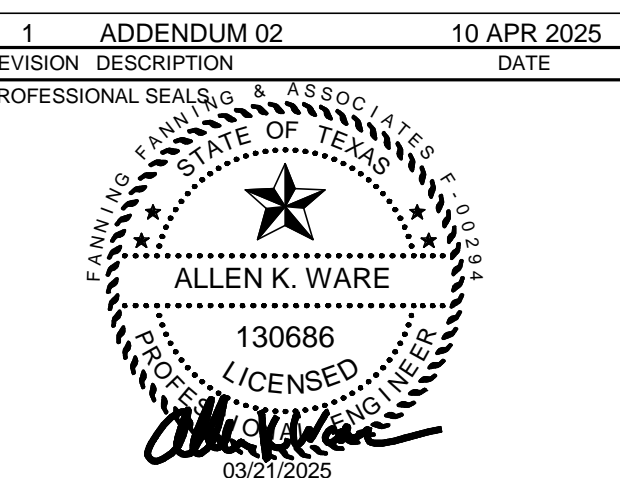

ELECTRICAL - MECHANICAL
CONNECTION PLAN - LEVEL 02

DRAWN BY	CHECKED BY
PROJECT NUMBER 24028	PROJECT ABBREVIATION TTUHSC-PSL-01-02
ORIGINAL ISSUE	DATE
ISSUE FOR CONSTRUCTION	21 MAR 2025

E-204


SHEET NUMBER



TTUHSC Preston Smith Library
Renovation - Level 01/02
3601 4th Street, STOP 7781
Lubbock, TX 79430-7781

REVISION HISTORY

REVISION	DESCRIPTION	DATE
1	ADDENDUM 02	10 APR 2025

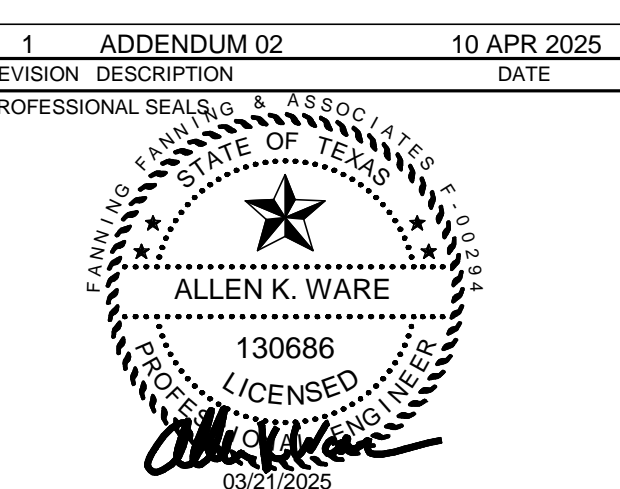


ELECTRICAL - COMMUNICATION
PLAN - LEVEL 02

DRAWN BY	CHECKED BY
PROJECT NUMBER 24028	PROJECT ABBREVIATION TTUHSC-PSL-01-02
ORIGINAL ISSUE	DATE
ISSUE FOR CONSTRUCTION	21 MAR 2025

E-302

SHEET NUMBER

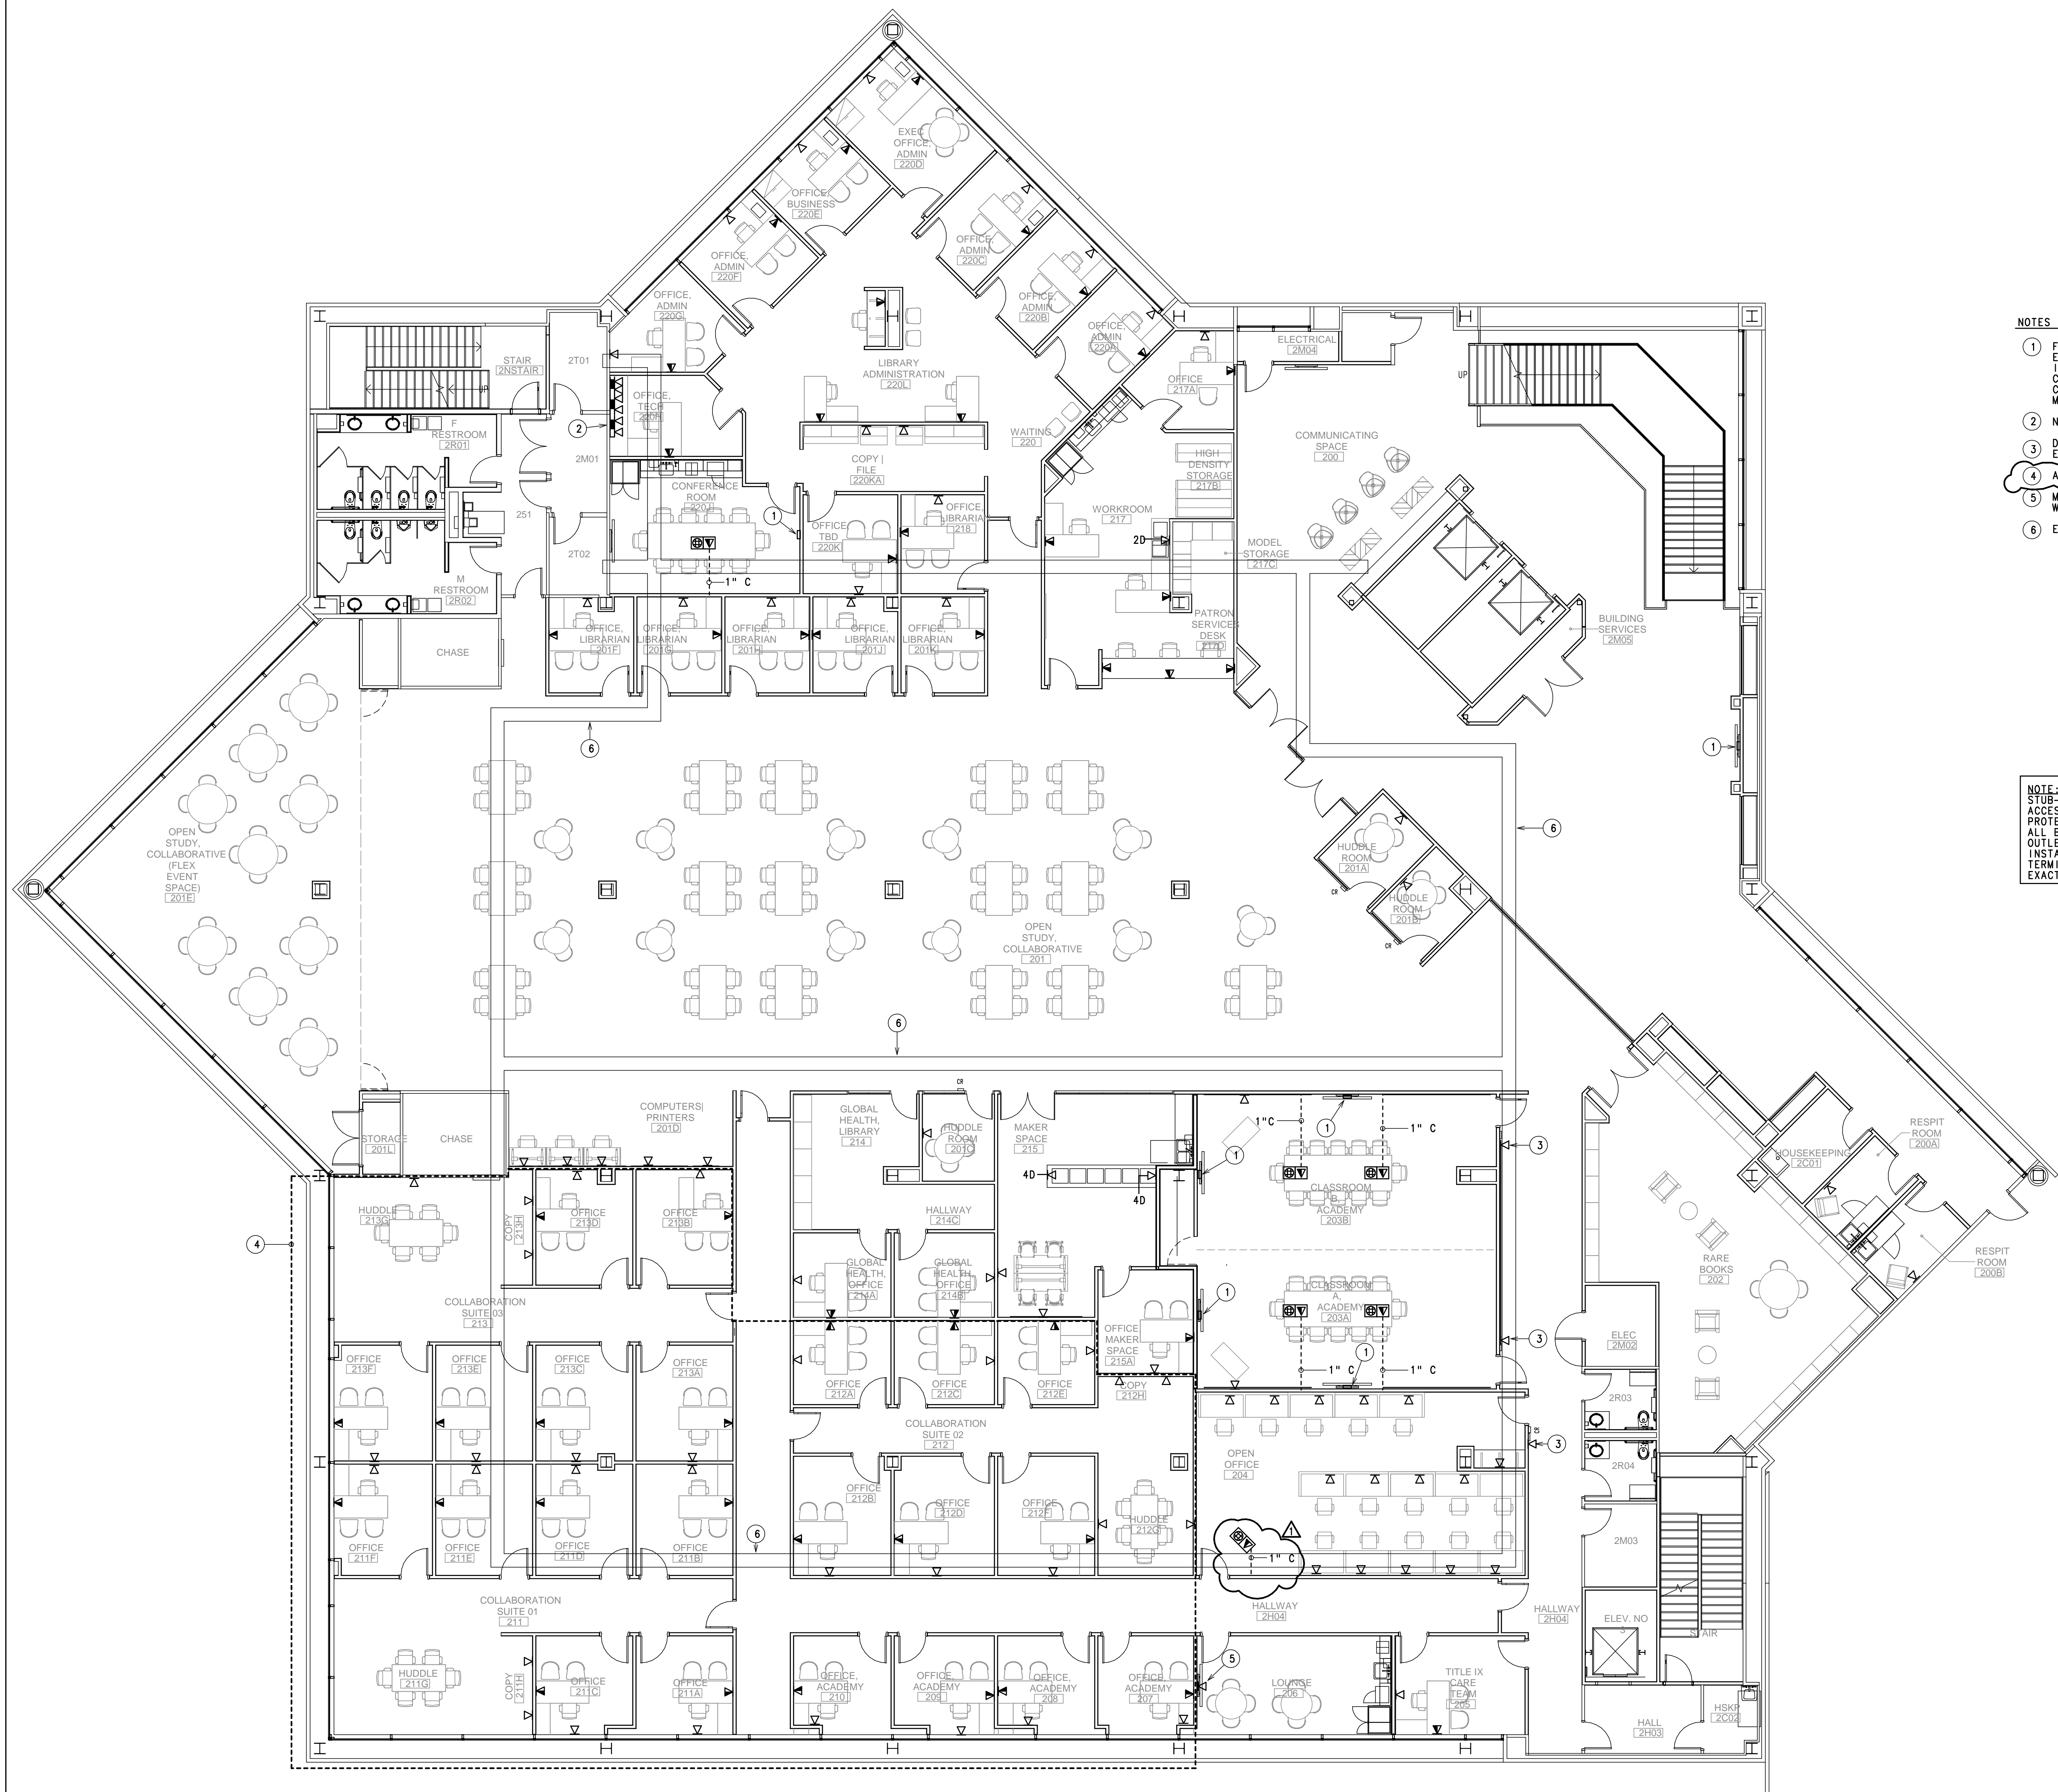

- NOTES INDICATED BY "○":
- 1 FLUSH MOUNTED CHIEF BOX, REFERENCE SHEET E202 NOTE 17. ROUTE 2 1" CONDUITS INSIDE WALL AND STUB-UP ABOVE CEILING AND INSTALL BUSHINGS TO PROTECT CABLES. REFER TO ARCHITECTURAL FOR EXACT MOUNTING HEIGHT.
 - 2 NEW SURFACE RACEWAY. REFER TO NEW POWER PLAN.
 - 3 DATA FOR ROOM ELECTRONIC SCHEDULE. COORDINATE EXACT LOCATION WITH ARCHITECT.
 - 4 ALTERNATE 02. REFER TO ARCHITECTURAL DRAWINGS.
 - 5 MOUNT BEHIND MONITOR. COORDINATE EXACT LOCATION WITH ARCHITECT.
 - 6 EXISTING CABLE TRAY.

NOTE: FROM EACH DATA AND TEL/DATA OUTLETS STUB-UP 3/4" C WITH PULL STRING TO ABOVE ACCESSIBLE CEILING AND INSTALL BUSHING TO PROTECT CABLE. ELECTRICAL CONTRACTOR TO PROVIDE ALL BOXES AND CONDUITS FOR ALL TEL/DATA OUTLETS AND CAMERAS. OWNER TO PROVIDE AND INSTALL ALL DEVICES, PLATES, CABLES AND FINAL TERMINATIONS. ELECTRICAL CONTRACTOR TO COORDINATE EXACT REQUIREMENTS WITH OWNER.

ELECTRICAL NEW COMMUNICATION FLOOR PLAN - LEVEL 02





TTUHSC Preston Smith Library
Renovation - Level 01/02
3601 4th Street, STOP 7781
Lubbock, TX 79430-7781

REVISION HISTORY

1	ADDENDUM 02	10 APR 2025
REVISION	DESCRIPTION	DATE

PROFESSIONAL SEAL OF THE FLORIDA BOARD OF PROFESSIONAL ENGINEERS, INC.

ALLEN K. WARE

130686

LICENSED PROFESSIONAL ENGINEER

03/27/2025

ELECTRICAL - FIRE ALARM
PLAN - LEVEL 02

DRAWN BY	CHECKED BY
PROJECT NUMBER 24028	PROJECT ABBREVIATION TTUWSC-PSL-01-02
ORIGINAL ISSUE	DATE

ISSUE FOR CONSTRUCTION21 MAR 2025

E-402



ELECTRICAL NEW FIRE ALARM FLOOR PLAN - LEVEL 02






UHSC Fleet Simulation Lab

Renovation - Level 01/02

REVISION HISTORY

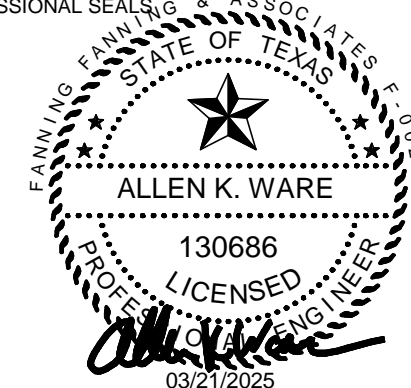[illegible]

ELECTRICAL SCHEDULES

DRAWN BY	CHECKED BY
PROJECT NUMBER 24028	PROJECT ABBREVIATION TTUHSC-PSL-01-02
ORIGINAL ISSUE	DATE
ISSUE FOR CONSTRUCTION	21 MAR 2025

Lighting Control Schedule

Energy Conservation Code: 2021 IECC


Space Lighting Details										Automatic Control Devices										Manual Control Devices					Automatic Operation	System Details					
Rm No	Rm. Name	Lighting Zones	Emergency Circuit	ON/OFF	BI-Level	Dim	Daylight	Time	TOD	Plug Load Control	IR	OT	US	IR	DT	US	OSWS-DIM	IR	CMOS	CMDS	Switch(es)	Dimming Step	10X	1X	Timer	Scenes & Raise/Lower	Description	Wired	Wired Digital	Wireless	Network
200	Communicating Space	3		x			x																				In0/OutP	x			
200A	Respit Room	1											x														In0/OutP	x			
200B	Respit Room	1		x									x														In0/OutP	x			
201	Open Study, Collaborate	8				x													x							x	In0/OutP	x			
201A	Huddle Room	1			x	x							x													x	In0/OutP	x			
201B	Huddle Room	1			x	x							x													x	In0/OutP	x			
201C	Huddle Room	1		x		x							x													x	In0/OutP	x			
201D	Computers/Printers	1				x													x							x	In0/OutP	x			
201E	Open Study, Collaborate	1					x													x						x	In0/OutP	x			
201F	Office Librarian	1			x								x													x	In0/OutP	x			
201G	Office Librarian	1			x		x						x													x	In0/OutP	x			
201H	Office Librarian	1			x	x							x													x	In0/OutP	x			
201J	Office Librarian	1				x	x						x													x	In0/OutP	x			
201K	Office Librarian	1			x	x							x													x	In0/OutP	x			
201L	Storage	1											x														In0/OutP	x			
202	Rare Books	2			x	x																					In0/OutP	x			
203A	Classroom A Academy	3				x																					In0/OutP	x			
203B	Classroom B Academy	3				x																					In0/OutP	x			
203C	Classroom Partition	3				x																					In0/OutP	x			
204	Open Office	1				x																					In0/OutP	x			
205	Title IX Core Team	1			x	x																					In0/OutP	x			
206	Lounge	1			x	x																					In0/OutP	x			
207	Office Academy	1			x	x							x														In0/OutP	x			
208	Office Academy	1			x	x								x													In0/OutP	x			
209	Office Academy	1				x							x														In0/OutP	x			
210	Office Academy	1			x	x							x														In0/OutP	x			
211	Collaborative Suite 01	1				x													x								In0/OutP	x			
211A	Office	1				x							x														In0/OutP	x			
211B	Office	1			x	x							x														In0/OutP	x			
211C	Office	1			x	x							x														In0/OutP	x			
211D	Office	1			x	x							x														In0/OutP	x			
211E	Office	1			x	x							x														In0/OutP	x			
211F	Office	1			x	x							x														In0/OutP	x			
211G	Huddle	1				x													x								In0/OutP	x			
211H	Copy	1			x	x							x														In0/OutP	x			
212	Collaborative Suite 02	1				x													x								In0/OutP	x			
212A	Office	1				x							x														In0/OutP	x			
212B	Office	1			x	x							x														In0/OutP	x			
212C	Office	1			x	x							x														In0/OutP	x			
212D	Office	1			x	x							x														In0/OutP	x			
212E	Office	1			x	x							x														In0/OutP	x			
212F	Office	1			x	x							x														In0/OutP	x			
212G	Huddle	1				x													x								In0/OutP	x			
212H	Copy	1			x	x							x														In0/OutP	x			
213	Collaborative Suite 03	1				x													x								In0/OutP	x			
213A	Office	1				x							x														In0/OutP	x			
213B	Office	1			x	x							x														In0/OutP	x			
213C	Office	1			x	x							x														In0/OutP	x			
213D	Office	1			x	x							x														In0/OutP	x			
213E	Office	1			x	x							x														In0/OutP	x			
213F	Office	1			x	x							x														In0/OutP	x			
213G	Huddle	1				x													x								In0/OutP	x			
213H	Copy	1			x	x							x														In0/OutP	x			
214	Global Health Library	1			x	x													x								In0/OutP	x			
214A	Global Health Office	1			x	x							x														In0/OutP	x			
214B	Global Health Office	1			x	x							x														In0/OutP	x			
214C	Hallway																														
215	Maker Space	1			x	x																					In0/OutP	x			
215A	Maker Space Office	1			x	x																					In0/OutP	x			
217	Workroom	1				x																					In0/OutP	x			
217A	Office	1			x	x																					In0/OutP	x			
217B	High Density Storage	1											x														In0/OutP	x			
217C	Model Storage	1																									In0/OutP	x			
217D	Patron Services Desk	1				x																					In0/OutP	x			
218	Office Librarian	1			x	x							x														In0/OutP	x			
220	Waiting																														
200A	Office Admin	1			x	x							x														In0/OutP	x			
220B	Office Admin	1				x							x														In0/OutP	x			
220C	Office Admin	1			x	x							x														In0/OutP	x			
220D	Exec Office Admin	1				x													x								In0/OutP	x			
220E	Office Business	1				x							x														In0/OutP	x			
220J	Conference Room	2				x													x								In0/OutP	x			
220K	Office TBD	1			x	x							x														In0/OutP	x			
220KA	Copy/File	1			x	x							x														In0/OutP	x			
220L	Library Administration	1			x	x													x								In0/OutP	x			
220G	Office Admin	1				x																					In0/OutP	x			
220H	Office Tech	1			x	x																					In0/OutP	x			
220F	Office Admin	1				x	x						x														In0/OutP	x			
200	Electrical	1			x																						In0/OutP	x			
2001	House Keeping	1																									In0/OutP	x			
2002	HSKP	1			x																										



TTUHSC Preston Smith Library
Renovation - Level 01/02
3601 4th Street, STOP 7781
Lubbock, TX 79430-7781

REVISION HISTORY

REVISION	DESCRIPTION	DATE
1	ADDENDUM 02	10 APR 2025

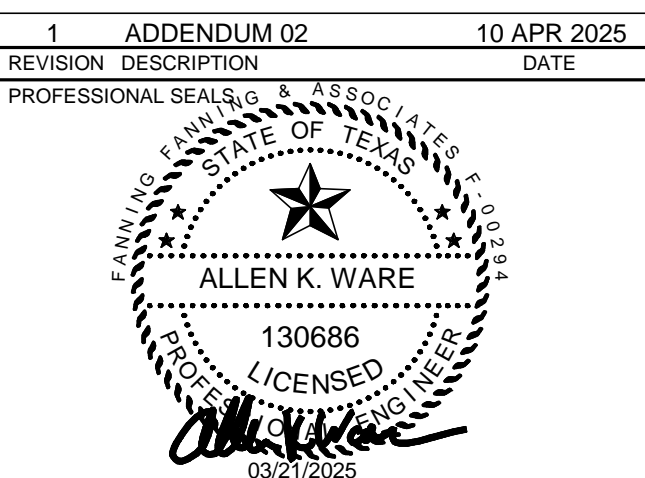

ELECTRICAL SCHEDULES

DRAWN BY	CHECKED BY
PROJECT NUMBER 24028	PROJECT ABBREVIATION TTUHSC-PSL-01-02
ORIGINAL ISSUE	DATE 21 MAR 2025
ISSUE FOR CONSTRUCTION	

E-603

SHEET NUMBER

EXISTING PANEL "RP-2B"											
CKT	BRKR	WIRE	SERVICES	Continuous VA Lights Load2	Non-Continuous VA Recept. Load4 Load5	SERVICES	WIRE	BRKR	CKT		
1	20/1	#12	SERVICE DESK 217D		360 1000	SERVICE DESK 217D	#12	20/1	2		
3	20/1	#12	SERVICE DESK 217D		360 1000	SERVICE DESK 217D	#12	20/1	4		
5	20/1	#12	WORK ROOM 217		360 1000	WORK ROOM 217	#12	20/1	6		
7	20/1	#12	WORK ROOM 217		540 1000	REFRIGERATOR	#12	20/1	8		
9	20/1	#12	COFFEE MAKER		360 1500	WORK ROOM 217	#12	20/1	10		
11	20/1	#12	MICROWAVE		900 1500	OFFICE 217A	#12	20/1	12		
13	20/1	#12	OFFICE 220A		900 1000	OFFICE 220C	#12	20/1	14		
15	20/1	#12	OFFICE 220B		900 1080	OFFICE 220D	#12	20/1	16		
17	20/1	#12	LIBRARY ADMIN 220L		360 1000	LIBRARY ADMIN 220L	#12	20/1	18		
19	20/1	#12	OFFICE 219		900 720	WAITING 220	#12	20/1	20		
21	20/1	#12	COMMUNICATING SPACE 200		540 540	COMMUNICATING SPACE 200	#12	20/1	22		
23	20/1	#12	HUDDLE ROOM 201A		540 720	HUDDLE ROOM 201B	#12	20/1	24		
25	20/1	#12	OPEN STUDY 201		720 1080	OPEN STUDY 201	#12	20/1	26		
27	20/1	#12	OPEN STUDY 201		540 720	OPEN STUDY 201	#12	20/1	28		
29	20/1	#12	OPEN STUDY 201		720 720	OPEN STUDY 201	#12	20/1	30		
31	20/1	#12	BRANDING WALL		1000 800	VAV BOXES	#12	20/1	32		
33	20/1	#12	BRANDING WALL		1000 800	VAV BOXES	#12	20/1	34		
35	20/1	#12	VAV BOXES		800 800	VAV BOXES	#12	20/1	36		
37	20/1	#12	VAV BOXES		800 800	VAV BOXES	#12	20/1	38		
39	20/1	#12	SMOKE DAMPERS		600 600	SMOKE DAMPERS	#12	20/1	40		
41	20/1	---	SPARE			SPARE	---	20/1	42		
43	20/1	---	SPARE			SPARE	---	20/1	44		
45	20/1	---	SPARE			SPARE	---	20/1	46		
47	20/1	---	SPARE			SPARE	---	20/1	48		
49	20/1	---	SPARE			SPARE	---	20/1	50		
51	20/1	---	SPARE			SPARE	---	20/1	52		
53	20/1	---	SPARE			SPARE	---	20/1	54		
55	20/1	---	SPARE			SPARE	---	20/1	56		
57	20/1	---	SPARE			SPARE	---	20/1	58		
59	20/1	---	SPARE			SPARE	---	20/1	60		
61	20/1	---	SPARE			SPARE	---	20/1	62		
63	20/1	---	SPARE			SPARE	---	20/1	64		
65	20/1	---	SPARE			SPARE	---	20/1	66		
67	20/1	---	SPARE			SPARE	---	20/1	68		
69	20/1	---	SPARE			SPARE	---	20/1	70		
71	20/1	---	SPARE			SPARE	---	20/1	72		
73	20/1	---	SPARE			SPARE	---	20/1	74		
75	20/1	---	SPARE			SPARE	---	20/1	76		
77	20/1	---	SPARE			SPARE	---	20/1	78		
79	20/1	---	SPARE			SPARE	---	20/1	80		
81	20/1	---	SPARE			SPARE	---	20/1	82		
83	20/1	---	SPARE			SPARE	---	20/1	84		
SERVICE: 120/208 Volt, 3 Phase, 4 Wire & Grnd MAINS: 150A-3P Main Circuit Breaker MOUNTING: Surface SCCR (RMS Sym) = 10K				16200	13200	PANEL CONNECTED VA	29400				
				16200	13200	PANEL DEMAND VA	29400				
				Nameplate Info Below (White Letters on Black)		PANEL SPARE VA	33923				
				EXISTING PANEL "RP-2B"		PANEL DESIGN VA	63523				
Notes: (1) Provide New Updated Type Written Circuit Directory				# Active	39	Phase Summary	Amps VA				
				# Spare	45	Phase A	94 11320				
				# Space		Phase B	78 9300				
				Av. Load/Ckt.		Phase C	73 8780				
				VA							
				Demand Fac tor	1						

THIS PANEL IS EXISTING
SCHEDULE FOR REFERENCE
ONLY

NEW PANEL "LP-2C"											
CKT	BRKR	WIRE	SERVICES	Continuous VA Lights Load2	Non-Continuous VA Load3 Load4 Load5	SERVICES	WIRE	BRKR	CKT		
1	XX	---	---	150	15000	EXIT LIGHTS	#12	20/1	2		
3	70/3	#4	DTT "T-2C"	3210	15000	LIGHTING	#12	20/1	4		
5	XX	#4	---	3447	15000	LIGHTING	#12	20/1	6		
7	20/1	---	SPARE			SPARE	---	20/1	8		
9	20/1	---	SPARE			SPARE	---	20/1	10		
11	20/1	---	SPARE			SPARE	---	20/1	12		
13	---	---	SPACE ONLY			SPACE ONLY	---	---	14		
15	---	---	SPACE ONLY			SPACE ONLY	---	---	16		
17	---	---	SPACE ONLY			SPACE ONLY	---	---	18		
19	---	---	SPACE ONLY			SPACE ONLY	---	---	20		
21	---	---	SPACE ONLY			SPACE ONLY	---	---	22		
23	---	---	SPACE ONLY			SPACE ONLY	---	---	24		
25	---	---	SPACE ONLY			SPACE ONLY	---	---	26		
27	---	---	SPACE ONLY			SPACE ONLY	---	---	28		
29	---	---	SPACE ONLY			SPACE ONLY	---	---	30		
SERVICE: 277/480 Volt, 3 Phase, 4 Wire & Grnd MAINS: 100A-3P Main Circuit Breaker MOUNTING: Surface SCCR (RMS Sym) = 25K				6807	6807	PANEL CONNECTED VA	51807				
				6807	6807	PANEL DEMAND VA	51807				
				Nameplate Info Below (White Letters on Black)		PANEL CALCULATED VA	53509				
				NEW PANEL "LP-2C"		PANEL SPARE VA	15000				
Notes: (1) Copper Bussing (2) Hinged Door (3) Custom Laminated Plastic Nameplate (4) Typed Circuit Directory (5) 100% Neutral (6) NEMA 1 Enclosure (7) Arc-Flash Warning Label (NEC 110.16)				# Active	6	Phase Summary	Amps VA				
				# Spare	6	Phase A	55 15150				
				# Space	18	Phase B	66 18210				
				Av. Load/Ckt.		Phase C	67 18447				
				VA							

EXISTING PANEL "LP-2B"

CKT	BRKR	WIRE	SERVICES	Continuous VA Lights Load2	Non-Continuous VA Load3 Load4 Load5	SERVICES	WIRE	BRKR	CKT		
1	XX	---	---	150	15000	EXIT LIGHTS	#12	20/1	2		
3	70/3	---	DDT RP-2B	2780	15000	LIGHTING	#12	20/1	4		
5	XX	---	---	2754	15000	LIGHTING	#12	20/1	6		
7	20/1	---	SPARE	2680		LIGHTING	#12	20/1	8		
9	20/1	---	SPARE			SPARE	---	20/1	10		
11	20/1	---	SPARE			SPARE	---	20/1	12		
13	20/1	---	SPARE			SPARE	---	20/1	14		
15	20/1	---	SPARE			SPARE	---	20/1	16		
17	20/1	---	SPARE			SPARE	---	20/1	18		
19	20/1	---	SPARE			SPARE	---	20/1	20		
21	20/1	---	SPARE			SPARE	---	20/1	22		
23	20/1	---	SPACE ONLY			SPACE ONLY	---	20/1	24		
25	20/1	---	SPACE ONLY			SPACE ONLY	---	20/1	26		
27	20/1	---	SPACE ONLY			SPACE ONLY	---	20/1	28		
29	20/1	---	SPACE ONLY			SPACE ONLY	---	20/1	30		
31	20/1	---	SPACE ONLY			SPACE ONLY	---	20/1	32		
33	20/1	---	SPACE ONLY			SPACE ONLY	---	20/1	34		
35	20/1	---	SPACE ONLY			SPACE ONLY	---	20/1	36		
SERVICE: 277/480 Volt, 3 Phase, 4 Wire & Grnd MAINS: 100A MLO MOUNTING: Surface SCCR (RMS Sym) = 25K				8364	45000	PANEL CONNECTED VA	53364				
				8364	45000	PANEL DEMAND VA	53364				
				Nameplate Info Below (White Letters on Black)		PANEL CALCULATED VA	55455				
				EXISTING PANEL "LP-2B"		PANEL SPARE VA	15000				
Notes: (1) Provide New Updated Type Written Circuit Directory				# Active	7	Phase Summary	Amps VA				
				# Spare	15	Phase A	64 17830				
				# Space	14	Phase B	64 17780				
				Av. Load/Ckt.		Phase C	64 17754				
				VA							

THIS PANEL IS EXISTING
SCHEDULE FOR REFERENCE
ONLY

NEW PANEL "RP-2C"												
CKT	CKT BRKR	WIRE	#12	SERVES	Continuous VA		Non-Continuous VA		SERVES	WIRE	CKT BRKR	CKT
					Lights	Load2	Recept.	Load4				
1	20/1	#12		RECEIPT			540					
							540		RESPIRIT ROOM 200A	#12	20/1	2
3	20/1	#12		RESPIRIT ROOM 200A			540					
							540	1000	RESPIRIT ROOM 200B	#12	20/1	4
5	20/1	#12		RESPIRIT ROOM 200B			540					
							360		2R03, 2R04	#12	20/1	6
7	20/1	#12		CARD READERS				500				
							540		RARE BOOKS 202	#12	20/1	8
9	20/1	#12		RARE BOOKS 202			540					
							720		2M02, 2H04	#12	20/1	10
11	20/1	#12		CLASSROOM 203A			720					
							720		CLASSROOM 203B	#12	20/1	12
13	20/1	#12		CLASSROOM 203A			540					
							540		CLASSROOM 203A	#12	20/1	14
15	20/1	#12		CLASSROOM 203A			540					
							540		CLASSROOM 203B	#12	20/1	16
17	20/1	#12		INNOVATIVE			540					
				CLASSROOM 203B			540		CLASSROOM 203B	#12	20/1	18
19	20/1	#12		OPEN OFFICE 204			540					
							540		OPEN OFFICE 204	#12	20/1	20
21	20/1	#12		OPEN OFFICE 204			360					
							540		OPEN OFFICE 204	#12	20/1	22
23	20/1	#12		OPEN OFFICE 204			360					
							540		OPEN OFFICE 204	#12	20/1	24
25	20/1	#12		OPEN OFFICE 204			540					
								1000	LOUNGE 09	#12	20/1	26
27	20/1	#12		Office 210			900					
								1000	LOUNGE 209	#12	20/1	28
29	20/1	#12		LOUNGE 209				1000				
							720		LOUNGE 209	#12	20/1	30
31	20/1	#12		OFFICE 208			900					
							900		OFFICE 207	#12	20/1	32
33	20/1	#12		OFFICE 206			900					
							900		OFFICE 205	#12	20/1	34
35	20/1	#12		HALLWAY 2H04			720					
							900		HUDDLE 212G	#12	20/1	36
37	20/1	#12		COPY 212H				1000				
								1000	COPY 212H	#12	20/1	38
39	20/1	#12		OFFICE 212F			900					
							900		OFFICE 212D	#12	20/1	40
41	20/1	#12		OFFICE 212B			900					
							900		OFFICE 212A	#12	20/1	42
43	20/1	#12		OFFICE 212C			900					
							900		OFFICE 212E	#12	20/1	44
45	20/1	#12		OFFICE 215A			900					
							900		OFFICE 214B	#12	20/1	46
47	20/1	#12		OFFICE 214A			900					
							540		HALLWAY 214C	#12	20/1	48
49	20/1	#12		HUDDLE ROOM			540		MAKER SPACE	#12	20/1	50
				201C			720		215			
51	20/1	#12		HEALTH LIBRARY			360		MAKER SPACE	#12	20/1	52
				214				1000	215			
53	20/1	#12		MAKER SPACE			1000		MAKER SPACE	#12	20/1	54
				215			1000		215			
55	20/1	#12		MAKER SPACE			1000		MAKER SPACE	#12	20/1	56
				215			1000		215			
57	20/1	#12		MAKER SPACE			1000		MAKER SPACE	#12	20/1	58
				215			1000		215			
59	20/1	#12		OPEN STUDY 201			540		ELECTRONIC	#12	20/1	60
								500	SCHEDULES			
61	20/1	#12		BRANDING WALL				500				
									BOOK CASE LIGHTS	#12	20/1	62
63	20/1	#12		OPEN OFFICE 204	1080			1000				
				FLOOR BOX					Spare	---	20/1	64
65	20/1	---		Spare					Spare	---	20/1	66
									Spare	---	20/1	68
69	20/1	---		Spare					Spare	---	20/1	70
									Spare	---	20/1	72
71	20/1	---		Spare					Spare Only	---	20/1	74
73	20/1	---		Space Only								
75	20/1	---		Space Only					Space Only	---	20/1	76
77	20/1	---		Space Only					Space Only	---	20/1	78
79	20/1	---		Space Only					Space Only	---	20/1	80
81	20/1	---		Space Only					Space Only	---	20/1	82
83	20/1	---		Space Only					Space Only	---	20/1	84
					1080		29520	16500	PANEL CONNECTED VA			47100
					1080		19760	16500	PANEL DEMAND VA			37340
									PANEL CALCULATED VA			37610
									PANEL SPARE VA			6729
									PANEL DESIGN VA			144339
									PANEL CONN. AMPS / PHASE			131
									PANEL DEMAND AMPS / PHASE			104
									PANEL DESIGN AMPS / PHASE			123
Notes:												
(1) Copper Bussing												
(2) Hinged Door												
(3) Custom Laminated Plastic Nameplate												
(4) Typed Circuit Directory												
(5) 100% Neutral												
(6) Arc-flash Warning Label (NEC 110.16)												
# Active 63												
# Spare 9												
# Space 12												
Av. Load/Ckt.												
VA 748												
Amps 6												
STATISTICS												
Phase Summary												
Phase A 131 16280												
Phase B 131 46440												
Phase C 120 14400												